




1+50

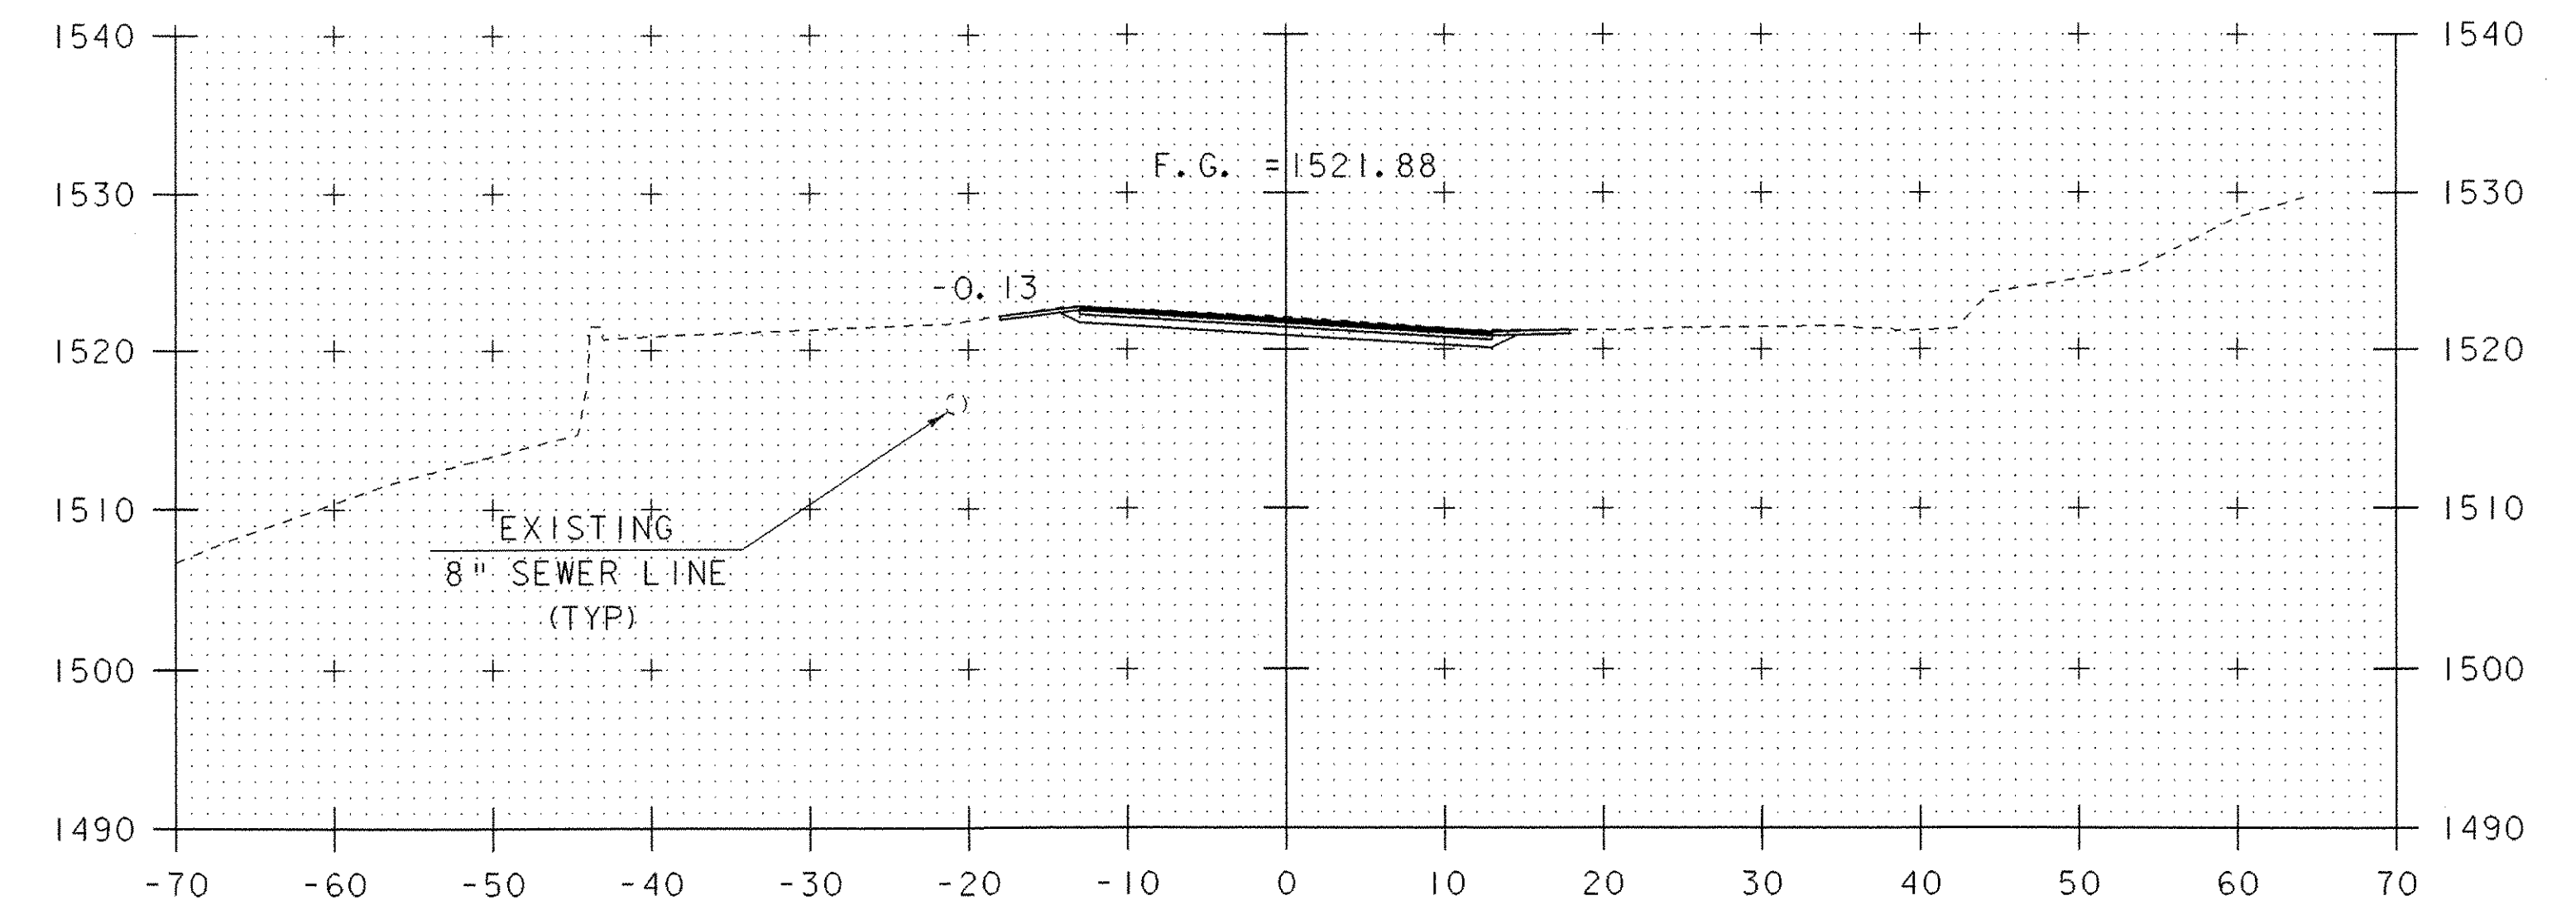


2+50

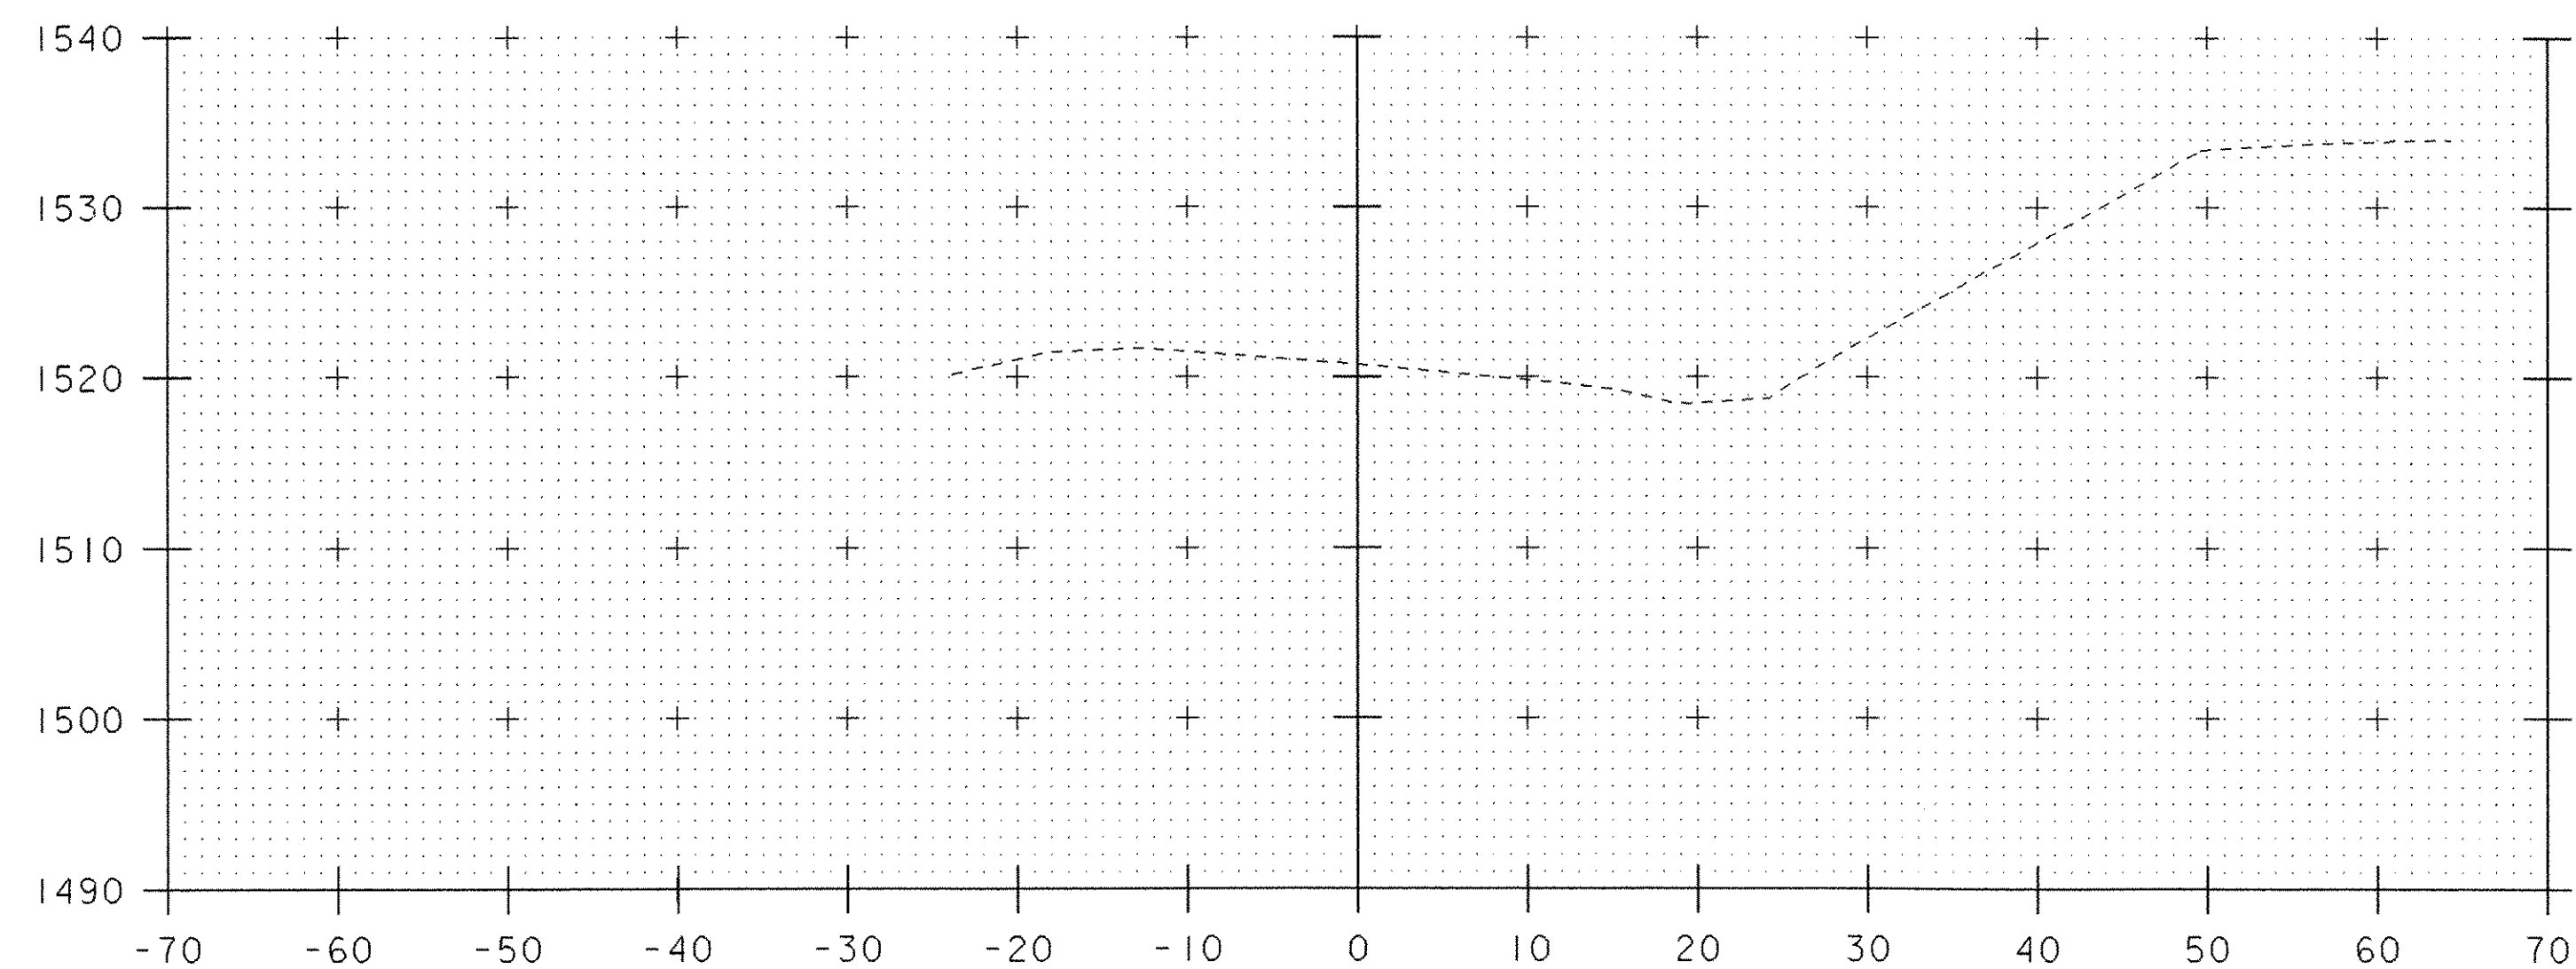

1+00

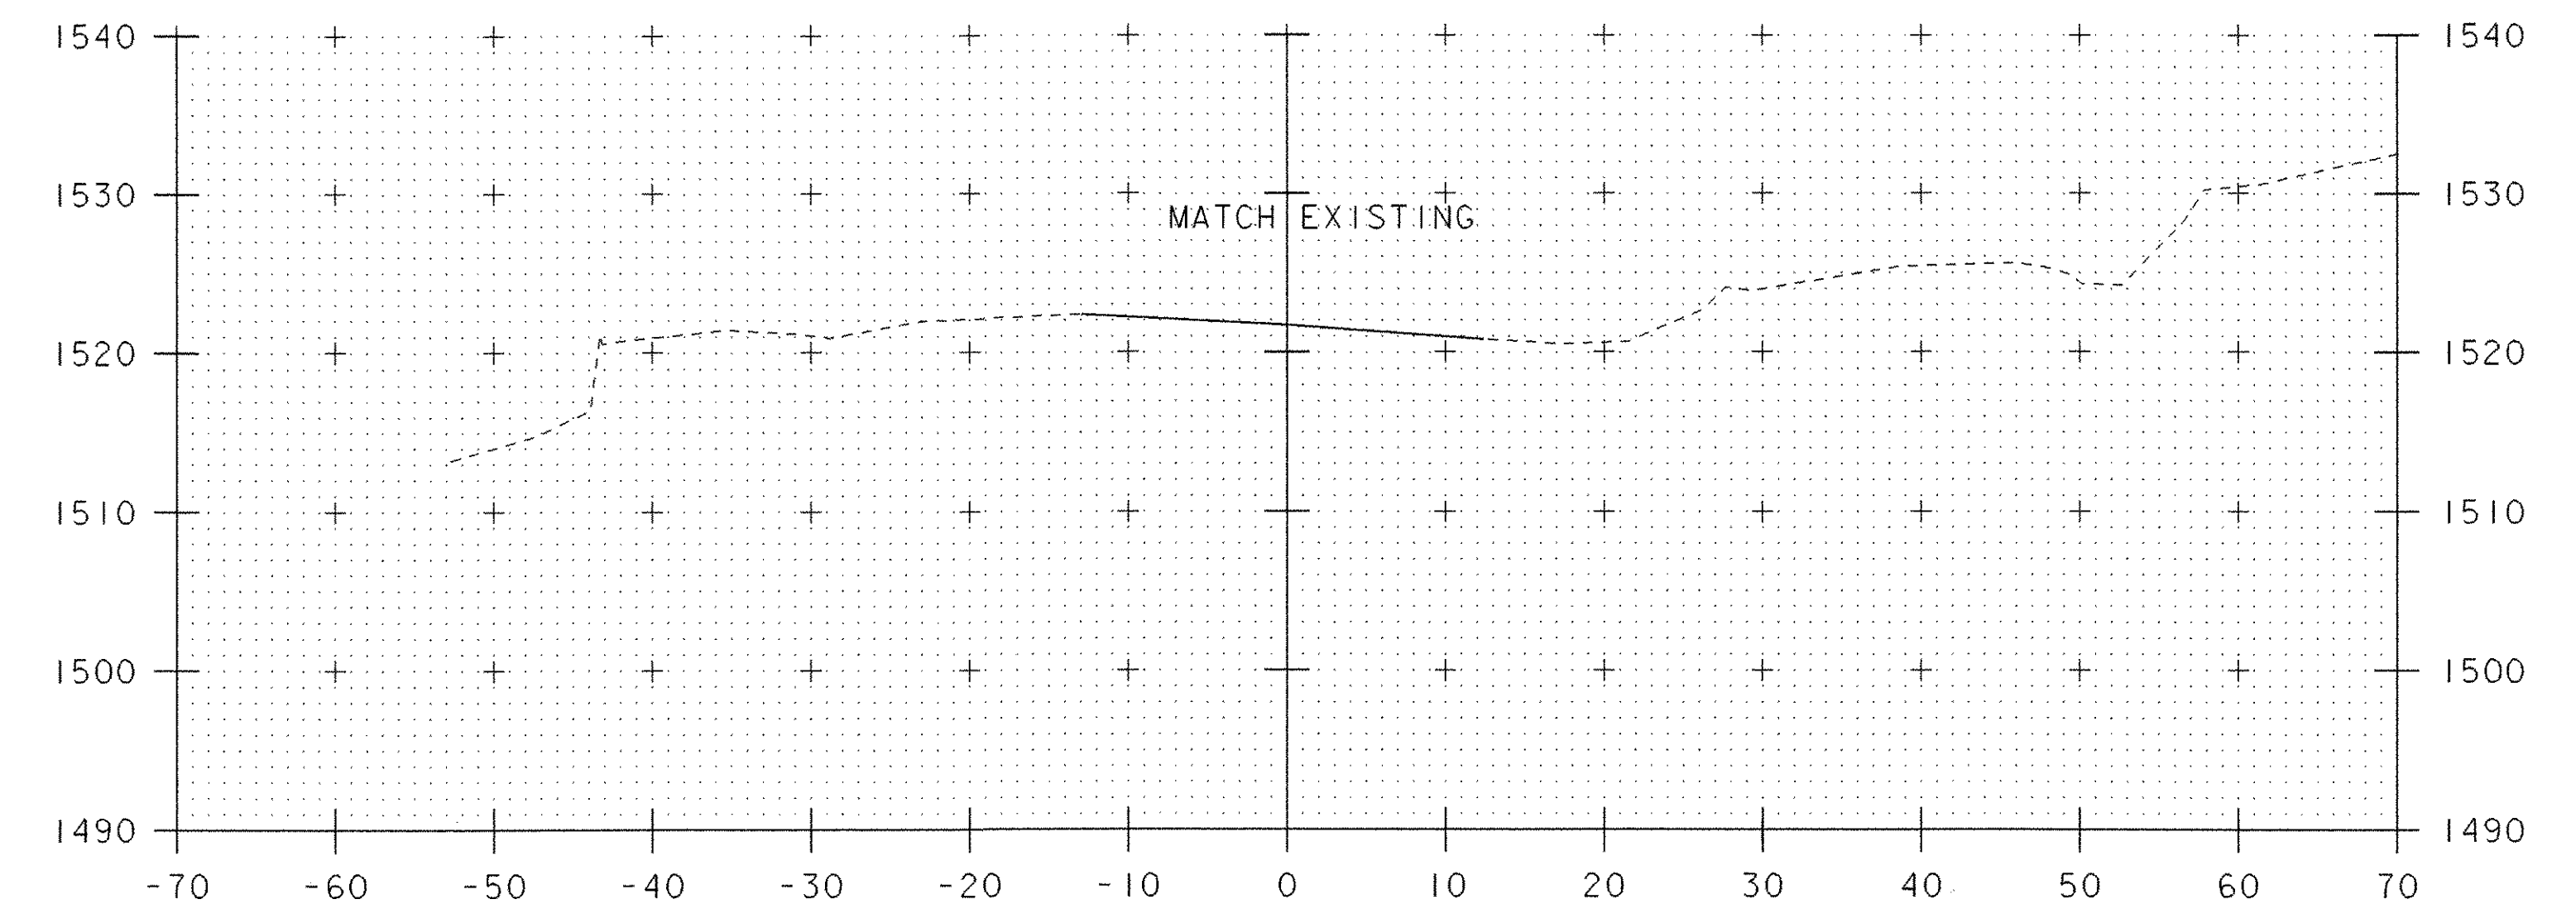

2+00
BEGIN APPROACH

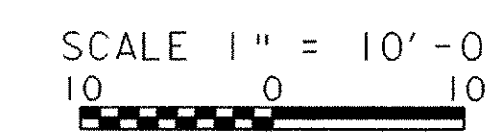

PROJECT: WHITINGHAM	PROJECT NO.: ST CULV (6)
DESIGN FILE NAME: s05c128/structures/s05c128xs.dgn	PLOT DATE: 08-MAR-2006
IPARM FILE NAME: s05c128m11.i	DRAWN BY: E.L.RUSTAY
DESIGNED BY: E.L.RUSTAY	CHECKED BY: M.GAGULIC
SQUAD LEADER: C.P.WILLIAMS	SHEET: 19 OF 34
MAINLINE STA 1+00 - STA 2+50	