




5+25

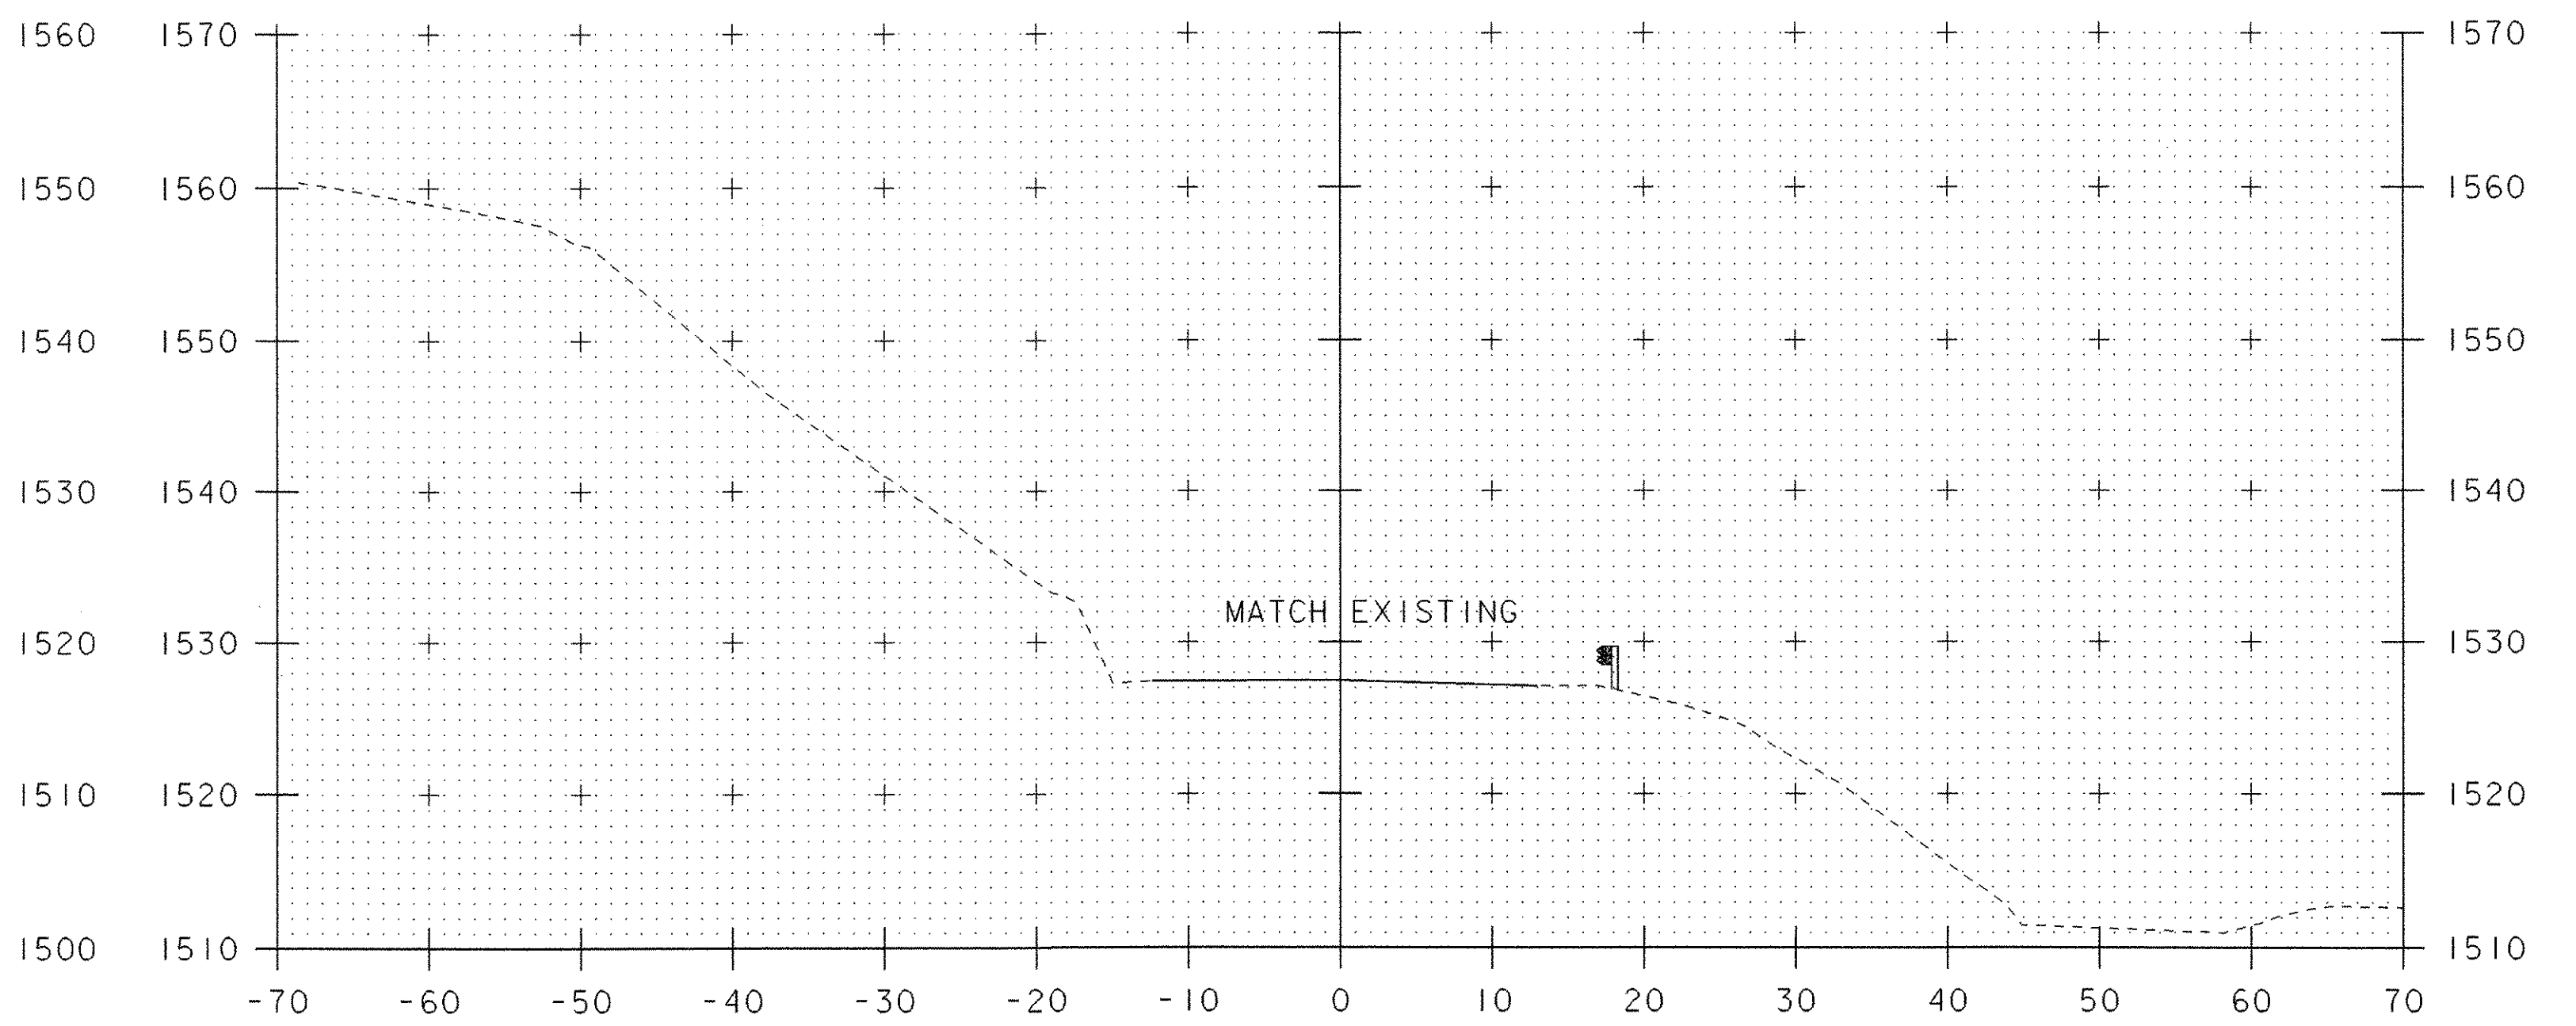

5+75
END APPROACH

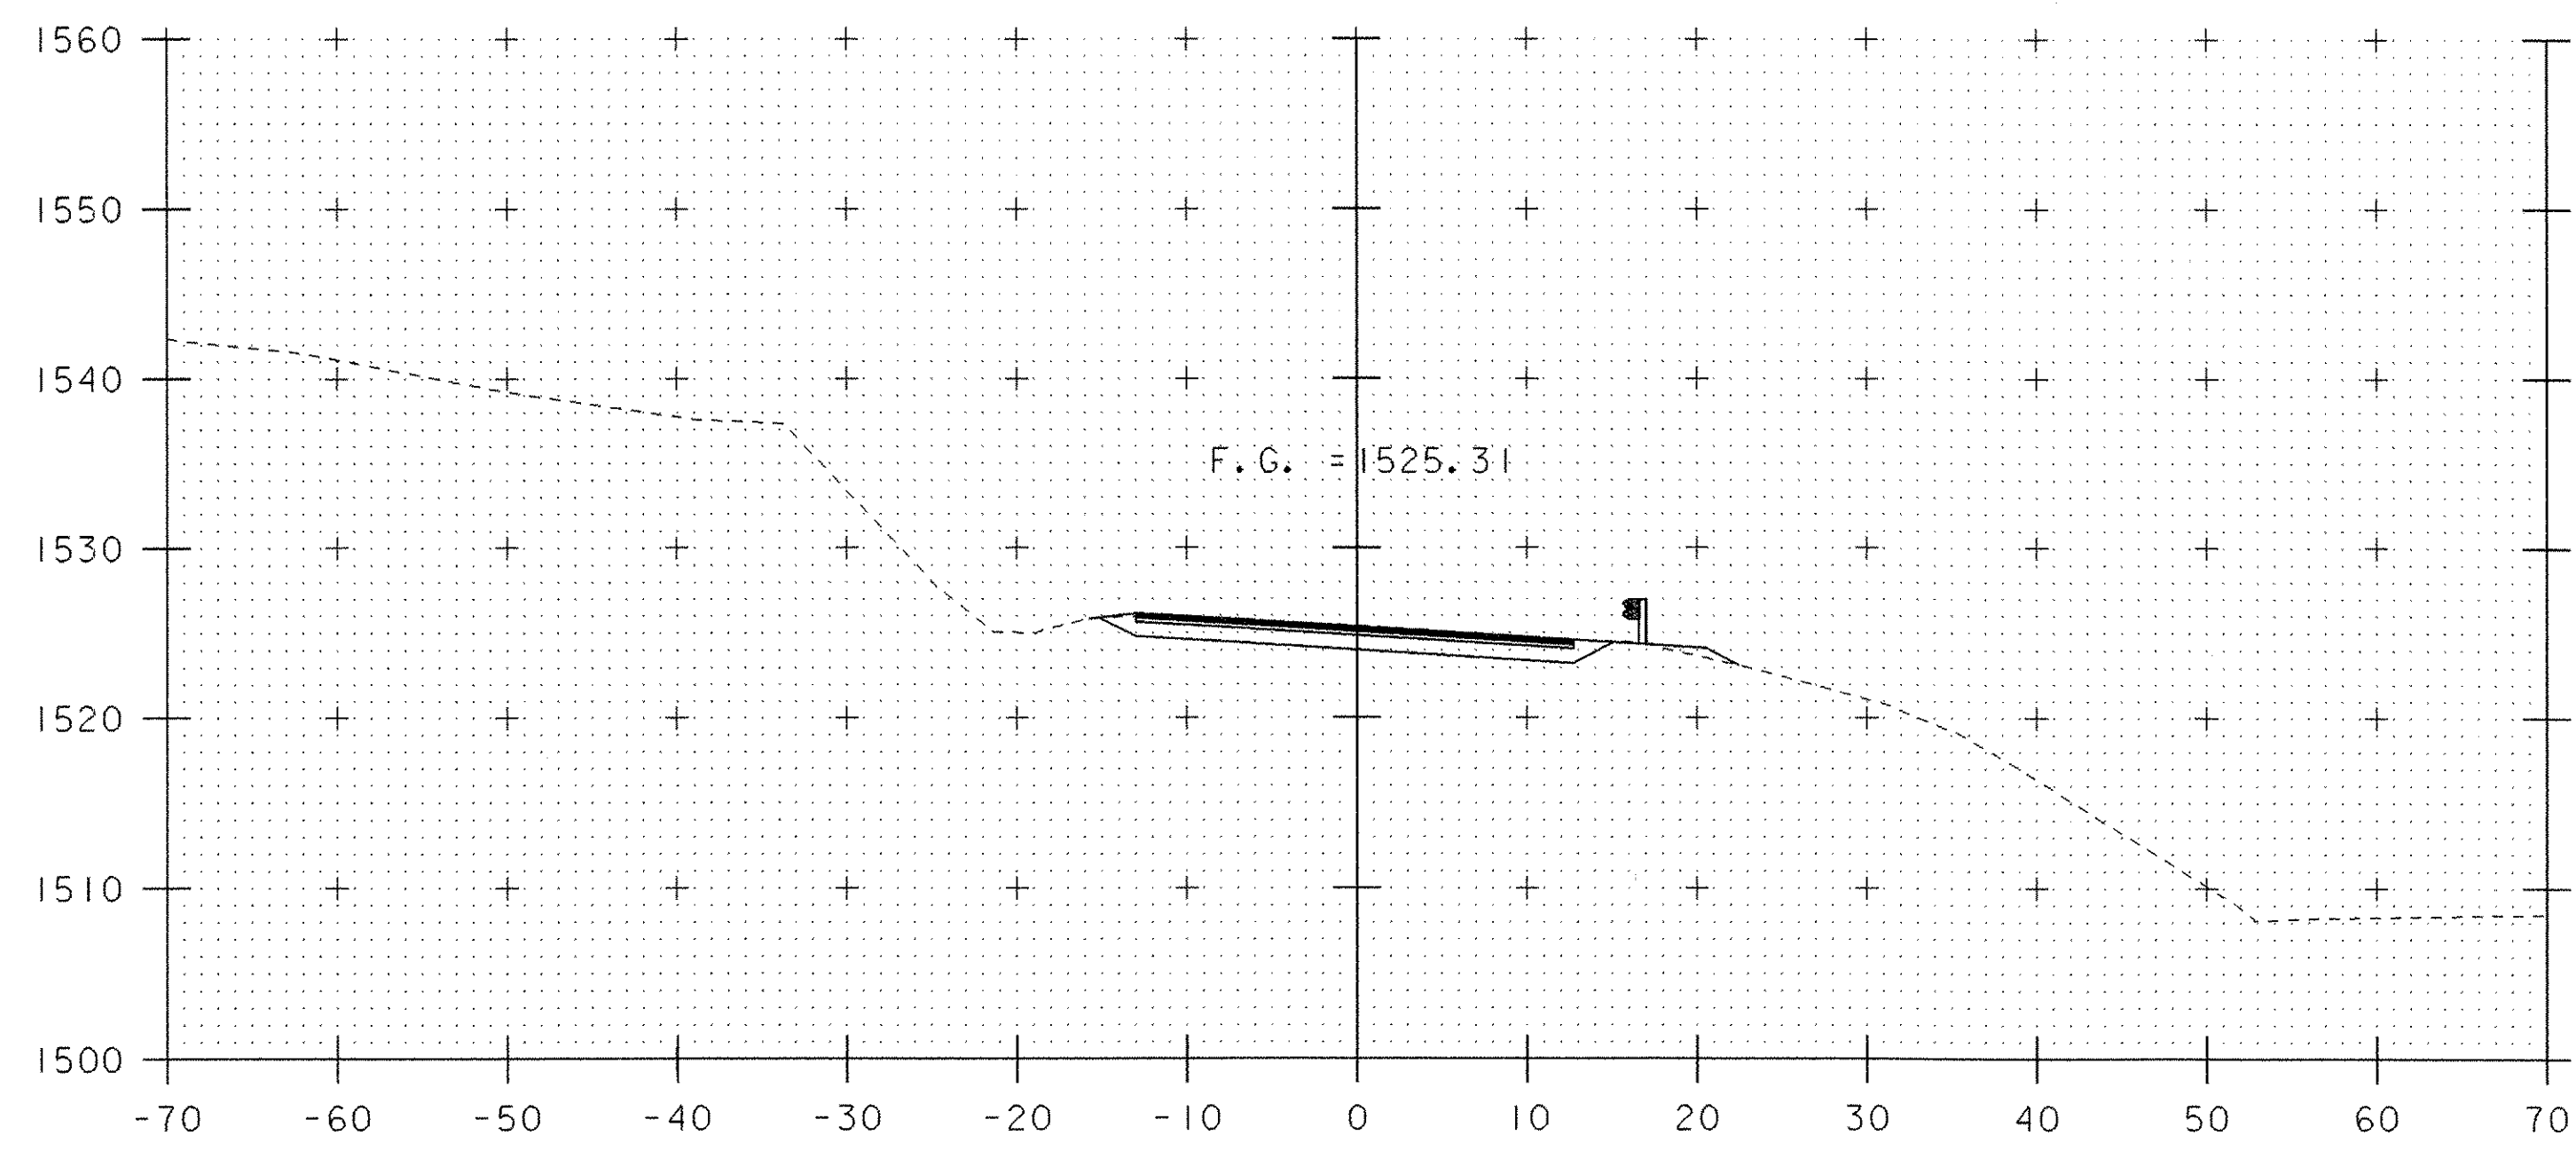

5+00

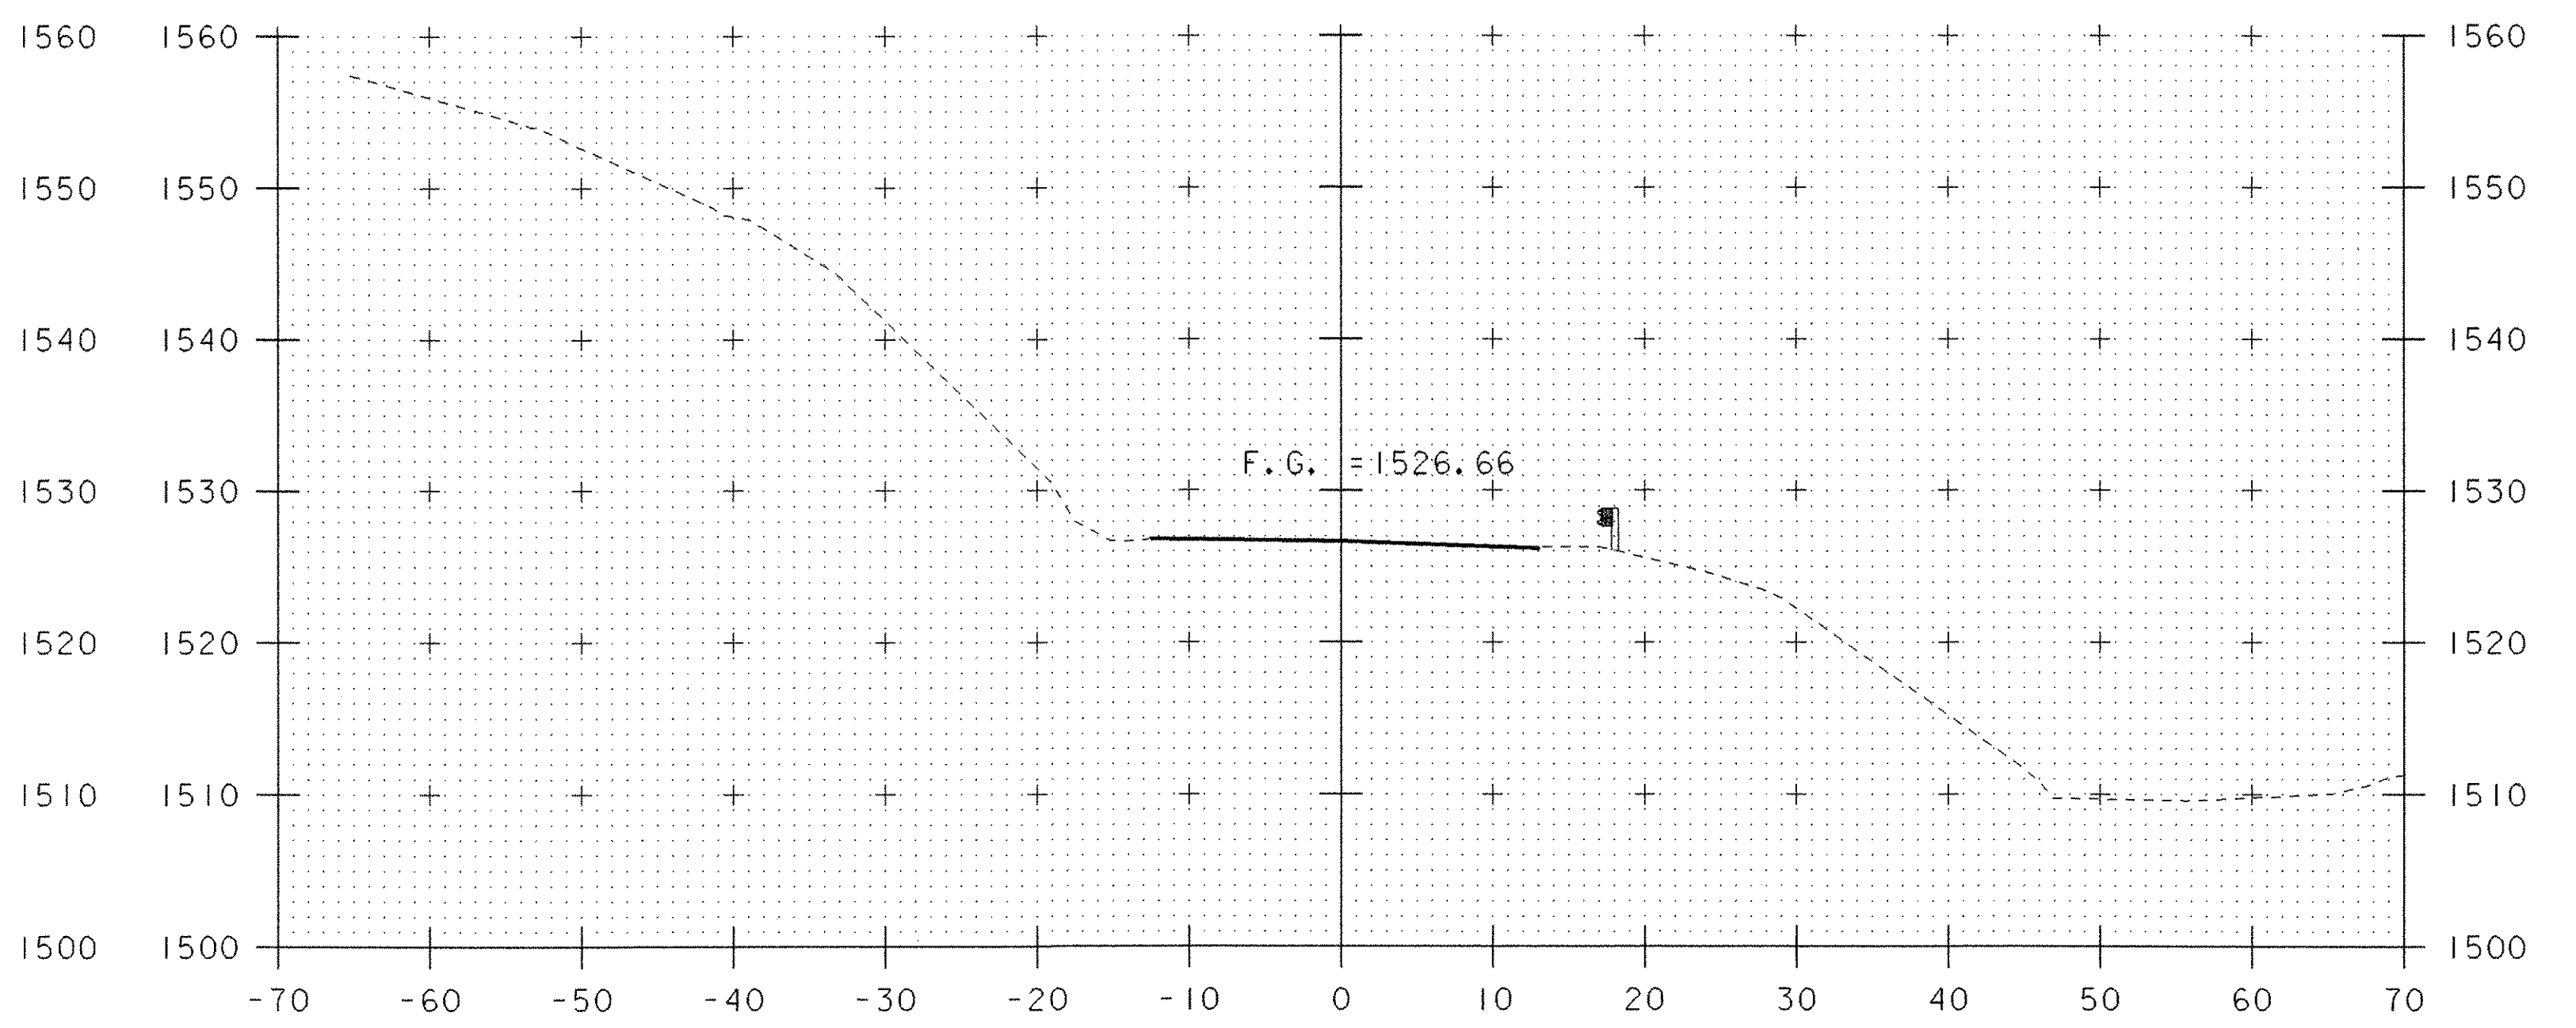

5+50

SCALE 1" = 10'-0"
10 0 10

PROJECT: WHITINGHAM	PROJECT NO.: ST CULV (6)
DESIGN FILE NAME: 05c128/structures/s05c128xs.dgn	PLOT DATE: 08-MAR-2006
IPARM FILE NAME: s05c128m13.i	DRAWN BY: E.L.RUSTAY
DESIGNED BY: E.L.RUSTAY	CHECKED BY: M.GAGULIC
SQUAD LEADER: C.P.WILLIAMS	SHEET: 21 OF 34
MAINLINE STA 5+00 - STA 6+50	