



13+25

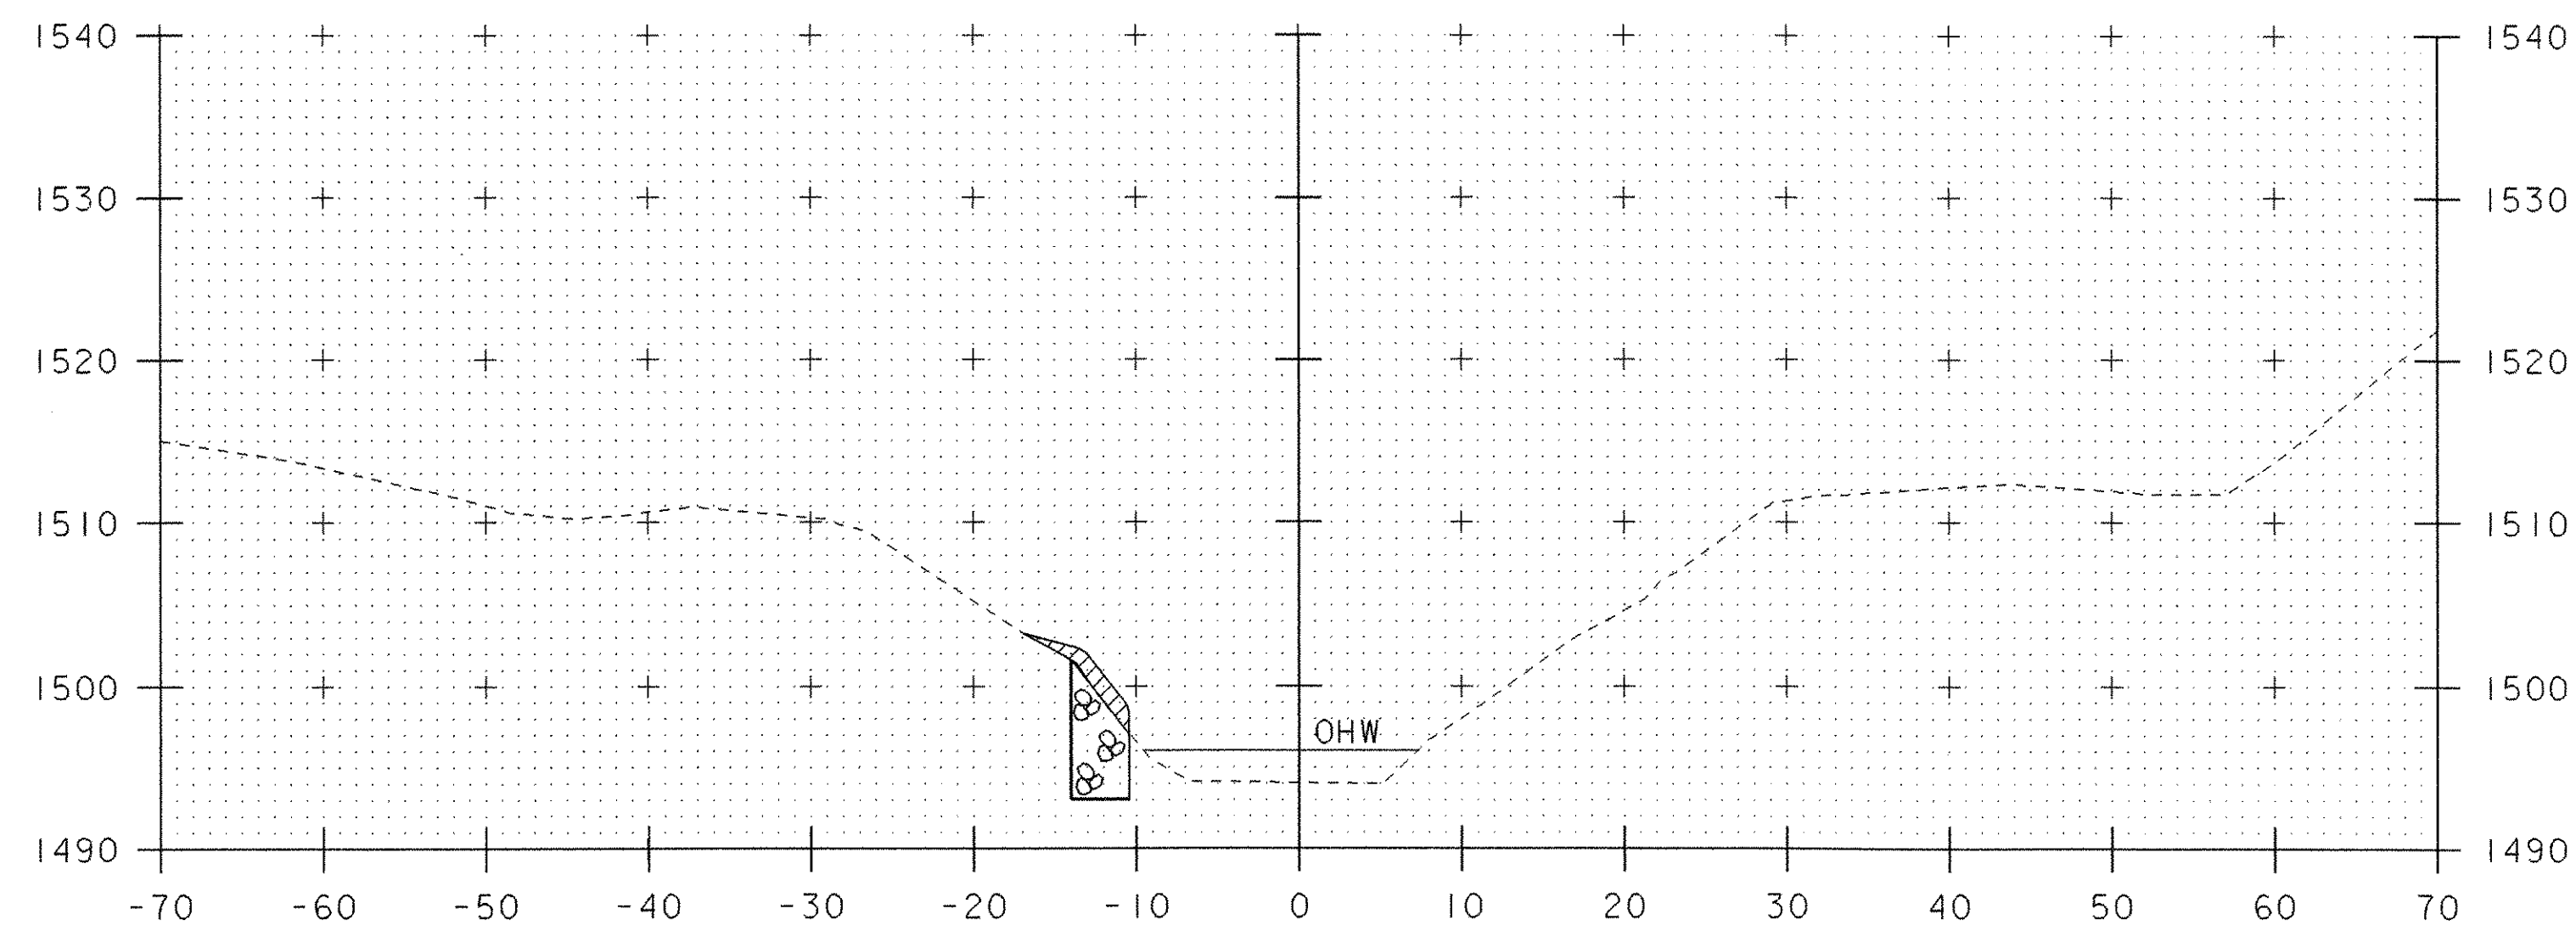

13+00

STA 13+00.00 LT  
 END STONE FILL TYPE IV  
 END GEOTEXTILE UNDER STONE FILL  
 END GRUBBING MATERIAL  
 END UNCLASSIFIED CHANNEL EXCAVATION

STA 12+98.00 RT  
 END STONE FILL TYPE IV  
 END GEOTEXTILE UNDER STONE FILL  
 END GRUBBING MATERIAL  
 END UNCLASSIFIED CHANNEL EXCAVATION

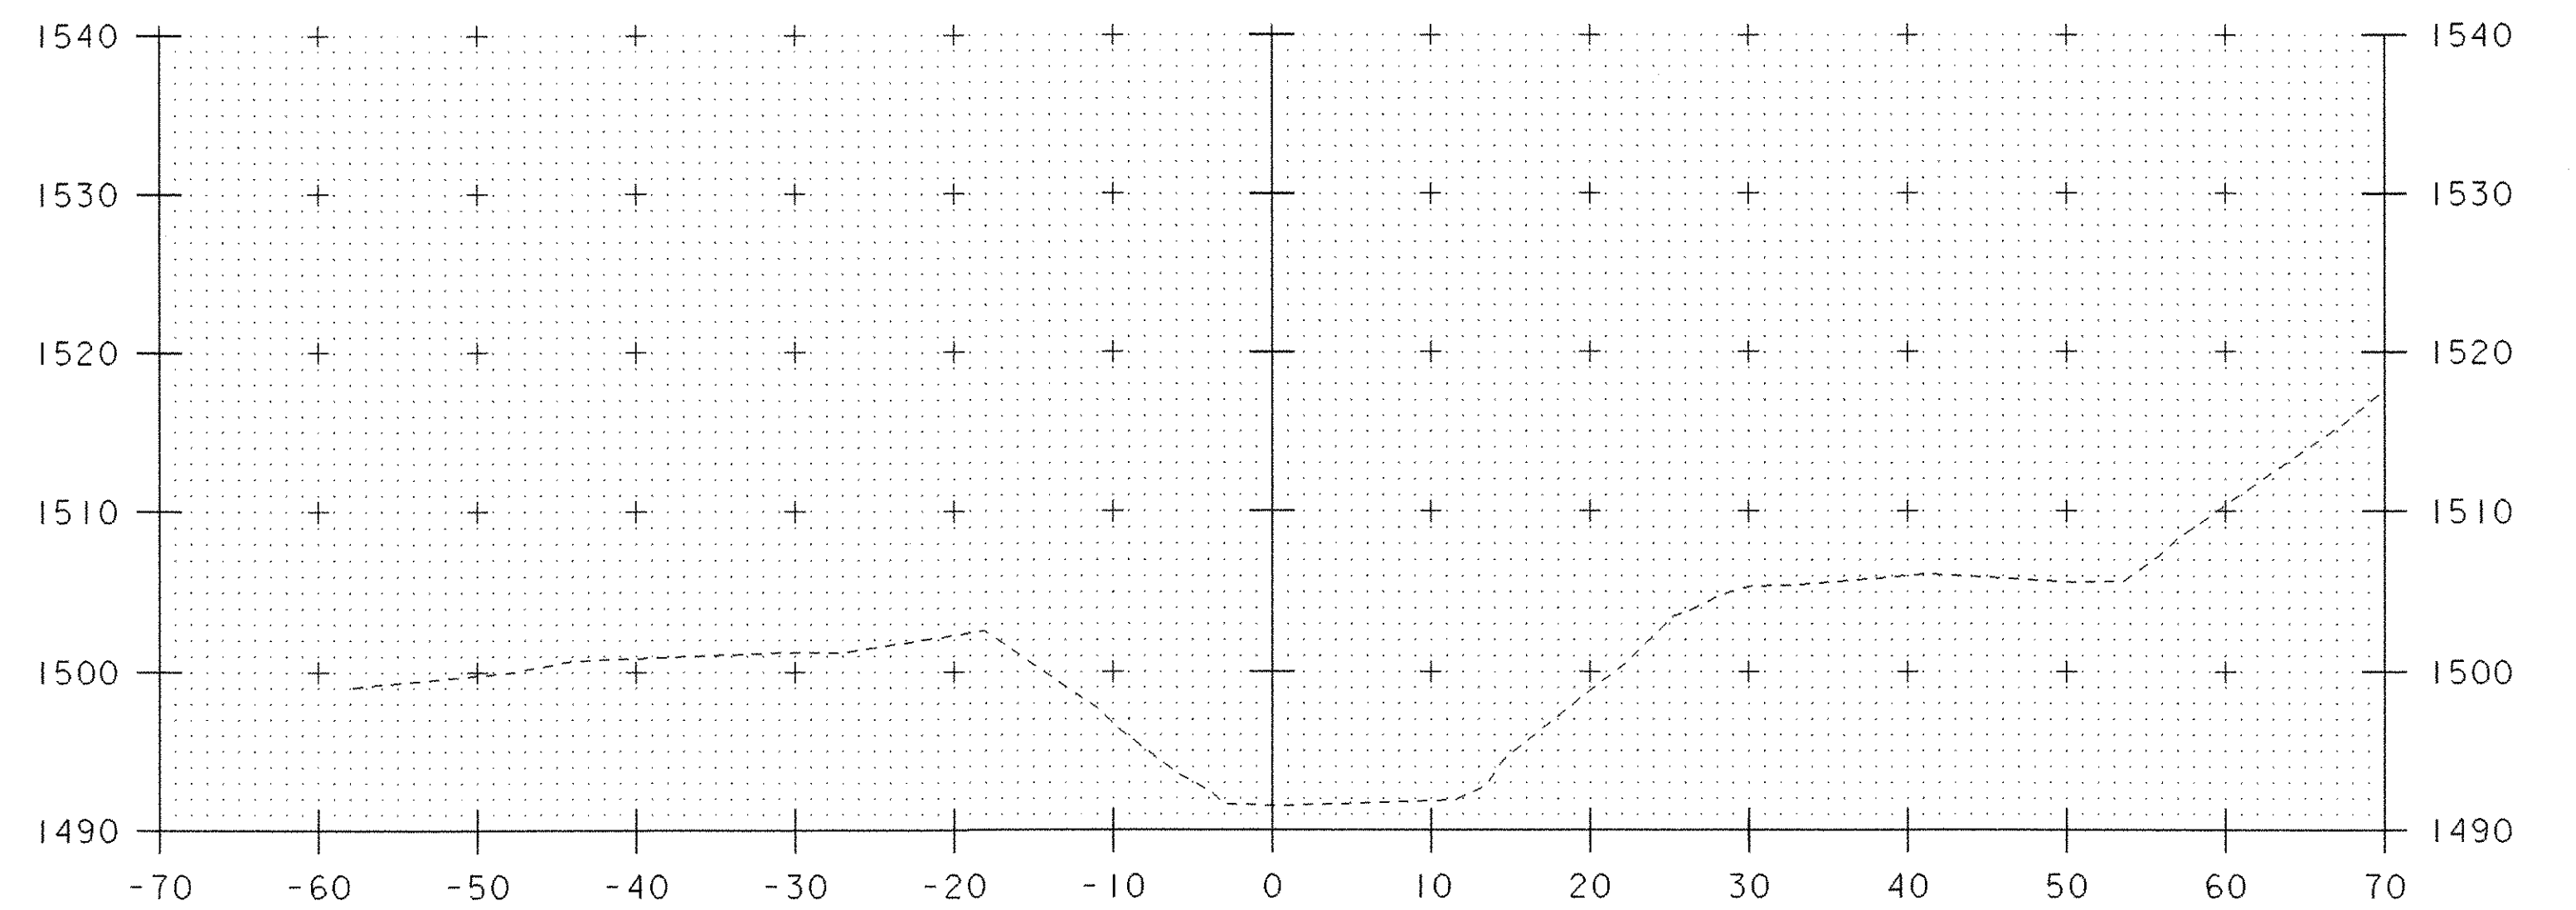

13+50

SCALE 1" = 10'-0"  
 10 0 10

PROJECT: WHITINGHAM	PROJECT NO.: ST CULV (6)
DESIGN FILE NAME: 05c128/structures/s05c128xs.dgn	PLOT DATE: 08-MAR-2006
IPARM FILE NAME: s05c128ch4.i	DRAWN BY: E.L.RUSTAY
DESIGNED BY: E.L.RUSTAY	CHECKED BY: M.GAGULIC
SQUAD LEADER: C.P.WILLIAMS	SHEET: 25 OF 34
CHANNEL STA 13+00 - STA 13+50	