



11+05

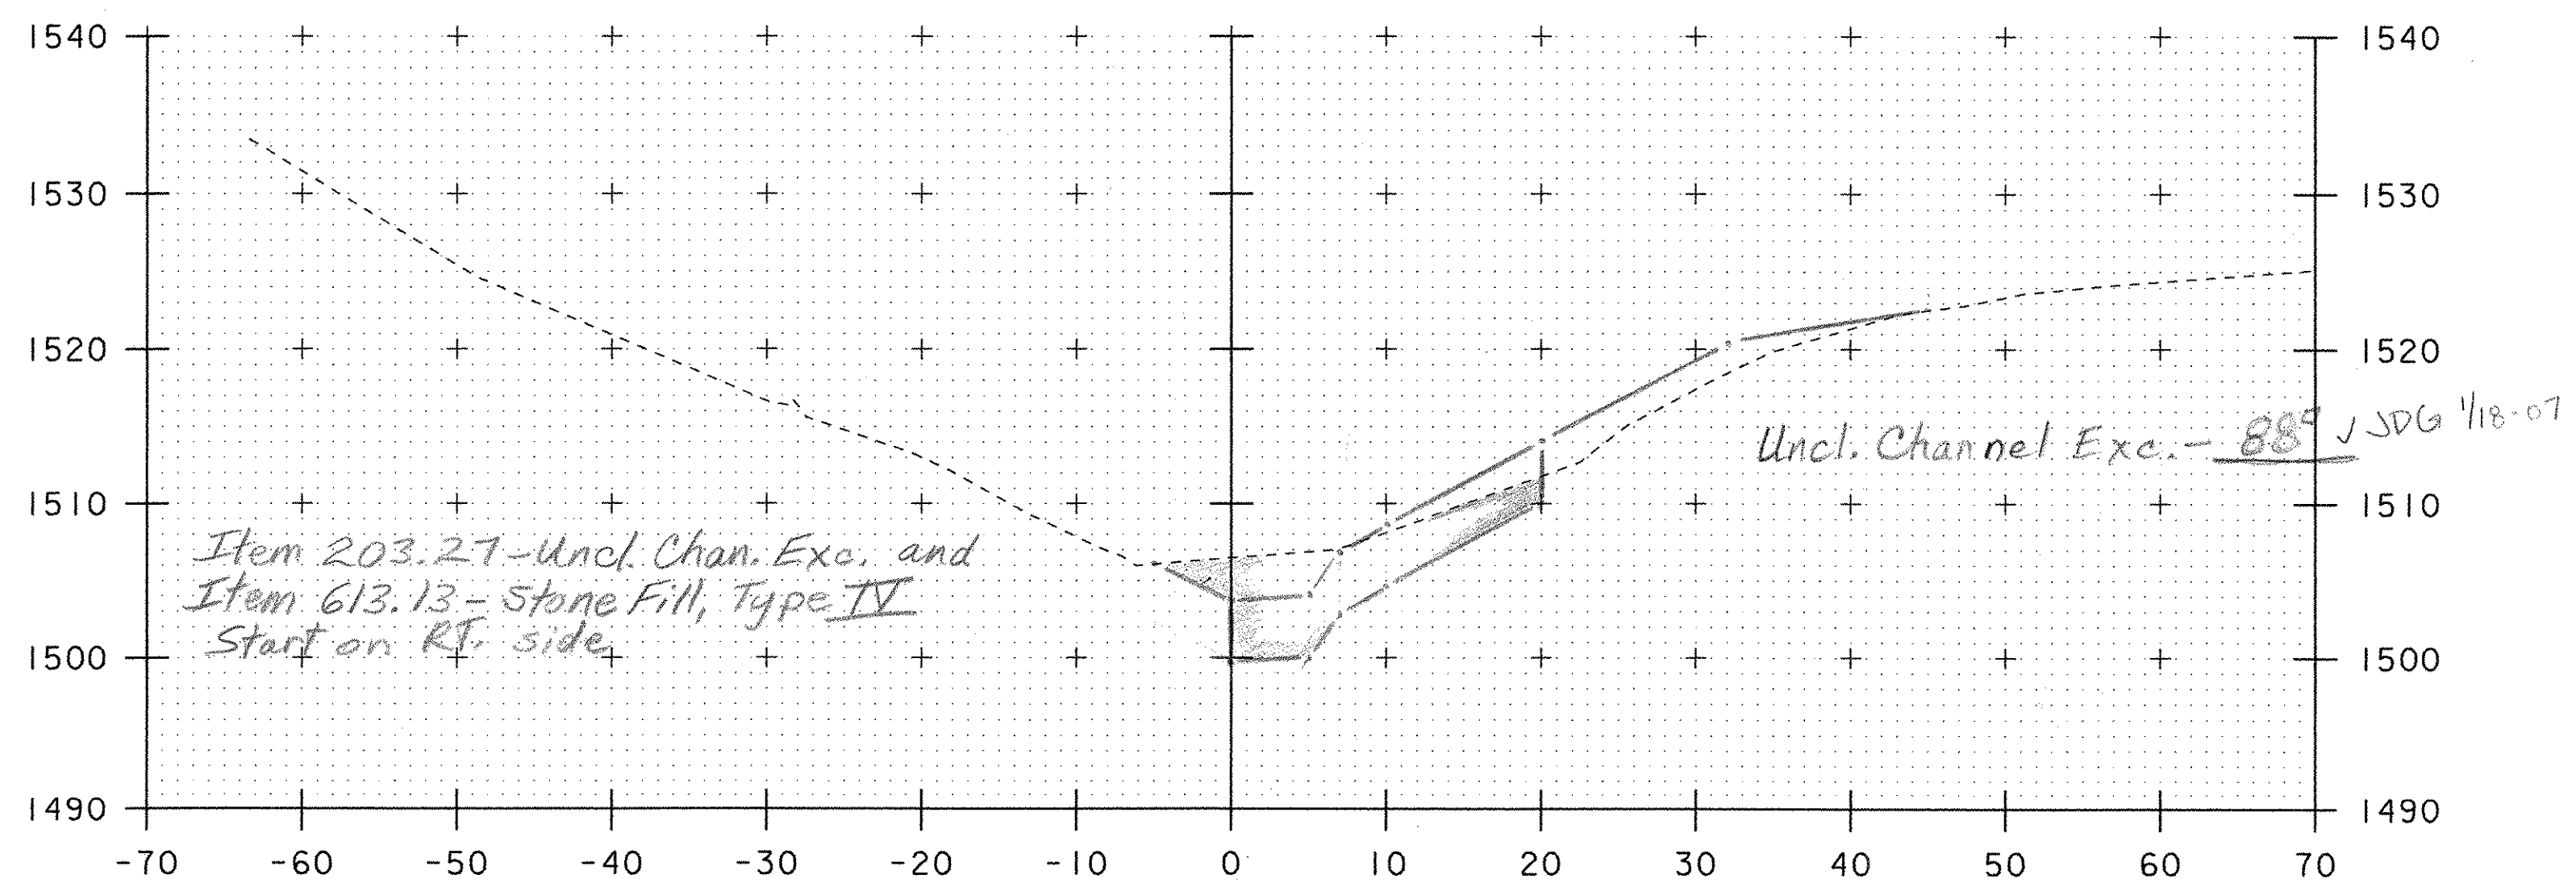

11+03

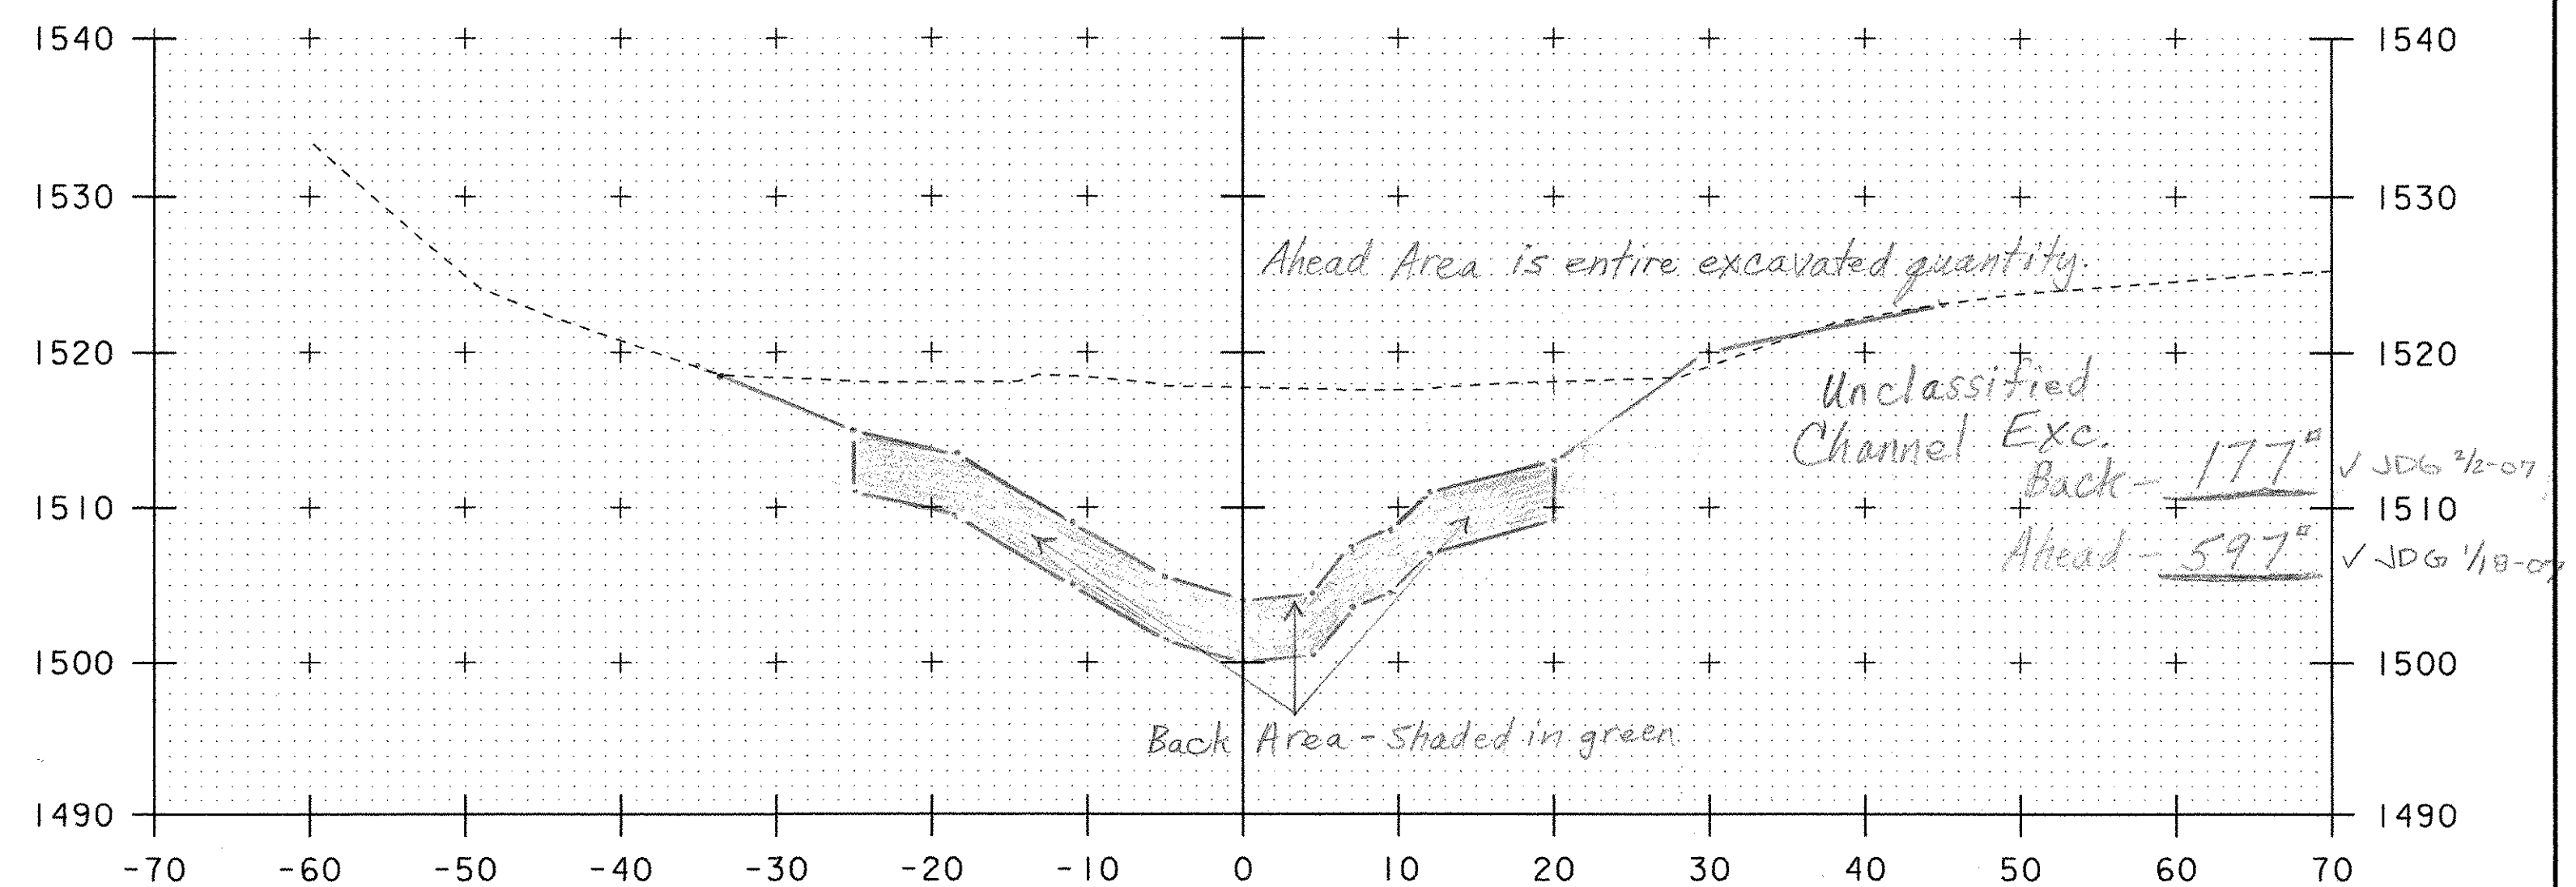

11+12

BACK & AHEAD STATIONS

M.W.H. plan. 1/3/07

Scale 1"=10'-0"

PROJECT: WHITINGHAM	PROJECT NO. : ST CULV (6)
DESIGN FILE NAME: 05c128/structures/s05c128xs.dgn	PLOT DATE: 16-NOV-2006
IPARM FILE NAME: s05c128ERI.i	DESIGNED BY: E.L.RUSTAY
SQUAD LEADER: C.P.WILLIAMS	DRAWN BY: E.L.RUSTAY
CHANNEL SECTIONS FOR M. HAUGHOUT	CHECKED BY: M.GAGULIC
	SHEET 23 OF 34