




11+27.85

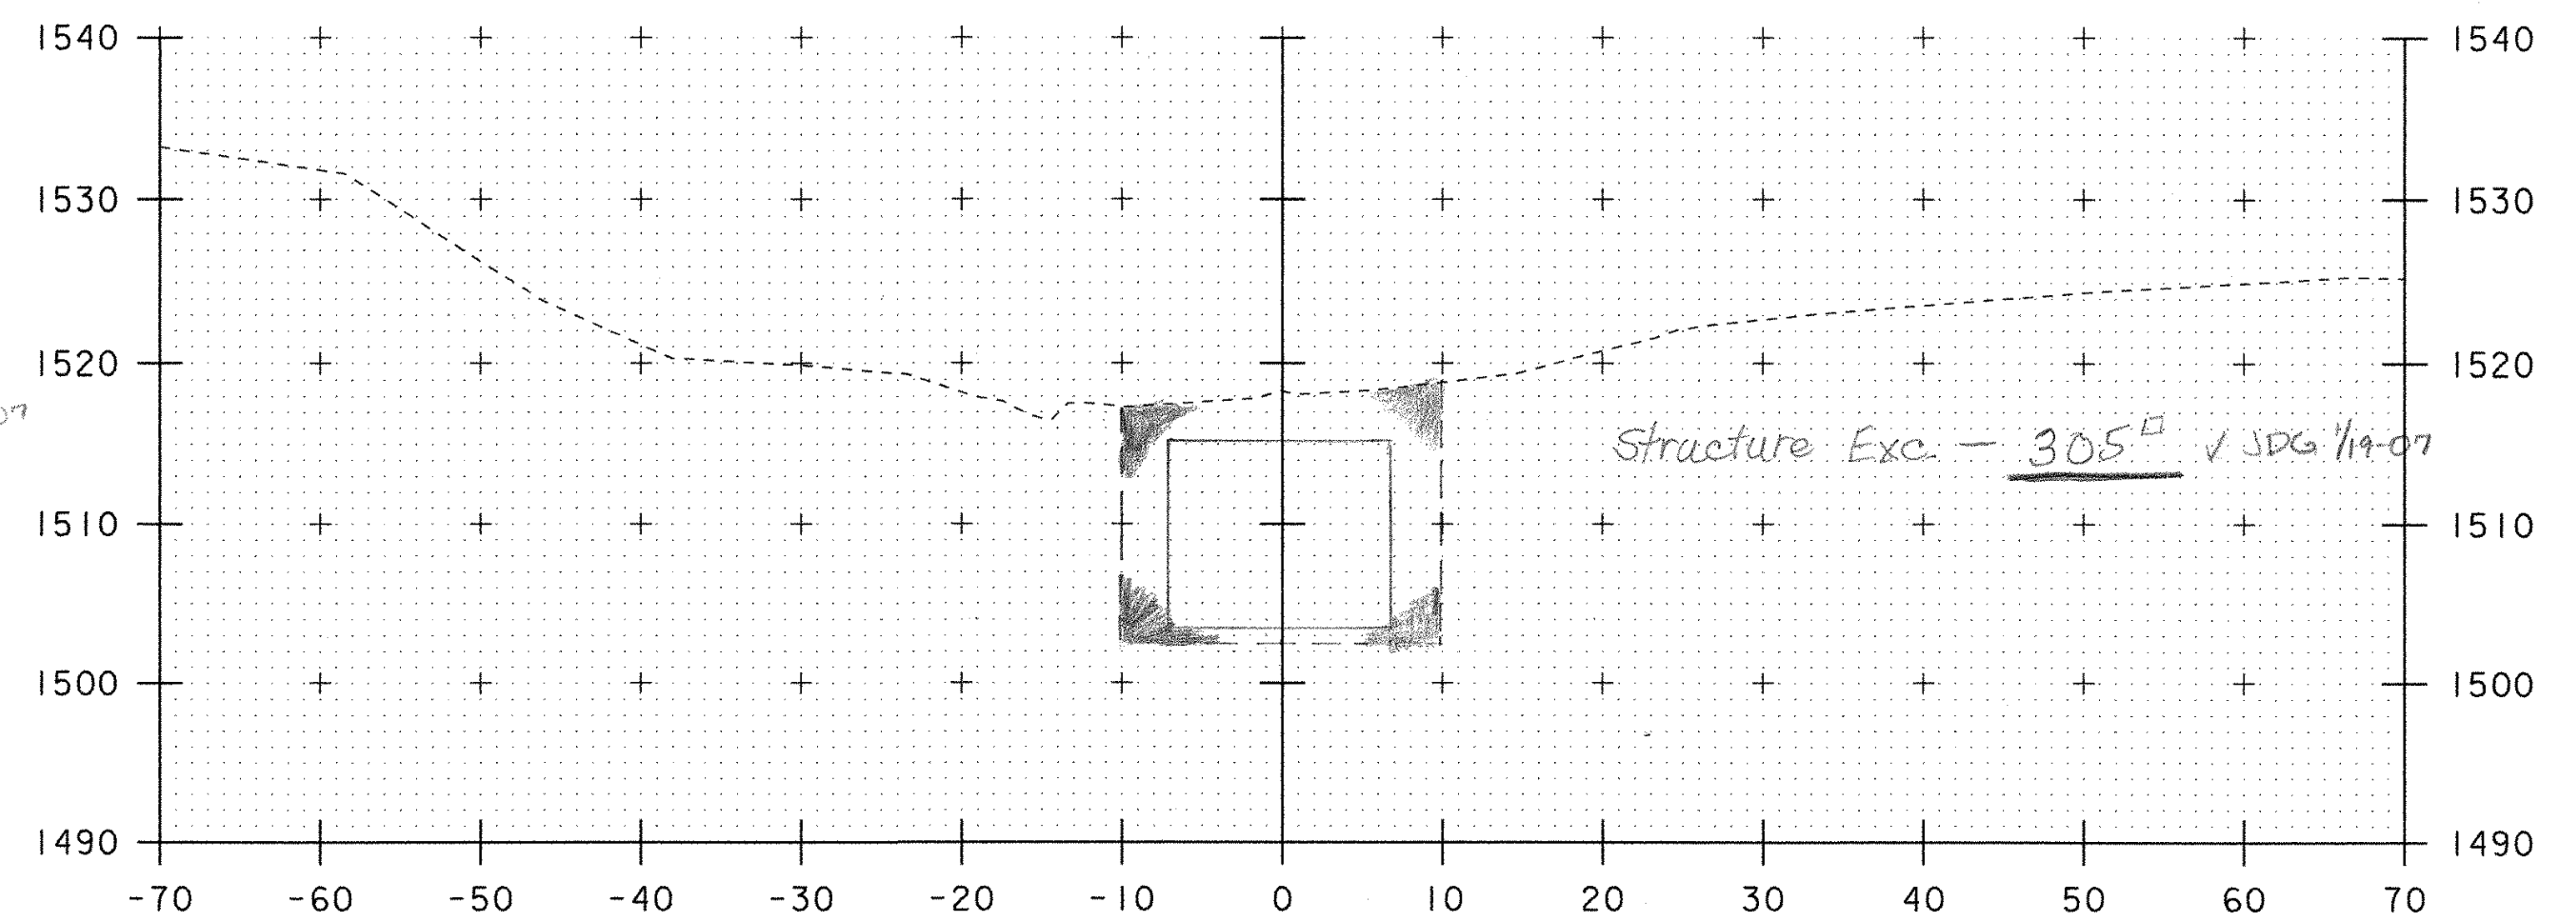

11+32.35

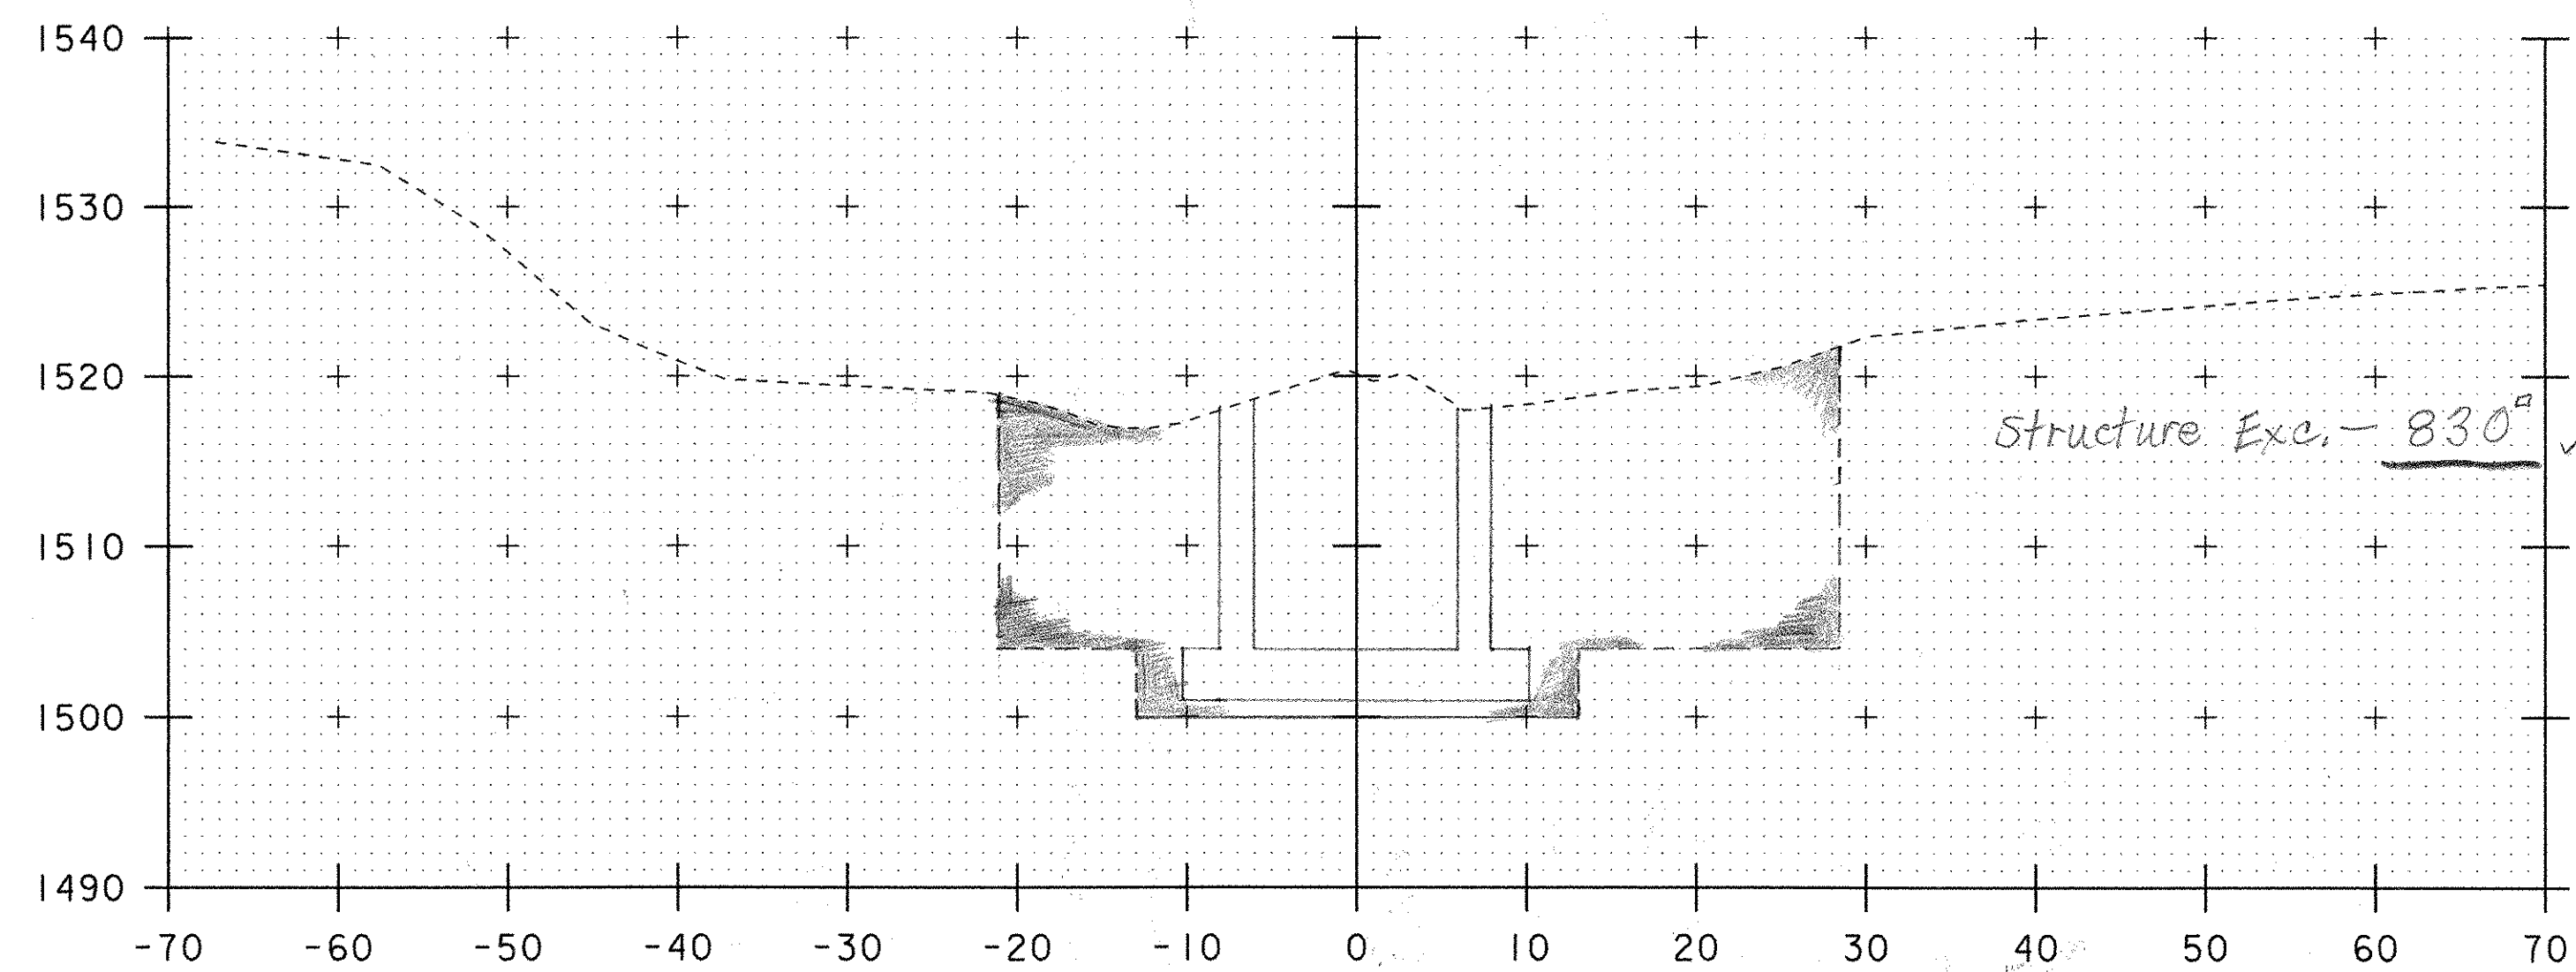

11+25.55

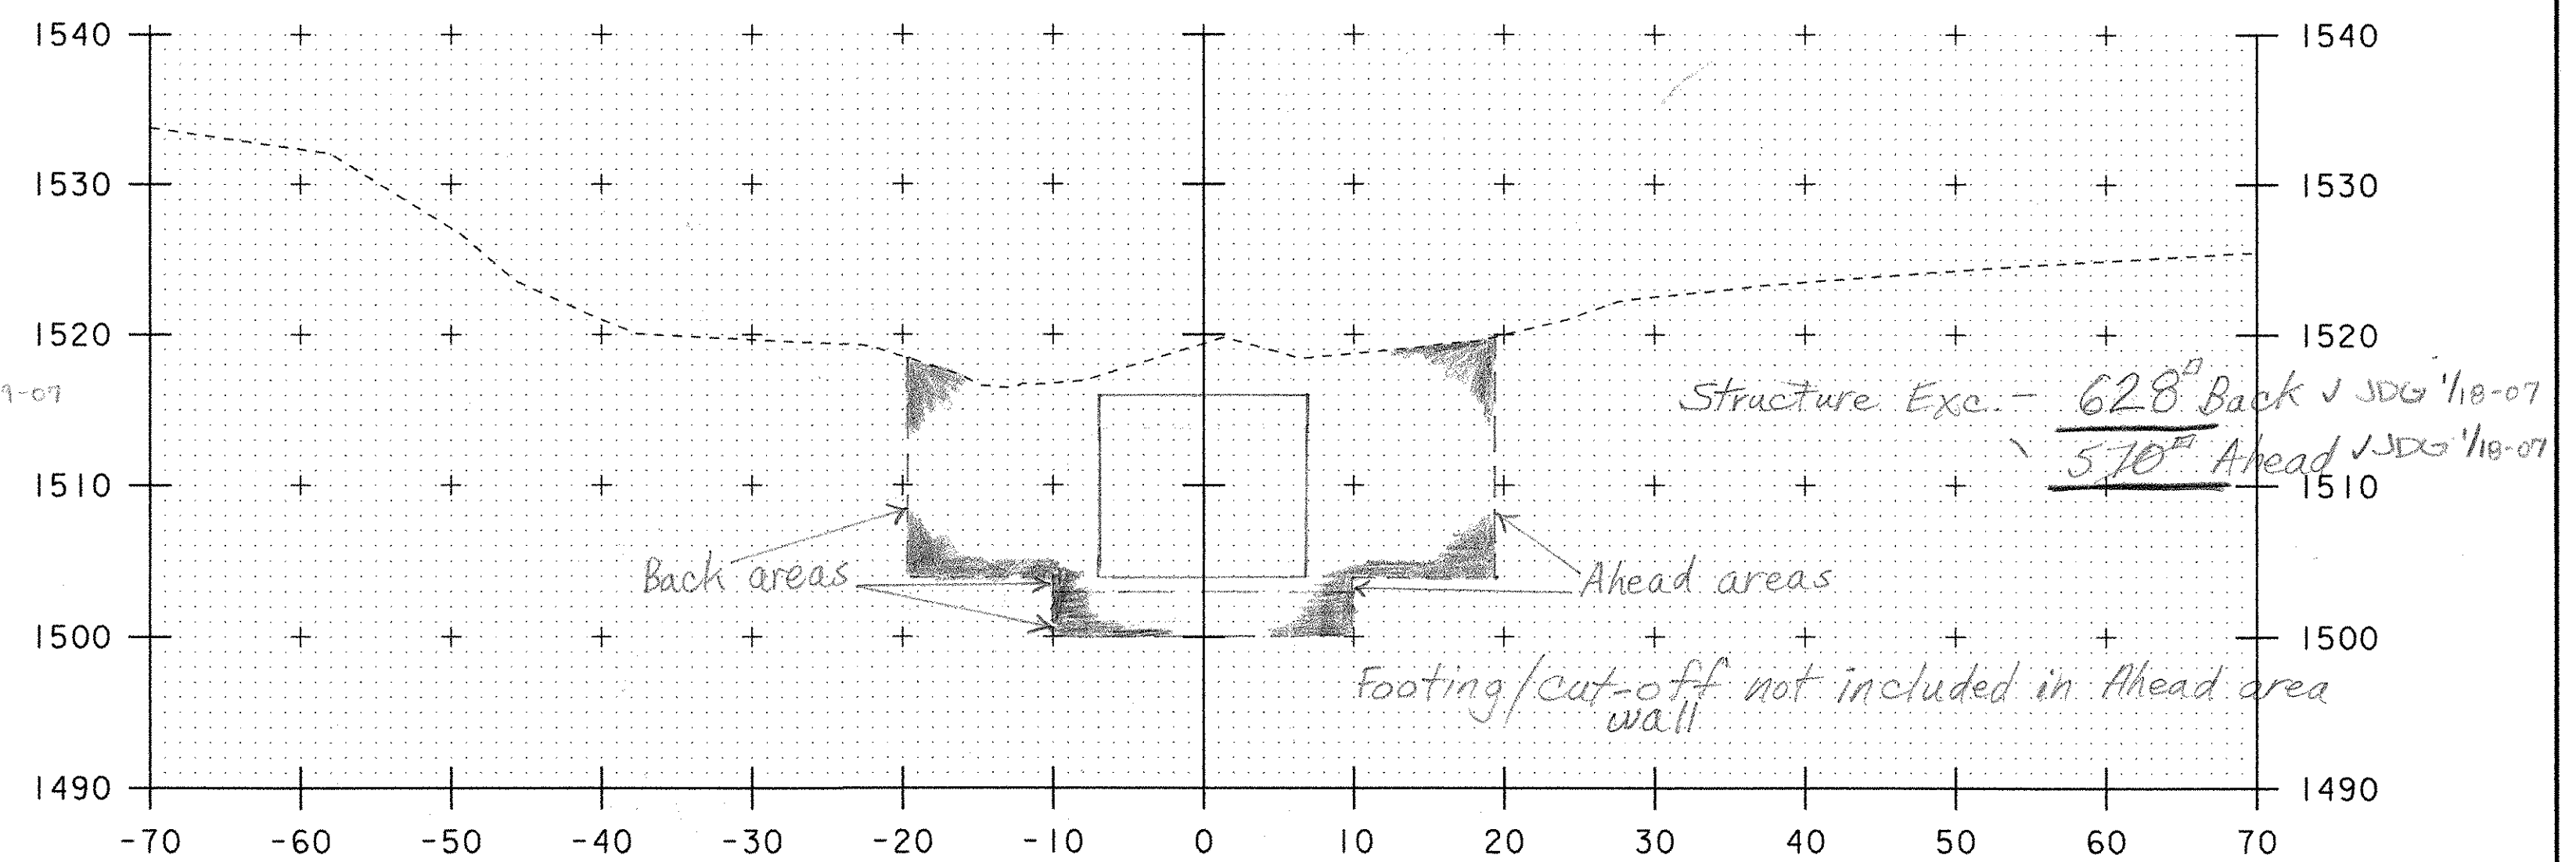

11+28.75

Sections calc. M.W. 1/9/07

PROJECT: WHITINGHAM	PROJECT NO.: ST CULV (6)
DESIGN FILE NAME: 05c128/structures/s05c128.dgn	PLOT DATE: 22-DEC-2006
IPARM FILE NAME:	DRAWN BY: E.L. RUSTAY
DESIGNED BY: E.L. RUSTAY	CHECKED BY:
SQUAD LEADER: C.P. WILLIAMS	SHEET: 88 OF 1
SECTIONS FOR M. HAUGHWOUT 12/22/06	

