



NO.	DATE
1	1/19/07
2	
3	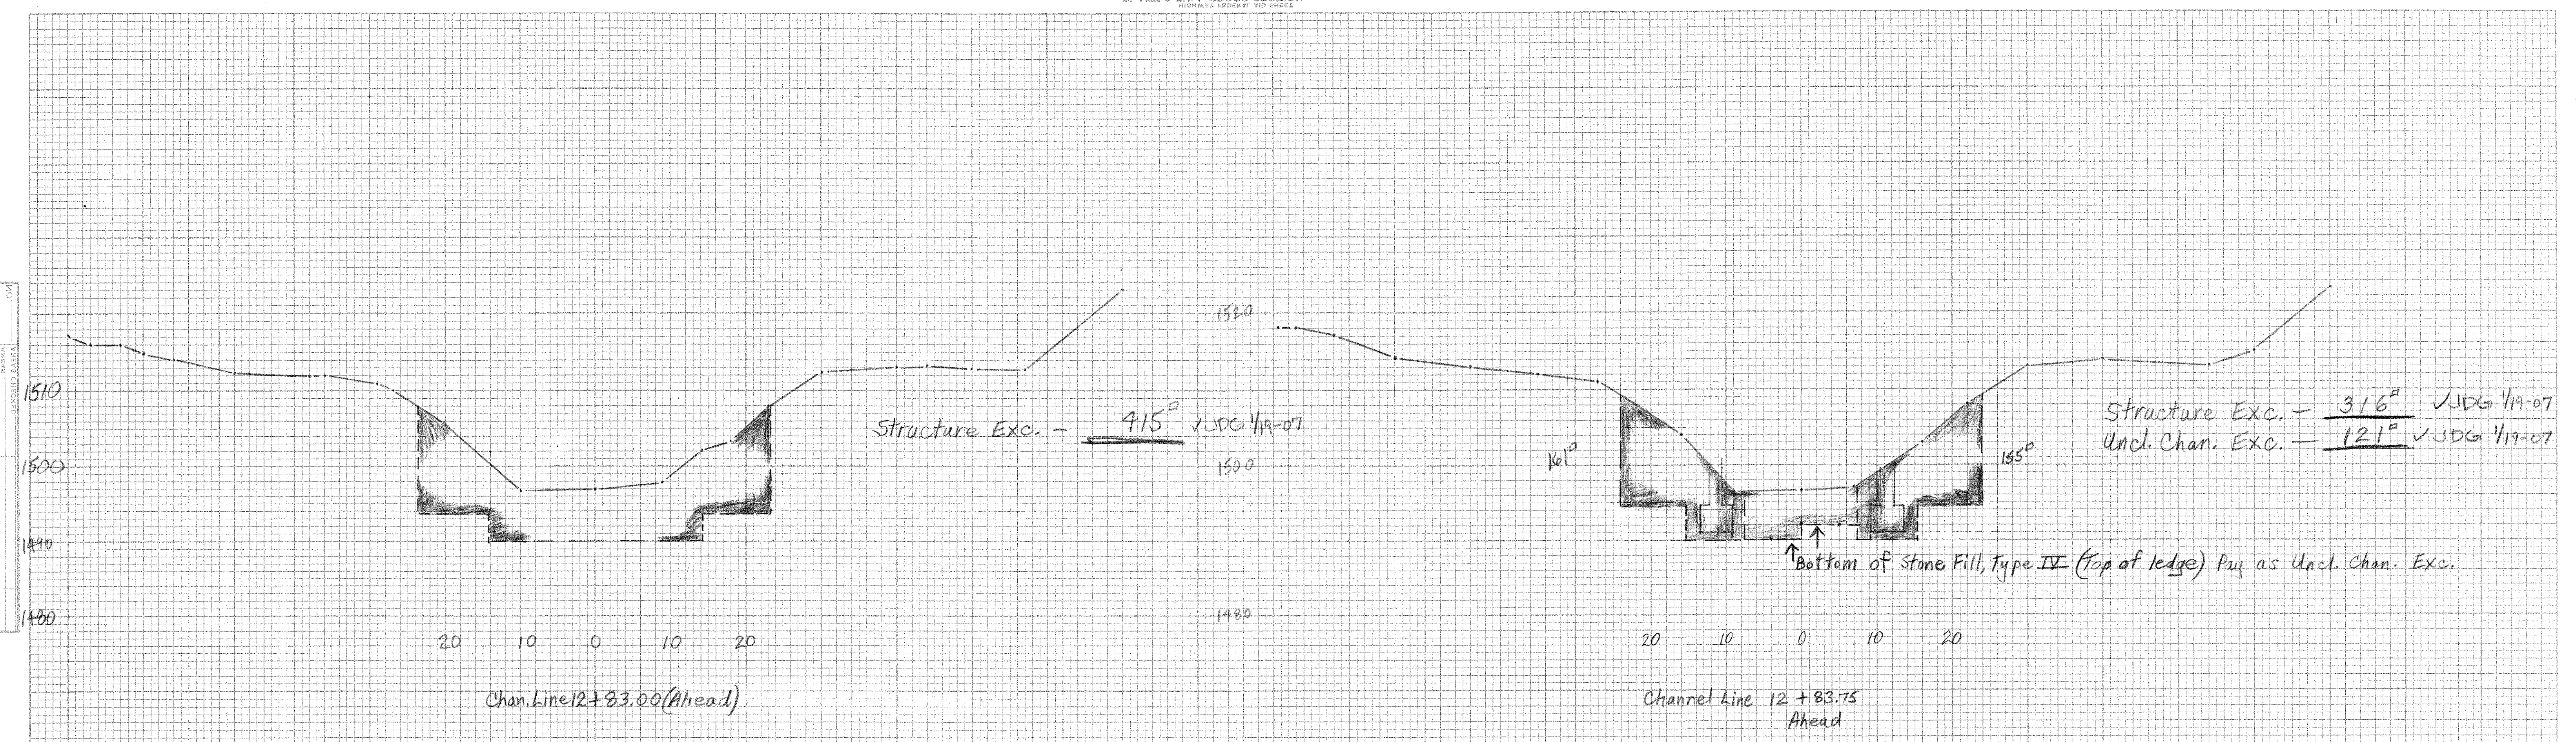
NO.	DATE
1	1/19/07
2	
3	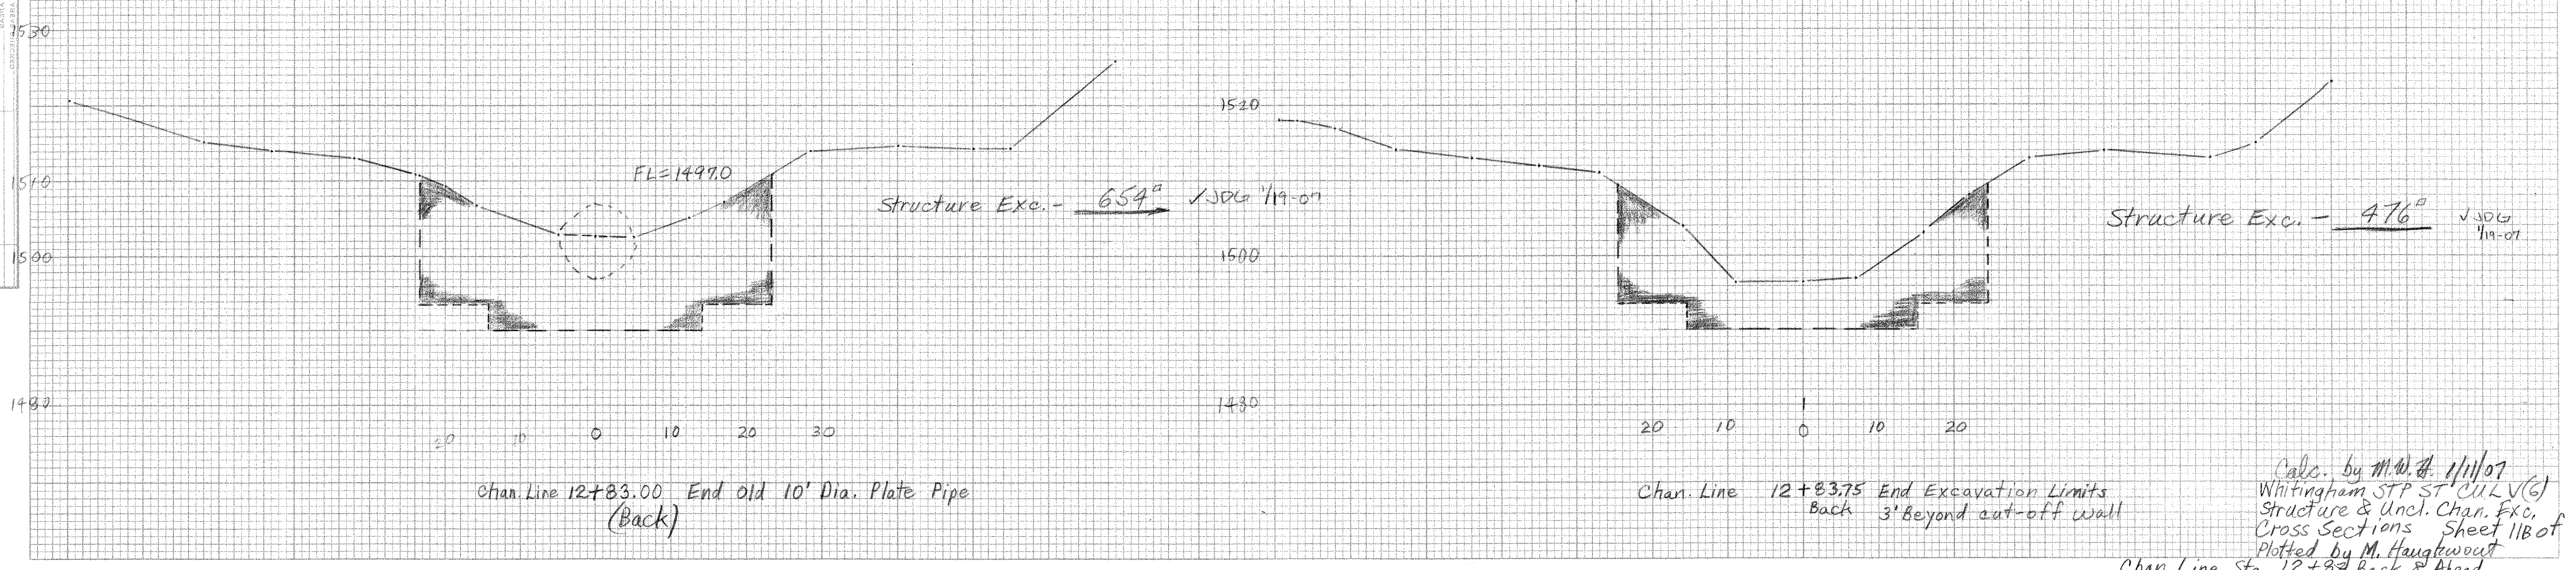
Calc. by M.W.H. 1/11/07  
 Whitingham STP ST CULVERT (C)  
 Structure & Uncl. Chan. Exc.  
 Cross Sections Sheet 11B of  
 Plotted by M. Hanglewout  
 Chan. Line Sta. 12+83 Back & Ahead  
 " " 12+83.75 Back & Ahead