




10+25

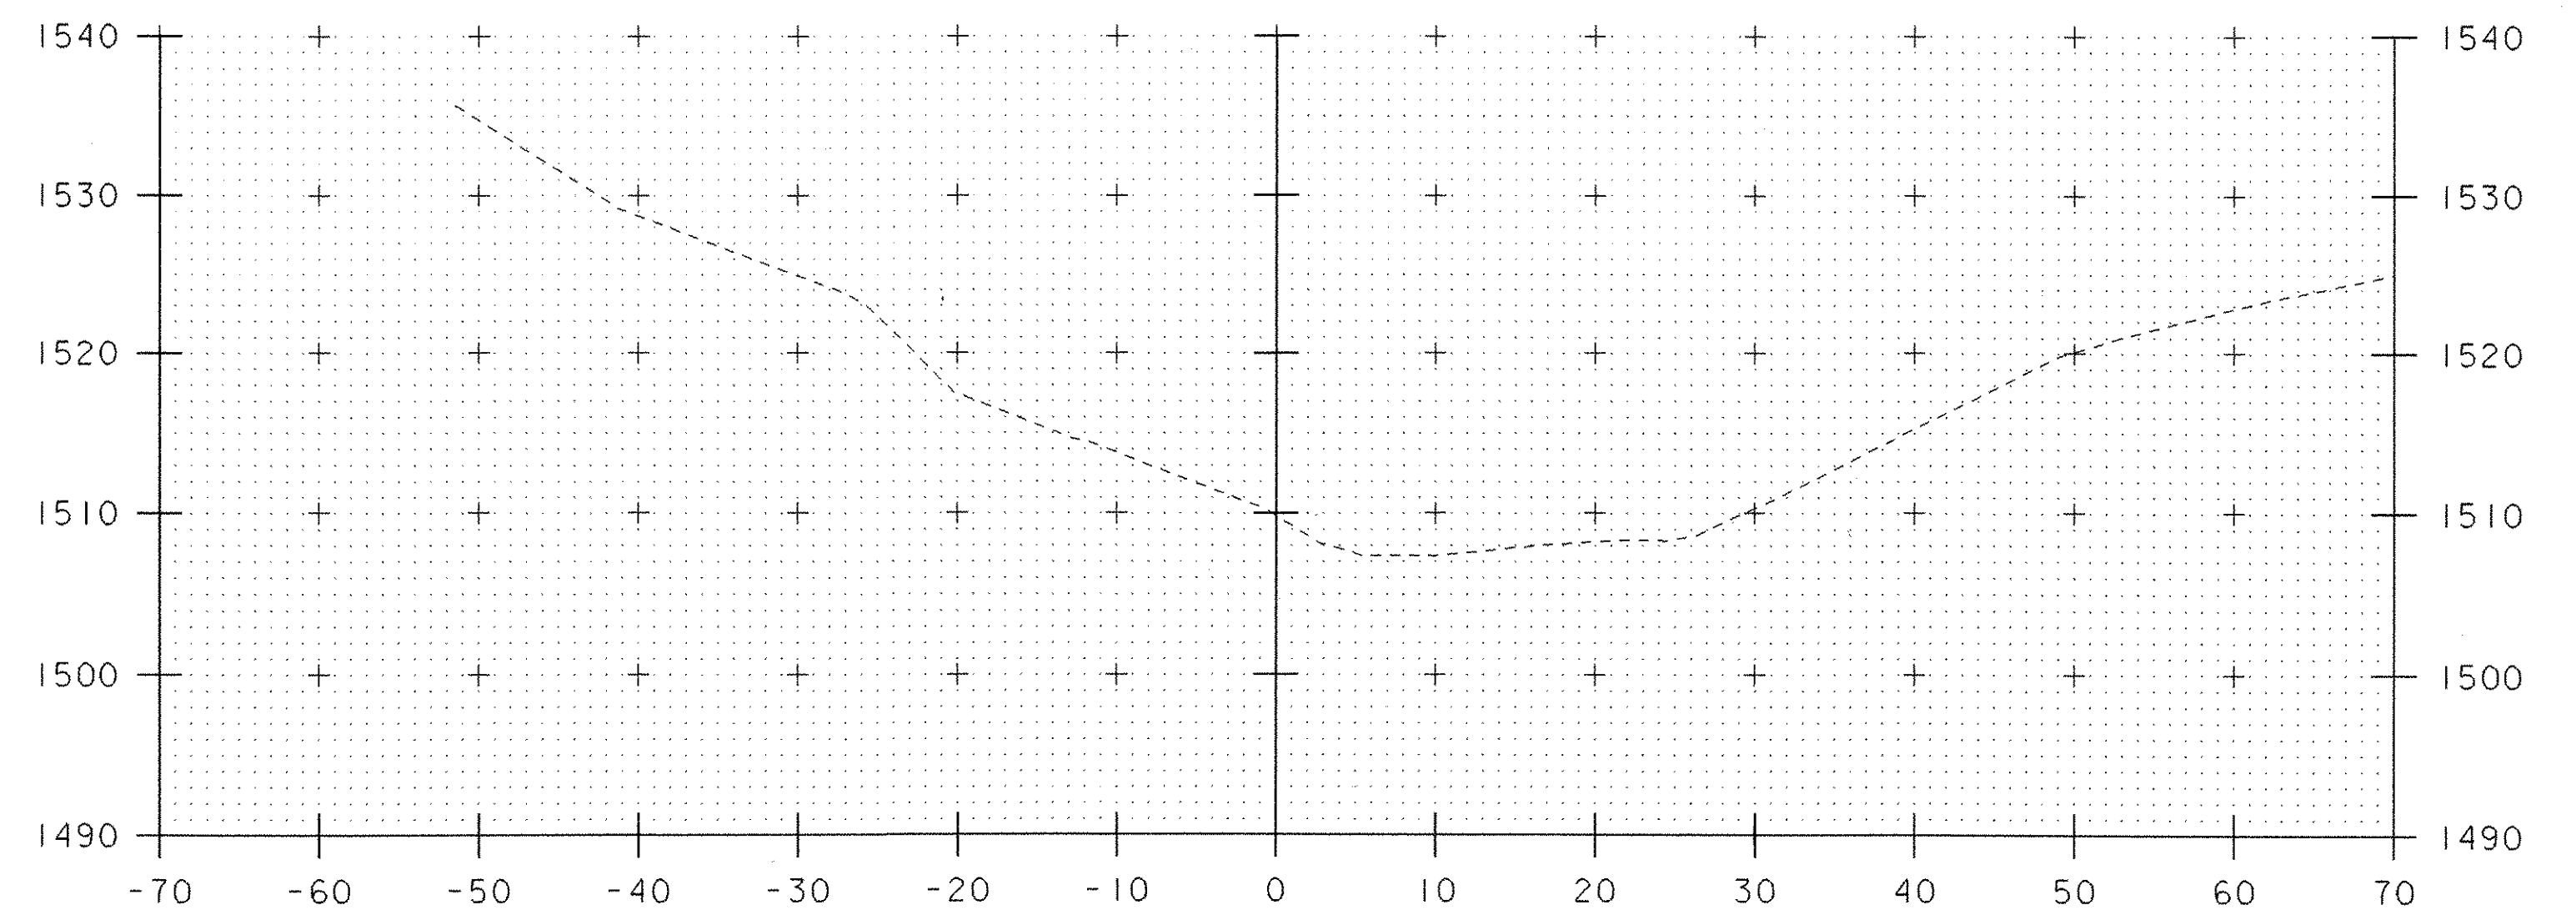

10+75

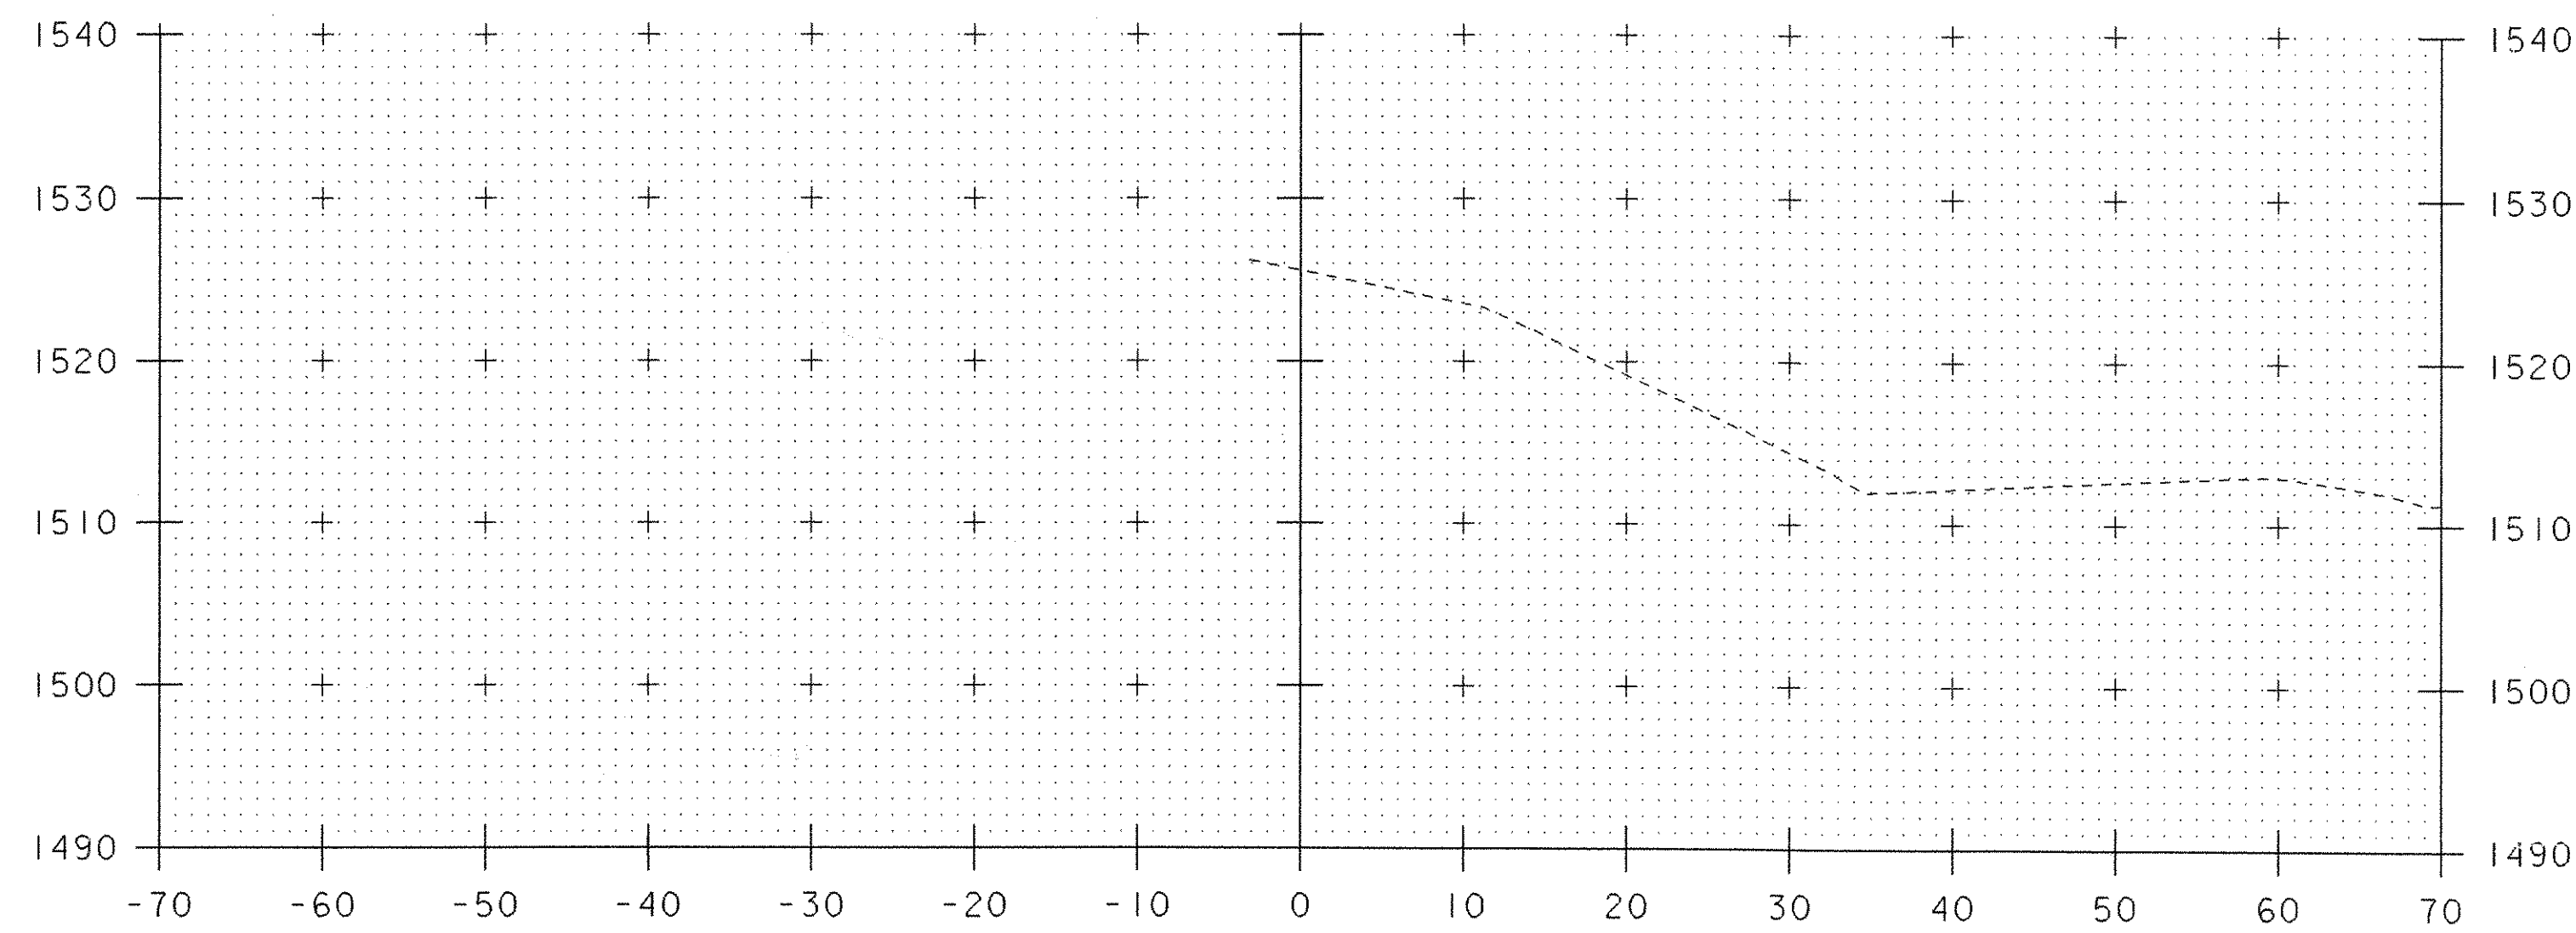

10+00

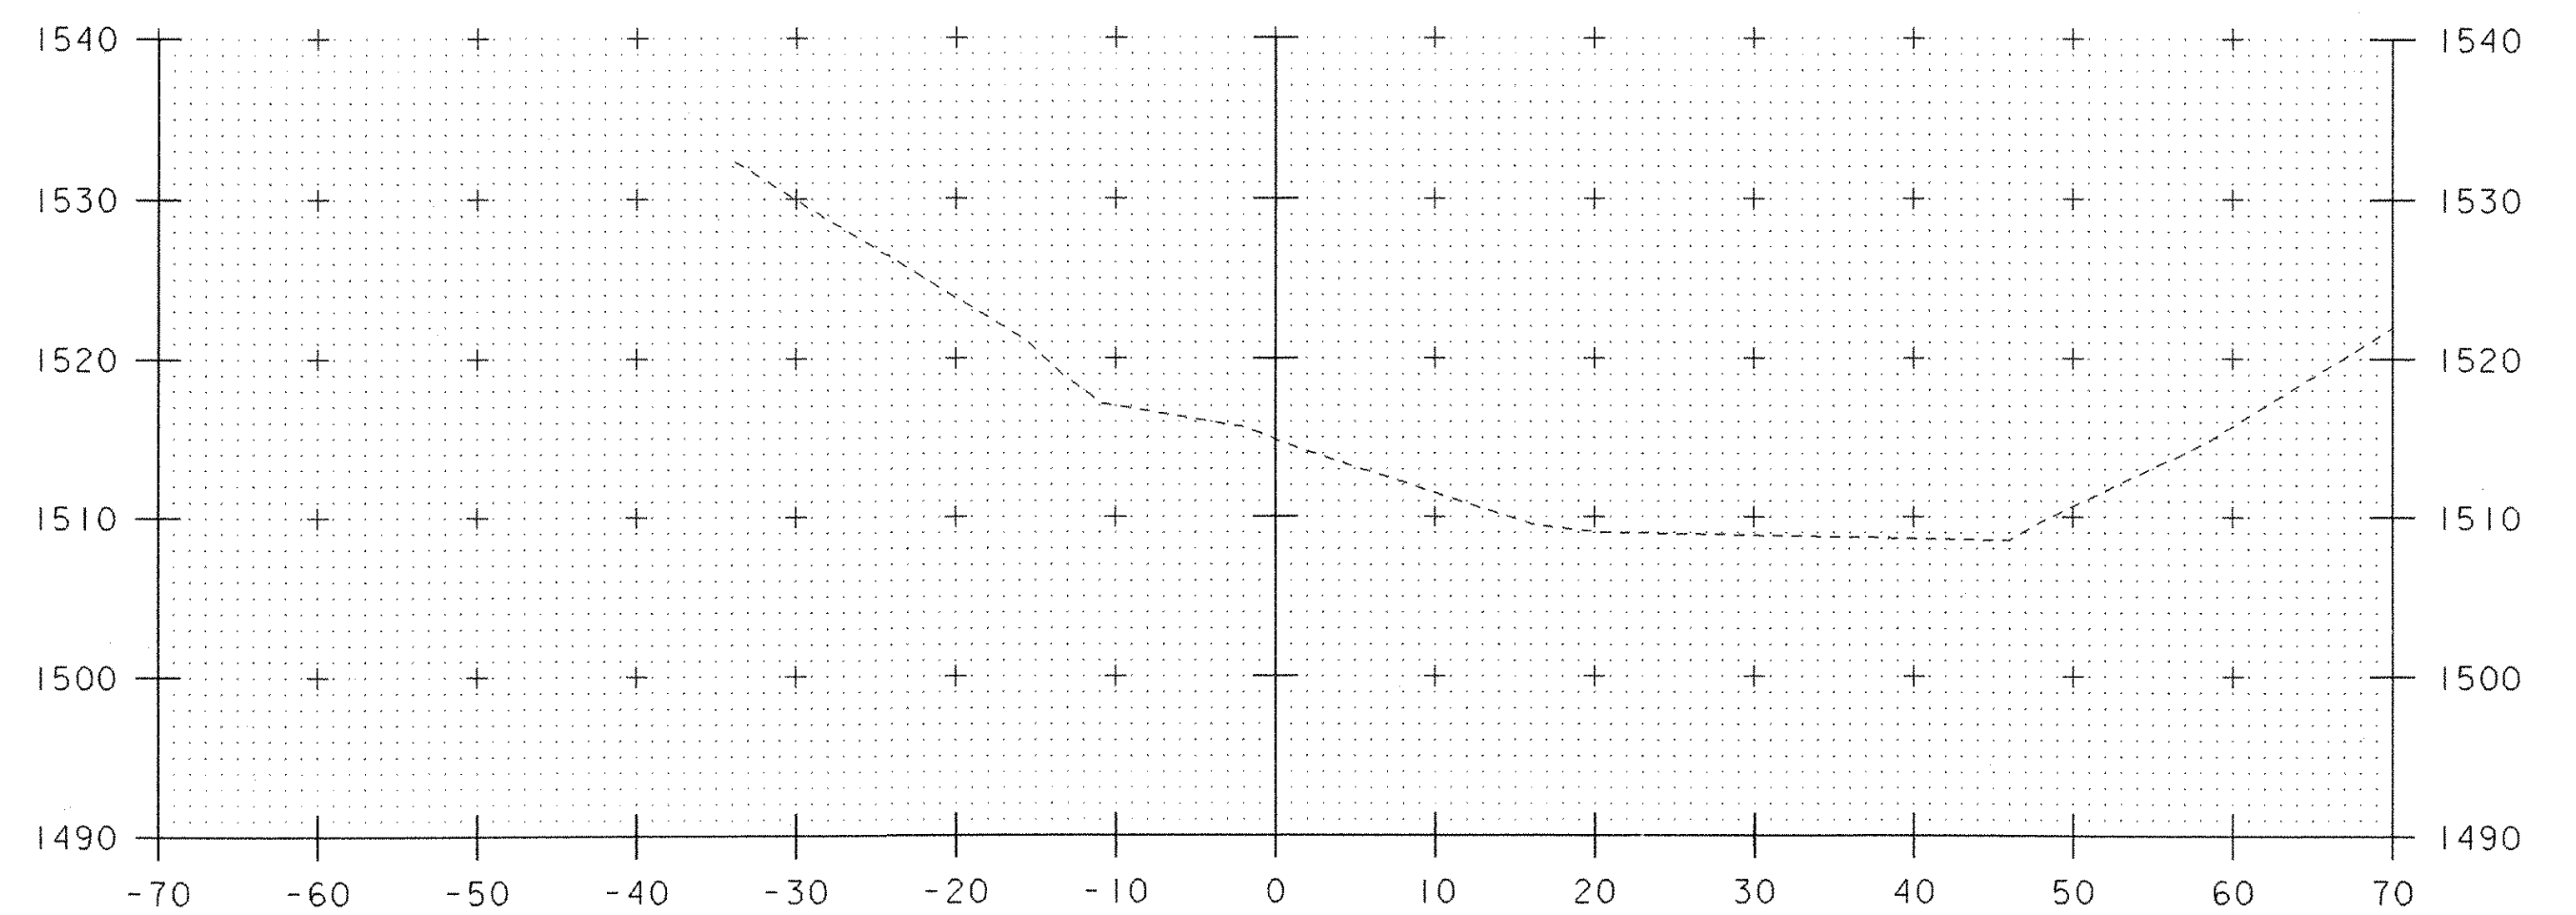

10+50

*No quantities on this sheet*

SCALE 1" = 10'-0"  
 10 0 10

PROJECT: WHITINGHAM	PROJECT NO.: ST CULV (6)
DESIGN FILE NAME: 05c128/structures/s05c128xs.dgn	PLOT DATE: 27-JUN-2006
IPARM FILE NAME: s05c128chl.i	DESIGNED BY: E. L. RUSTAY
SQUAD LEADER: C. P. WILLIAMS	DRAWN BY: E. L. RUSTAY
CHANNEL STA 10+00 - STA 10+75	CHECKED BY: M. GAGULIC
	SHEET: 4 OF 12