




11+50

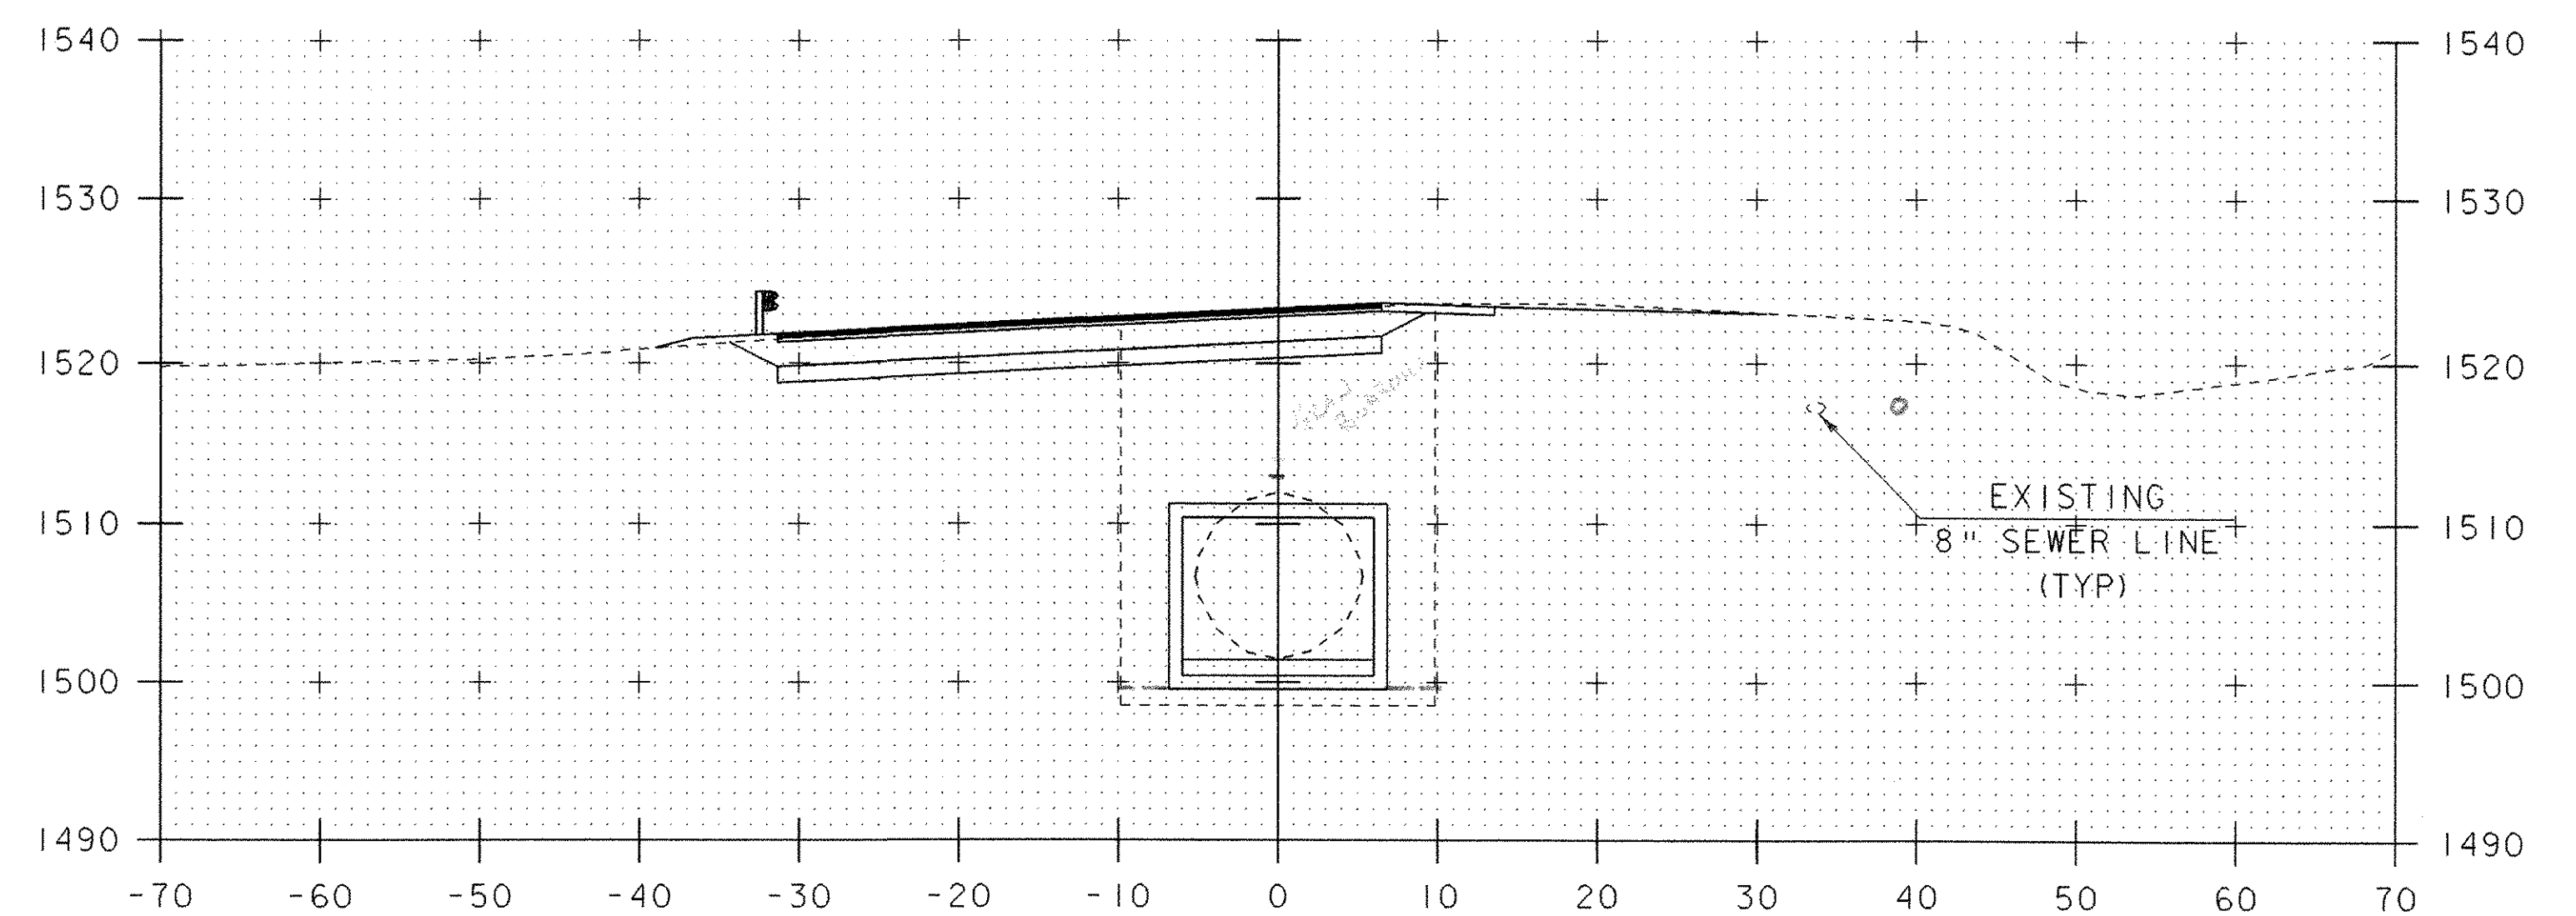

12+00

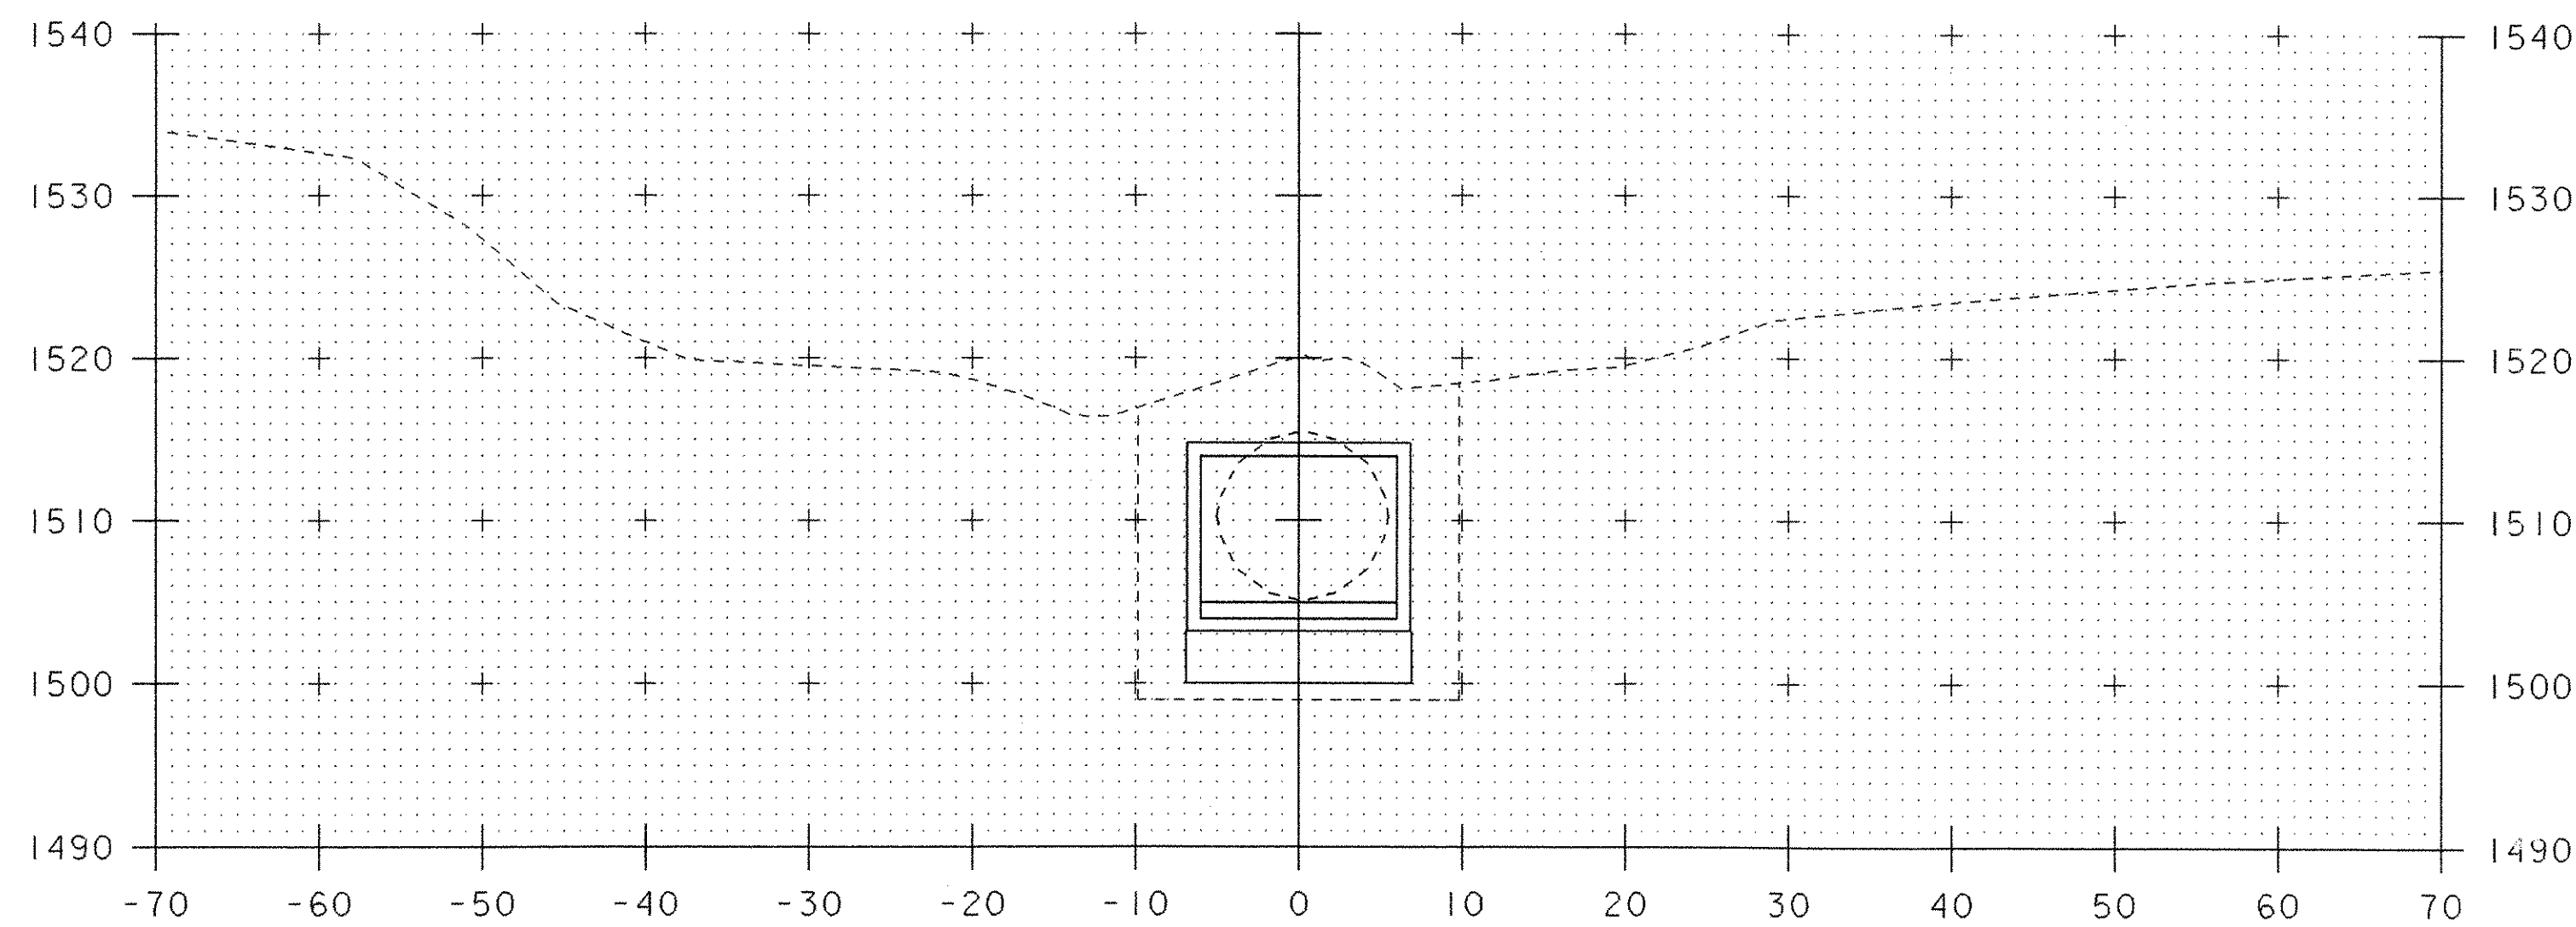

11+26.77  
EXCAVATION LIMITS

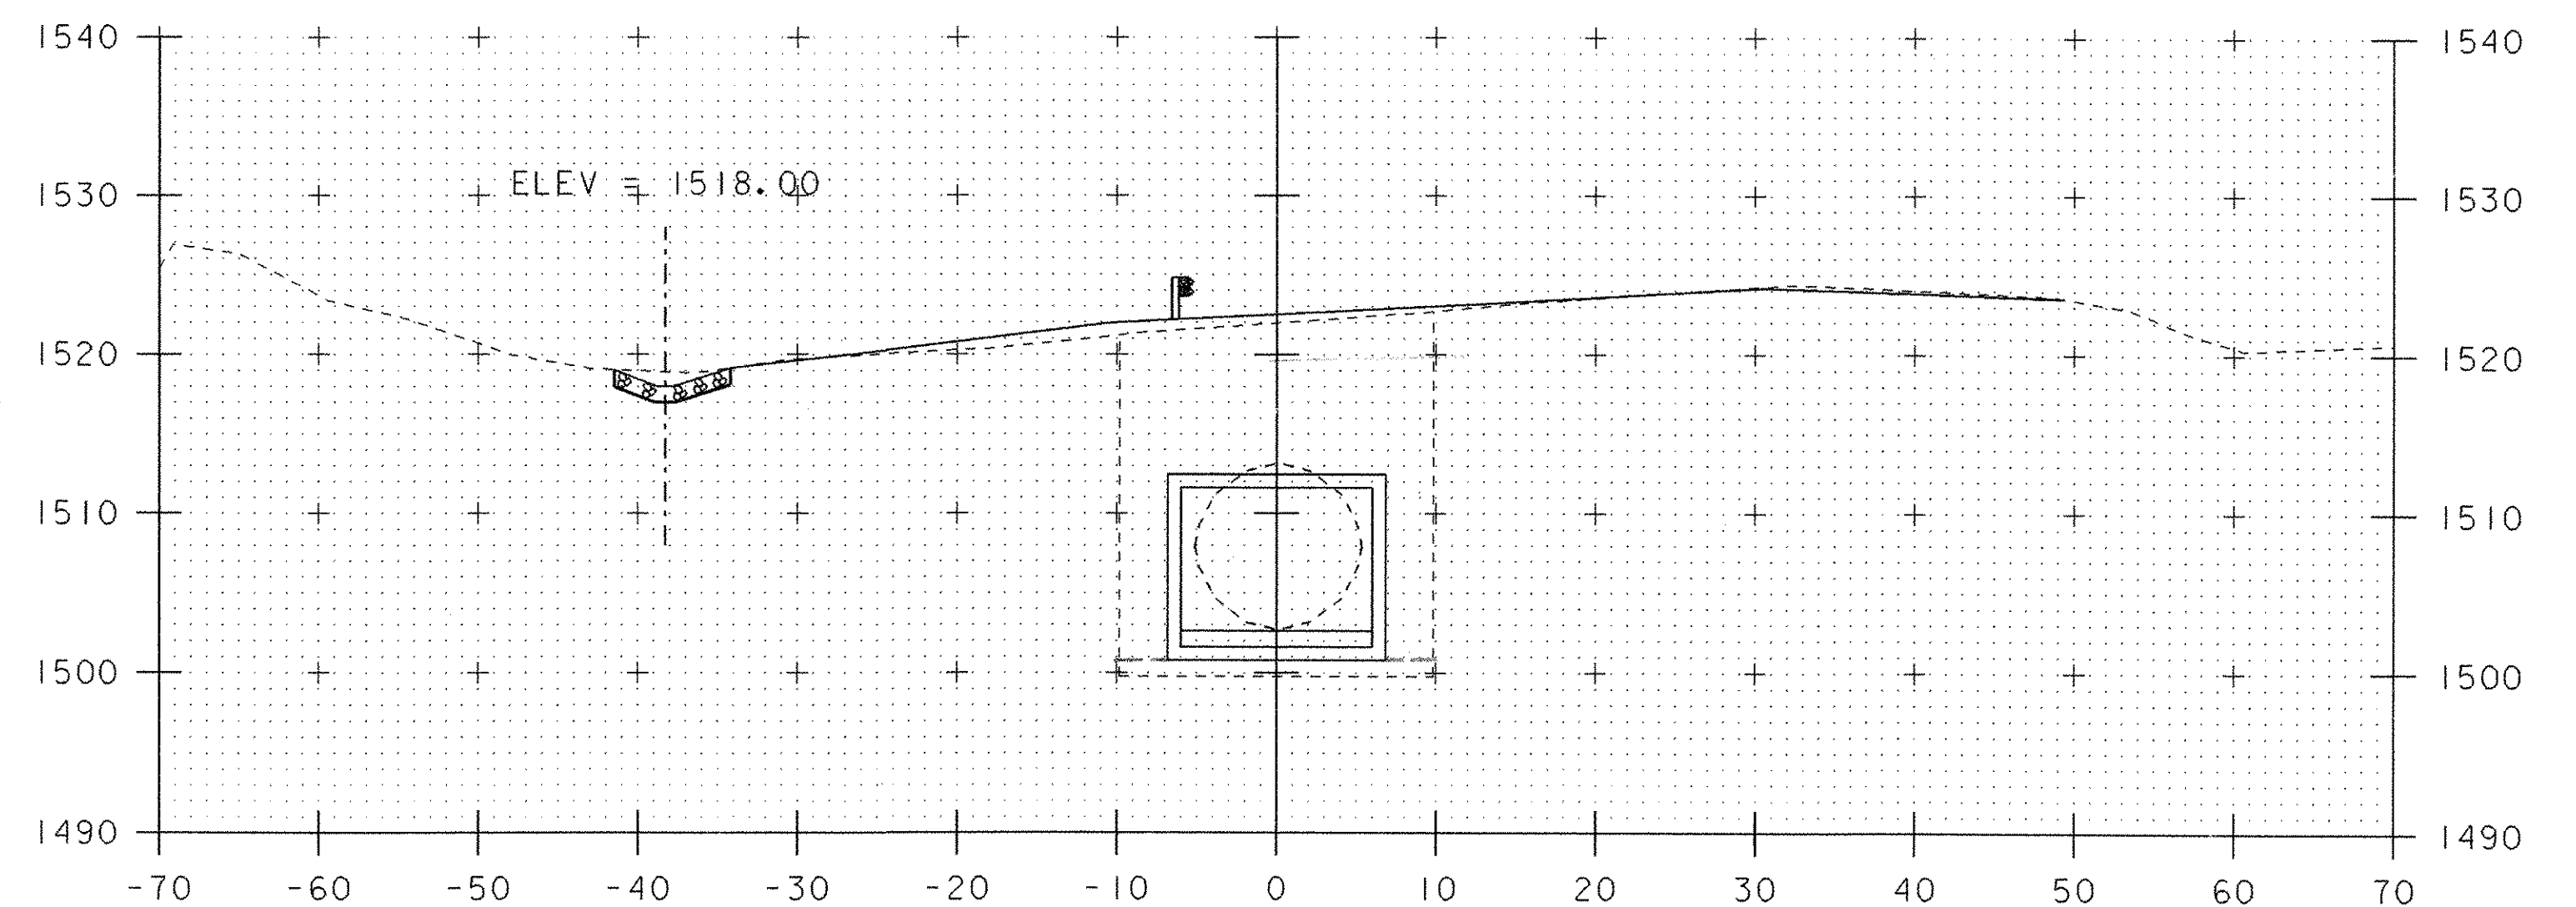

11+75

*See larger set of plans  
for quantities calculated.*

SCALE 1" = 10'-0"  
10 0 10

PROJECT: WHITINGHAM	PROJECT NO.: ST CULV (6)
DESIGN FILE NAME: 05c128/structures/s05c128xs.dgn	PLOT DATE: 27-JUN-2006
IPARM FILE NAME: s05c128ch2.i	DESIGNED BY: E.L.RUSTAY
SQUAD LEADER: C.P.WILLIAMS	DRAWN BY: E.L.RUSTAY
CHAN STA 11+26.77 - STA 12+00	CHECKED BY: M.GAGULIC
	SHEET: 8 OF 12