




12+97.41 - Use for Sta. 12+98 also
 FRONT EXCAVATION LIMITS @ WW4

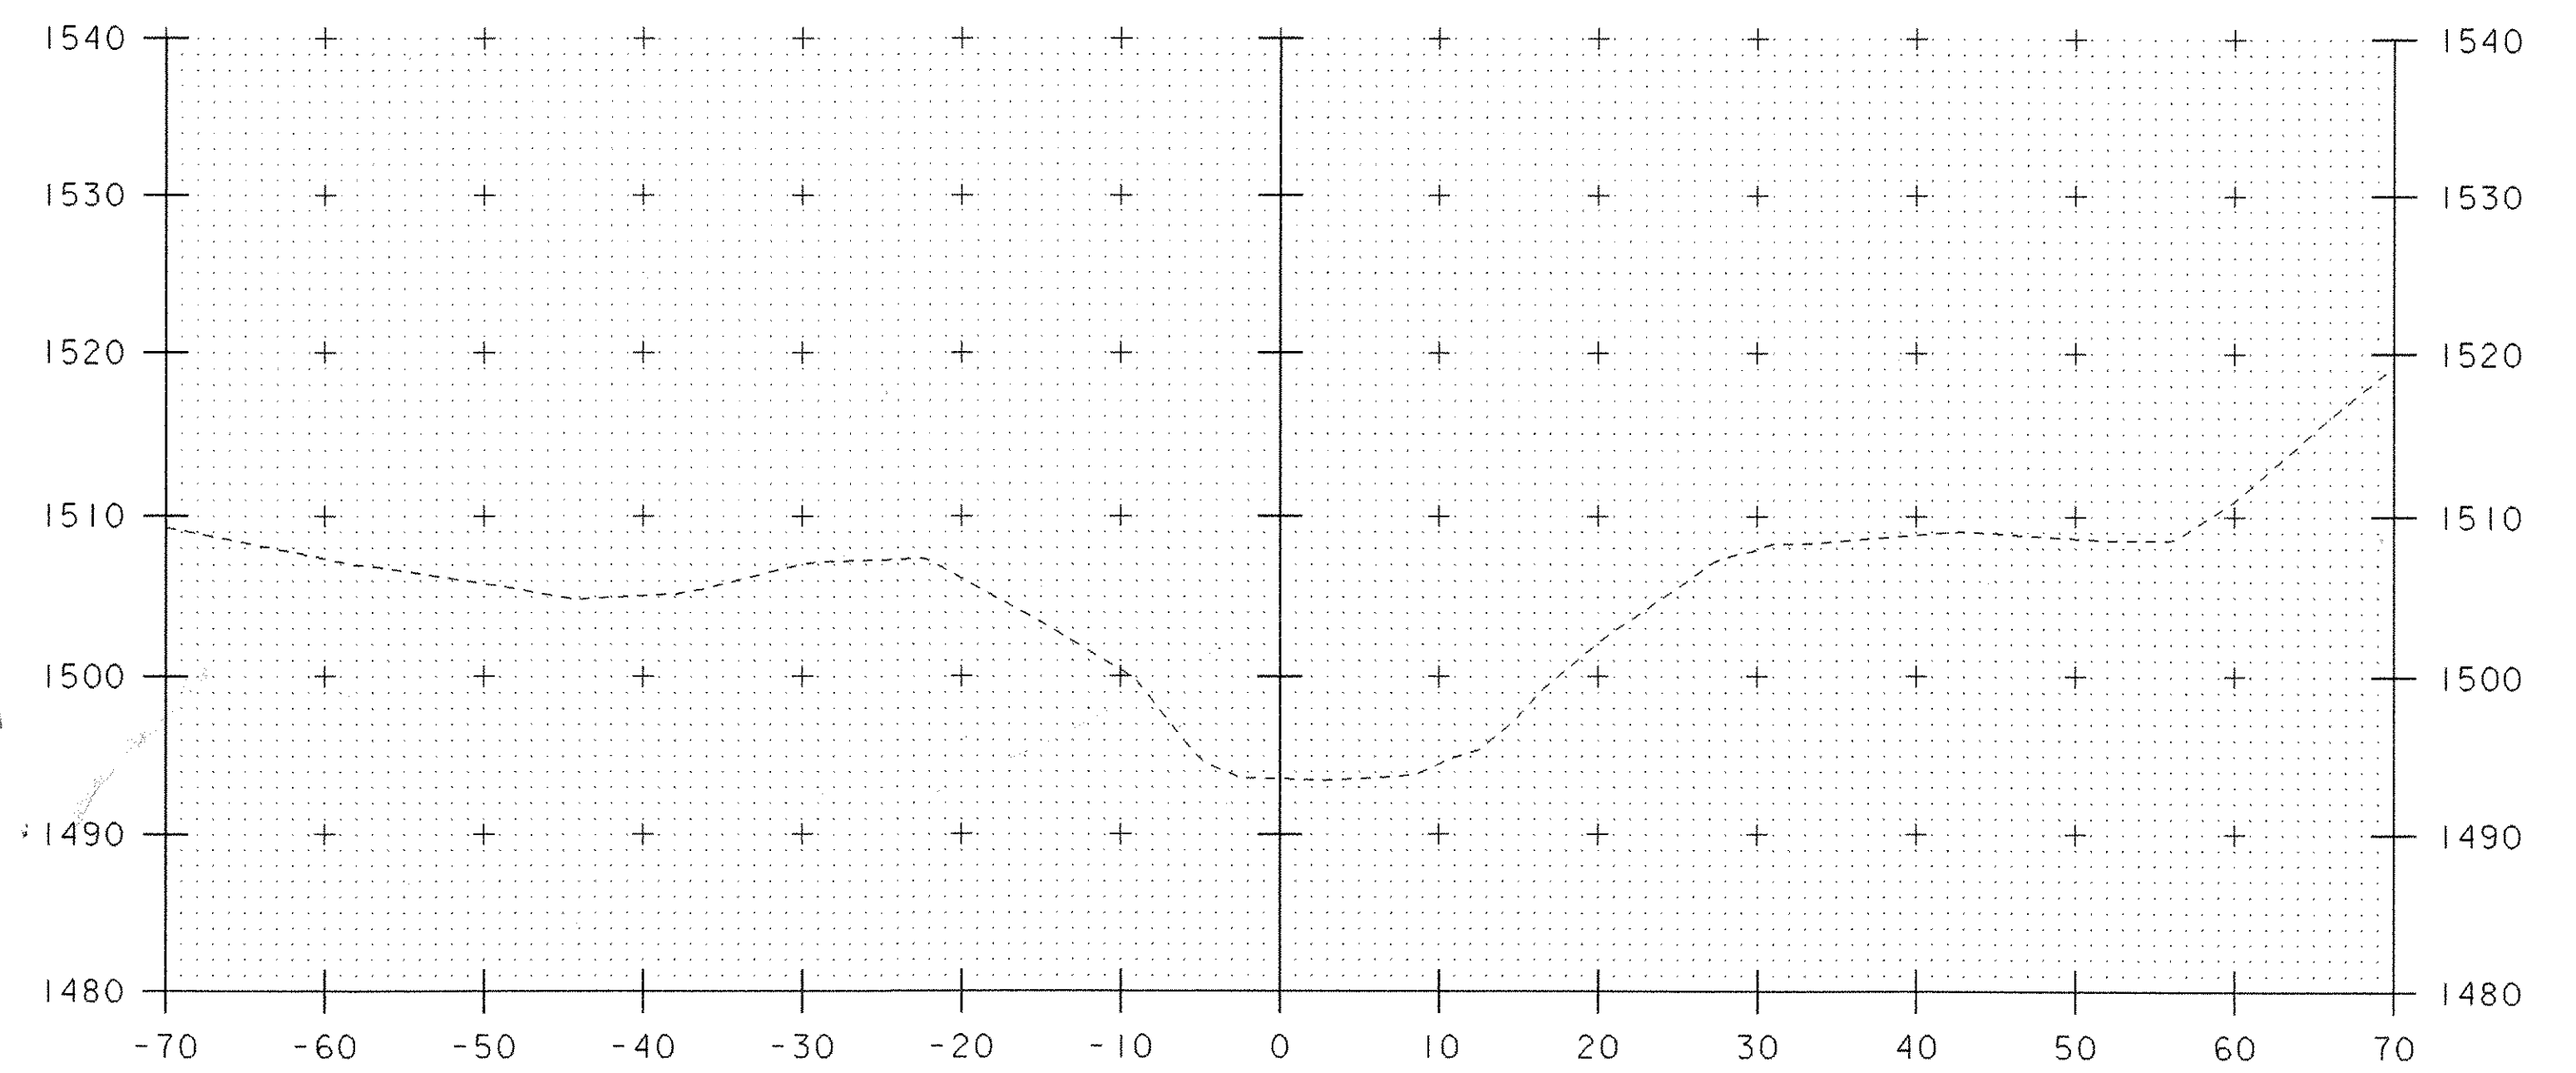

13+25

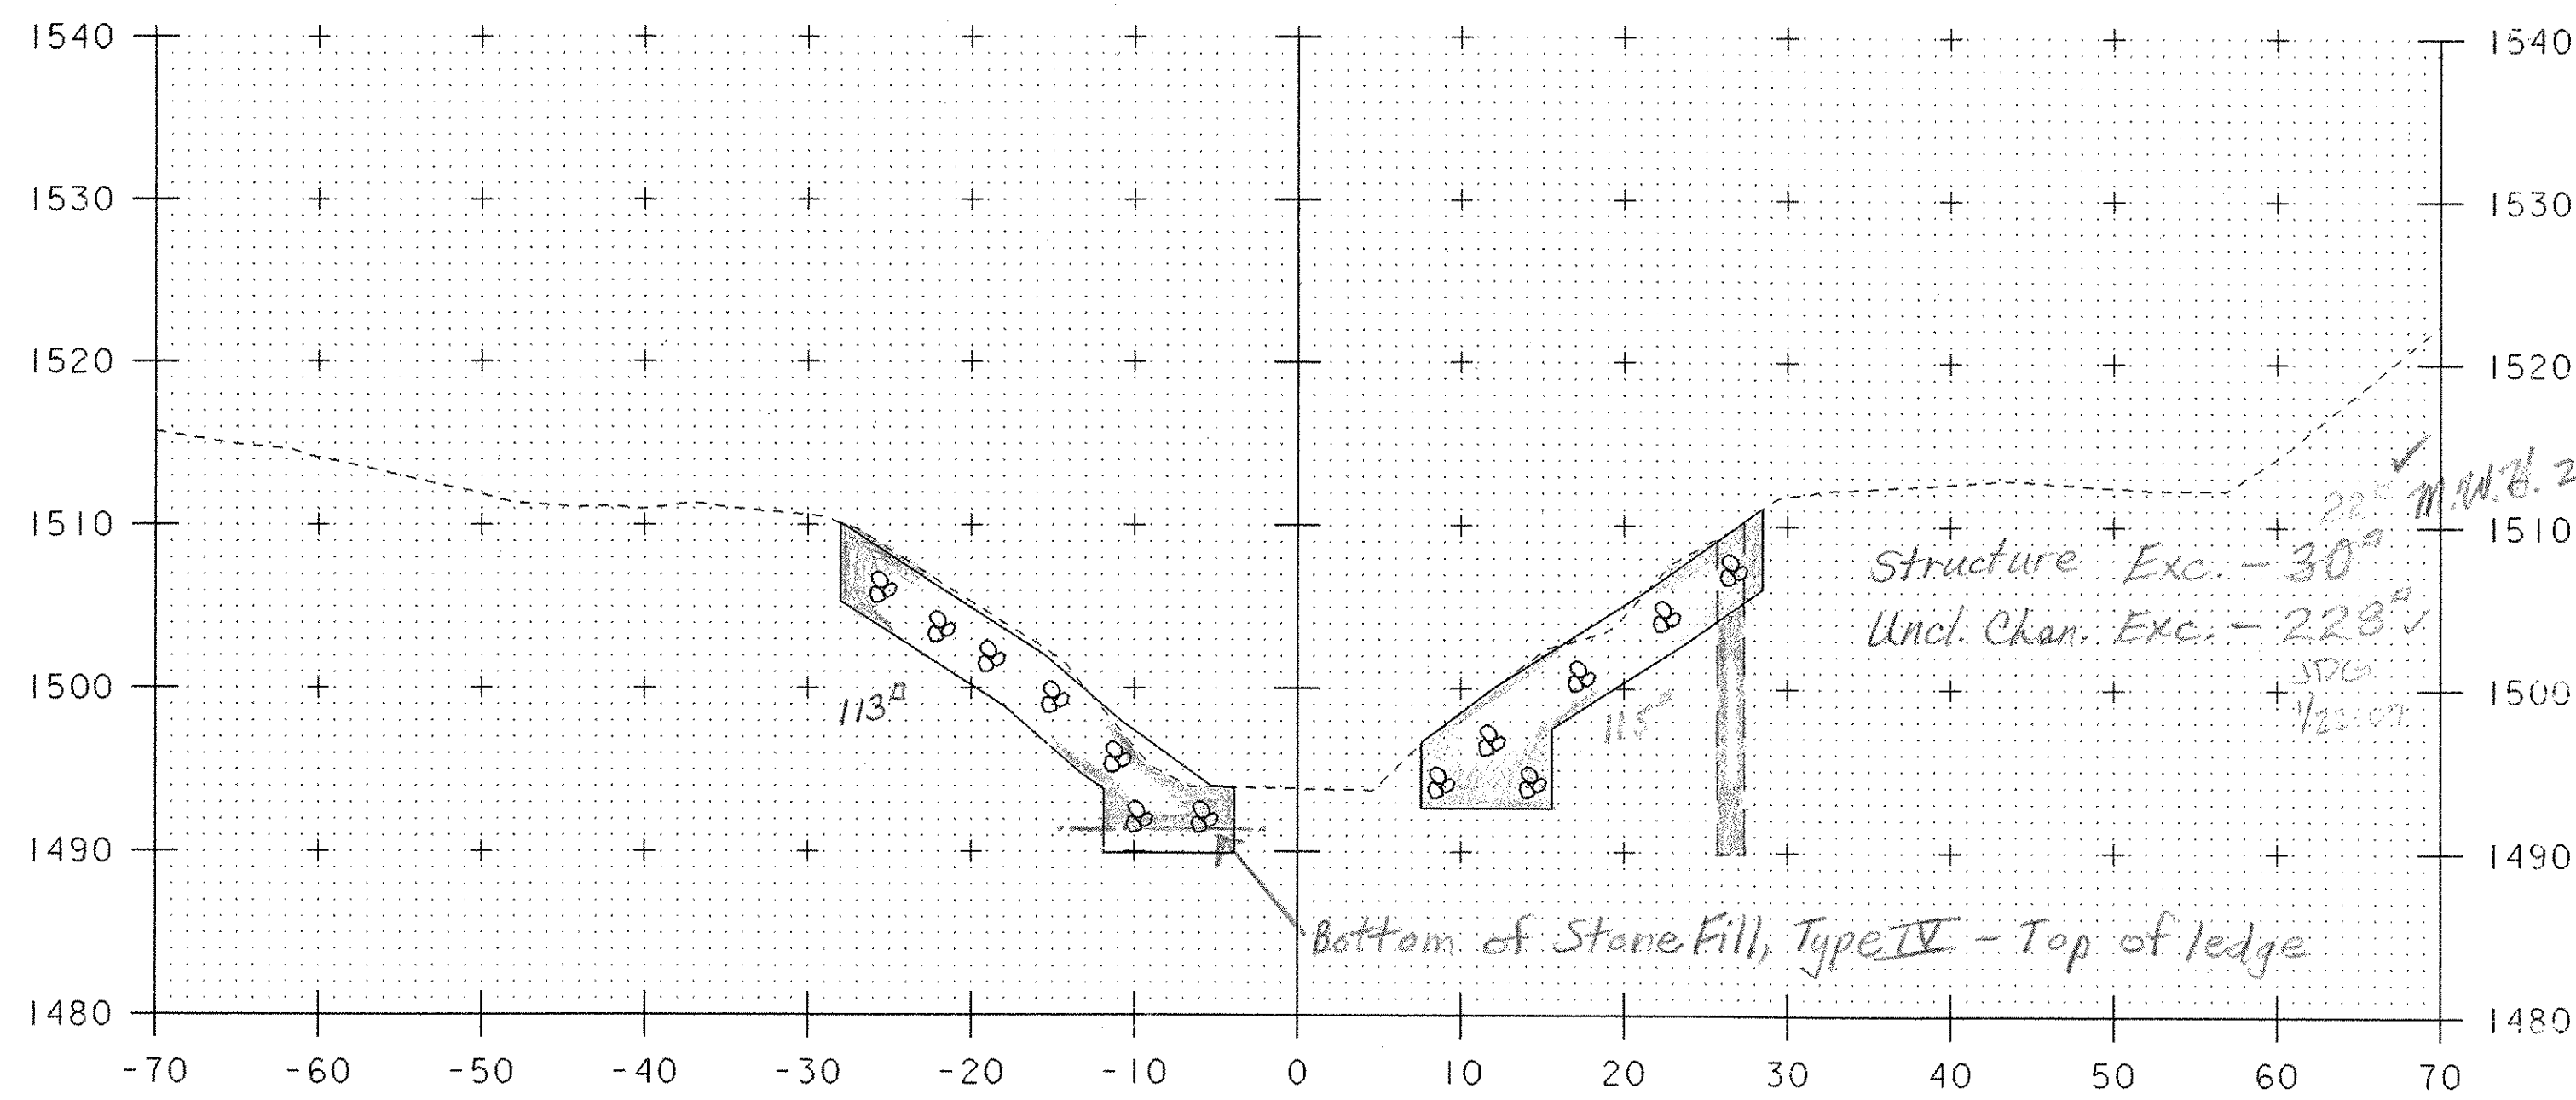

12+96.55
 FRONT EXCAVATION LIMITS @ WW3

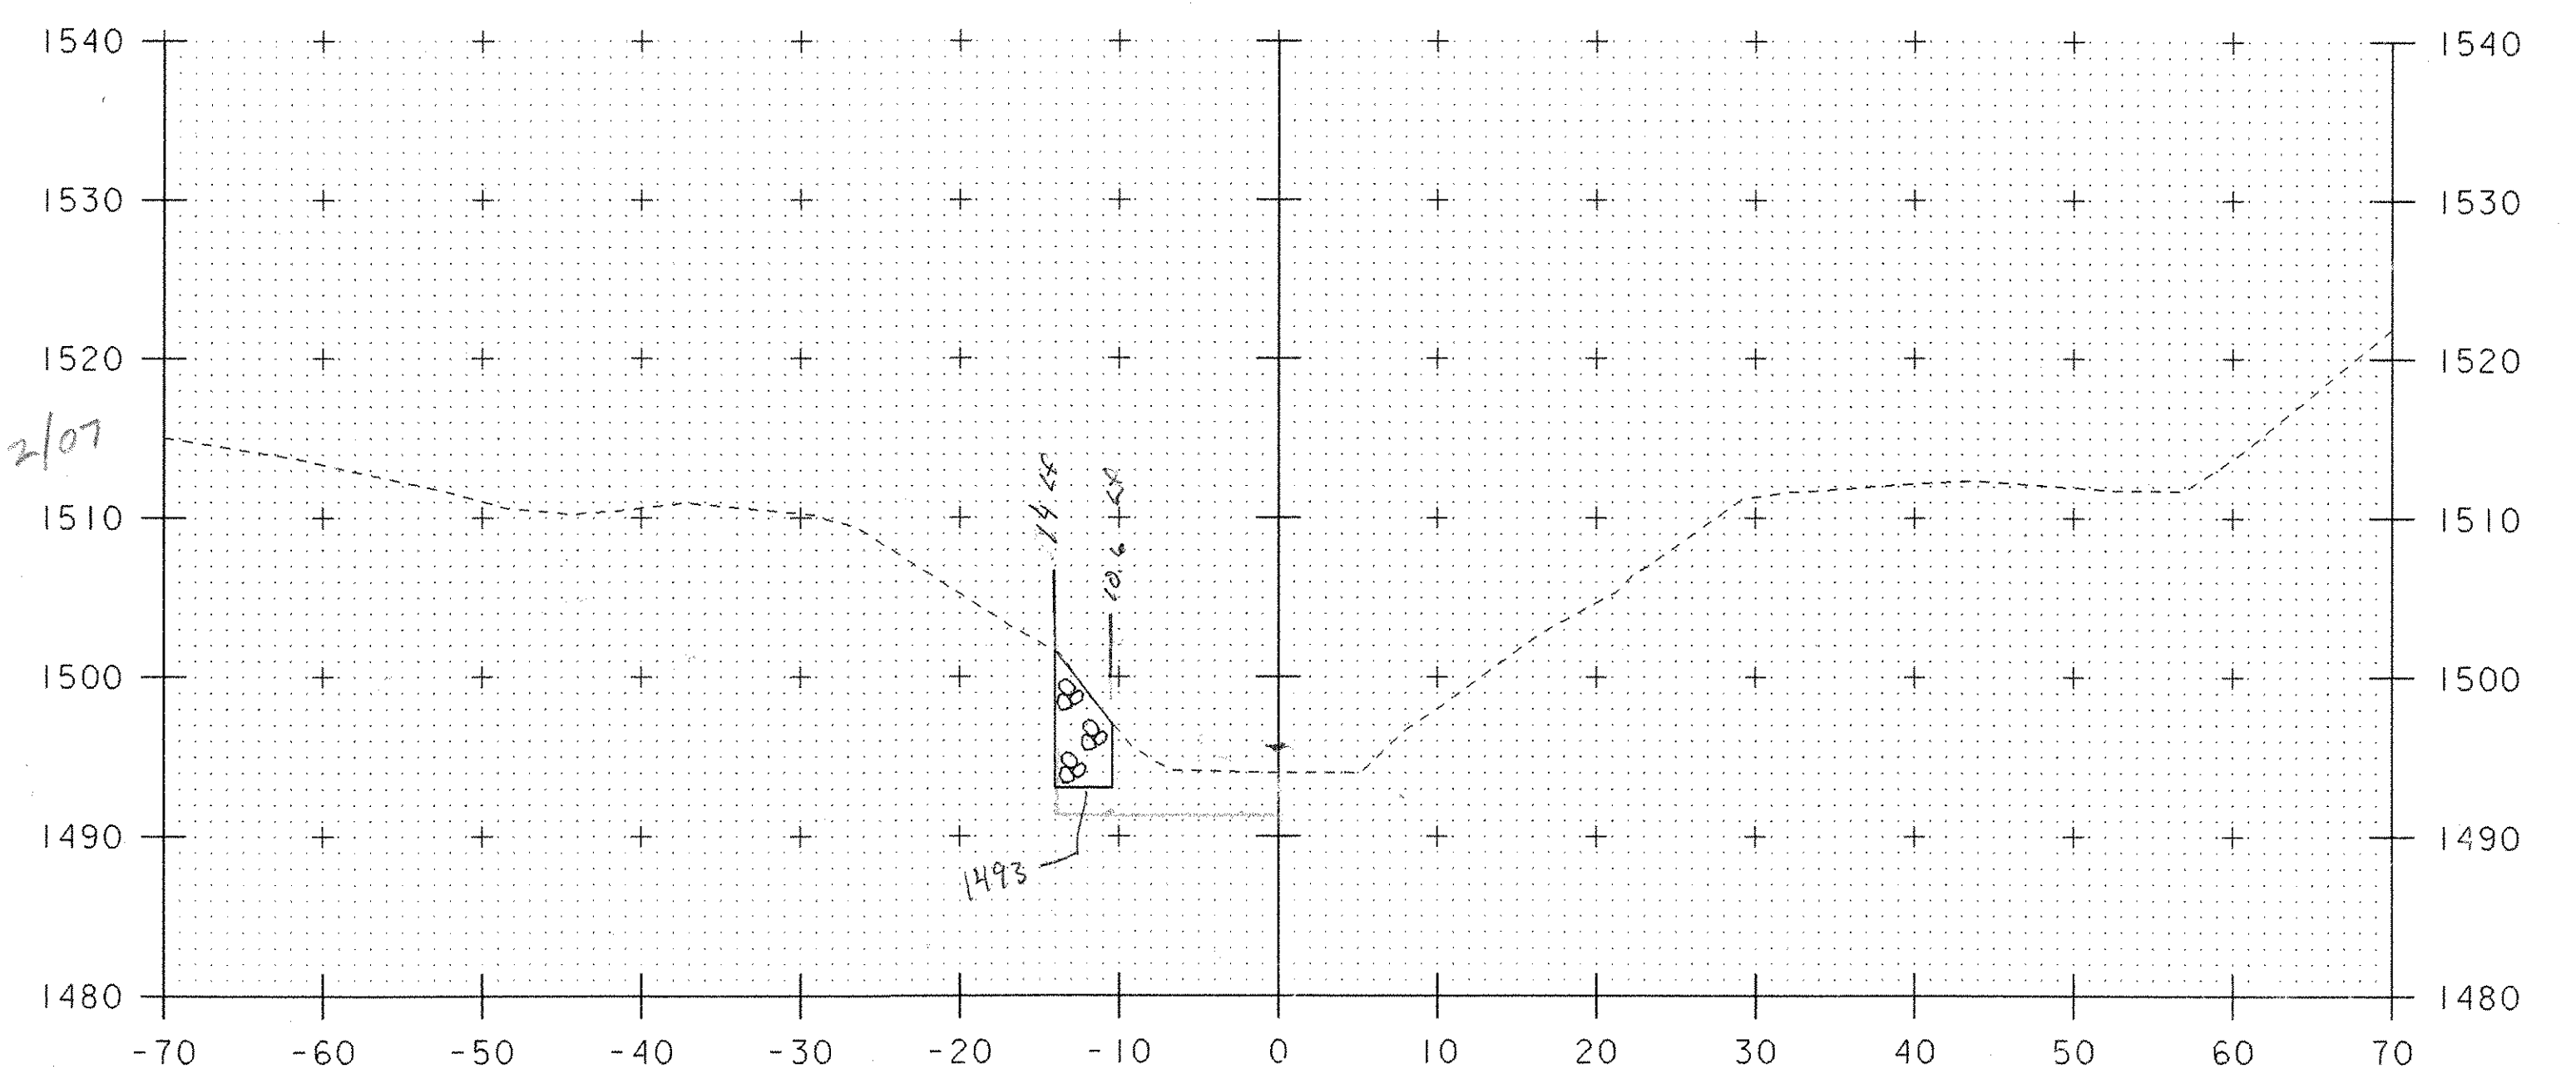

STA 13+00.00 LT
 END STONE FILL TYPE IV
 END GEOTEXTILE UNDER STONE FILL
 END GRUBBING MATERIAL
 END UNCLASSIFIED CHANNEL EXCAVATION

13+00

STA 12+98.00 RT
 END STONE FILL TYPE IV
 END GEOTEXTILE UNDER STONE FILL
 END GRUBBING MATERIAL
 END UNCLASSIFIED CHANNEL EXCAVATION

PROJECT: WHITINGHAM	PROJECT NO.: ST CULV (6)
DESIGN FILE NAME: s05c128/structures/s05c128xs.dgn	PLOT DATE: 27-JUN-2006
IPARM FILE NAME: s05c128ch3.i	DRAWN BY: E.L.RUSTAY
DESIGNED BY: E.L.RUSTAY	CHECKED BY: M.GAGULIC
SQUAD LEADER: C.P.WILLIAMS	SHEET: 12A OF 12
CHANNEL STA 12+00 - STA 12+75	

SCALE 1" = 10'-0"
 10 0 10