

TEMPORARY 4in YELLOW LINE (PAINT)
 DURABLE 4in YELLOW LINE (THERMOPLASTIC)

STA 18+50 TO 21+23 DOUBLE SOLID LT&RT
 STA 21+23 TO 23+81 SOLID LT&RT
 STA 24+05 DOUBLE SOLID LT
 STA 24+50 TO 26+55 DOUBLE SOLID LT&RT
 STA 26+78 DOUBLE SOLID RT
 STA 27+05 TO 27+90 DOUBLE SOLID LT&RT
 STA 28+13 DOUBLE SOLID LT
 STA 28+37 TO 34+00 SOLID LT&RT
 STA 30+90 DOUBLE SOLID RT
 (WITH CENTERLINE BREAKS FOR TOWN HIGHWAYS)

TEMPORARY 4in WHITE LINE (PAINT)
 DURABLE 4in WHITE LINE (THERMOPLASTIC)

STA 18+50 TO 34+00 SOLID LT&RT
 STA 19+10 TO 21+23 DOTTED RT
 STA 21+23 TO 23+81 SOLID RT
 (WITH EDGE LINE BREAKS FOR TOWN HIGHWAYS)

DURABLE LETTER OR SYMBOL (THERMOPLASTIC)

STA 21+23 RT "ONLY"
 STA 22+05 RT "ONLY"
 STA 22+87 RT "ONLY"
 STA 23+69 RT "STOP"
 STA 23+95 LT "STOP"
 STA 26+78 RT "STOP"
 STA 28+13 LT "STOP"
 STA 30+90 RT "STOP"

TEMPORARY LETTER OR SYMBOL (PAINT)


STA 22+05 RT "STOP"
 STA 23+69 RT "STOP"
 STA 23+95 LT "STOP"
 STA 26+78 RT "STOP"
 STA 28+13 LT "STOP"
 STA 30+90 RT "STOP"

DURABLE 8in YELLOW LINE (THERMOPLASTIC)

STA 18+50 TO 21+23 PAINTED ISLAND
 STA 24+05 PAINTED ISLAND LT
 STA 24+50 TO 26+55 PAINTED ISLAND
 STA 27+05 TO 27+90 PAINTED ISLAND

TEMPORARY 24in STOP BAR (PAINT)
 DURABLE 24in STOP BAR (THERMOPLASTIC)

STA 23+95 LT TH#122
 STA 26+78 RT TH#21
 STA 28+13 LT TH#59
 STA 30+90 RT ALLEN DRIVE





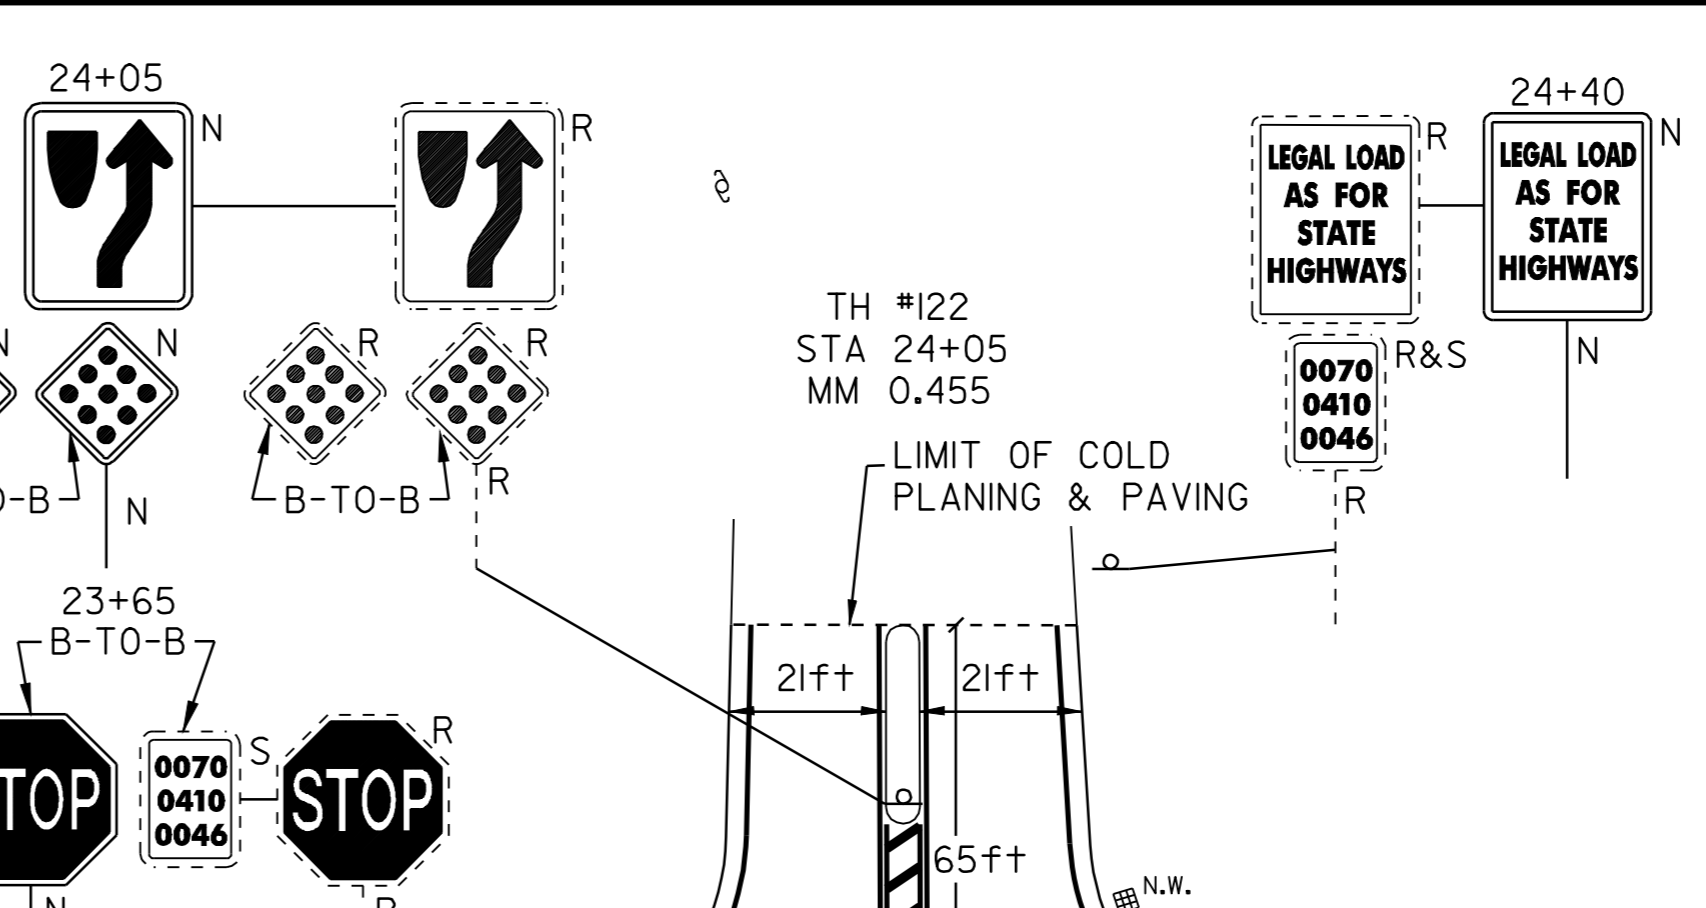


DITCHING LOCATIONS (REFER TO SHEET 8 FOR DETAILS)

STA 18+50 TO 19+60 RT
 STA 18+50 TO 21+50 LT

ADJUST ELEVATION OF VALVE BOX
 STA 30+72 RT

REMOVING SIGNS
 20

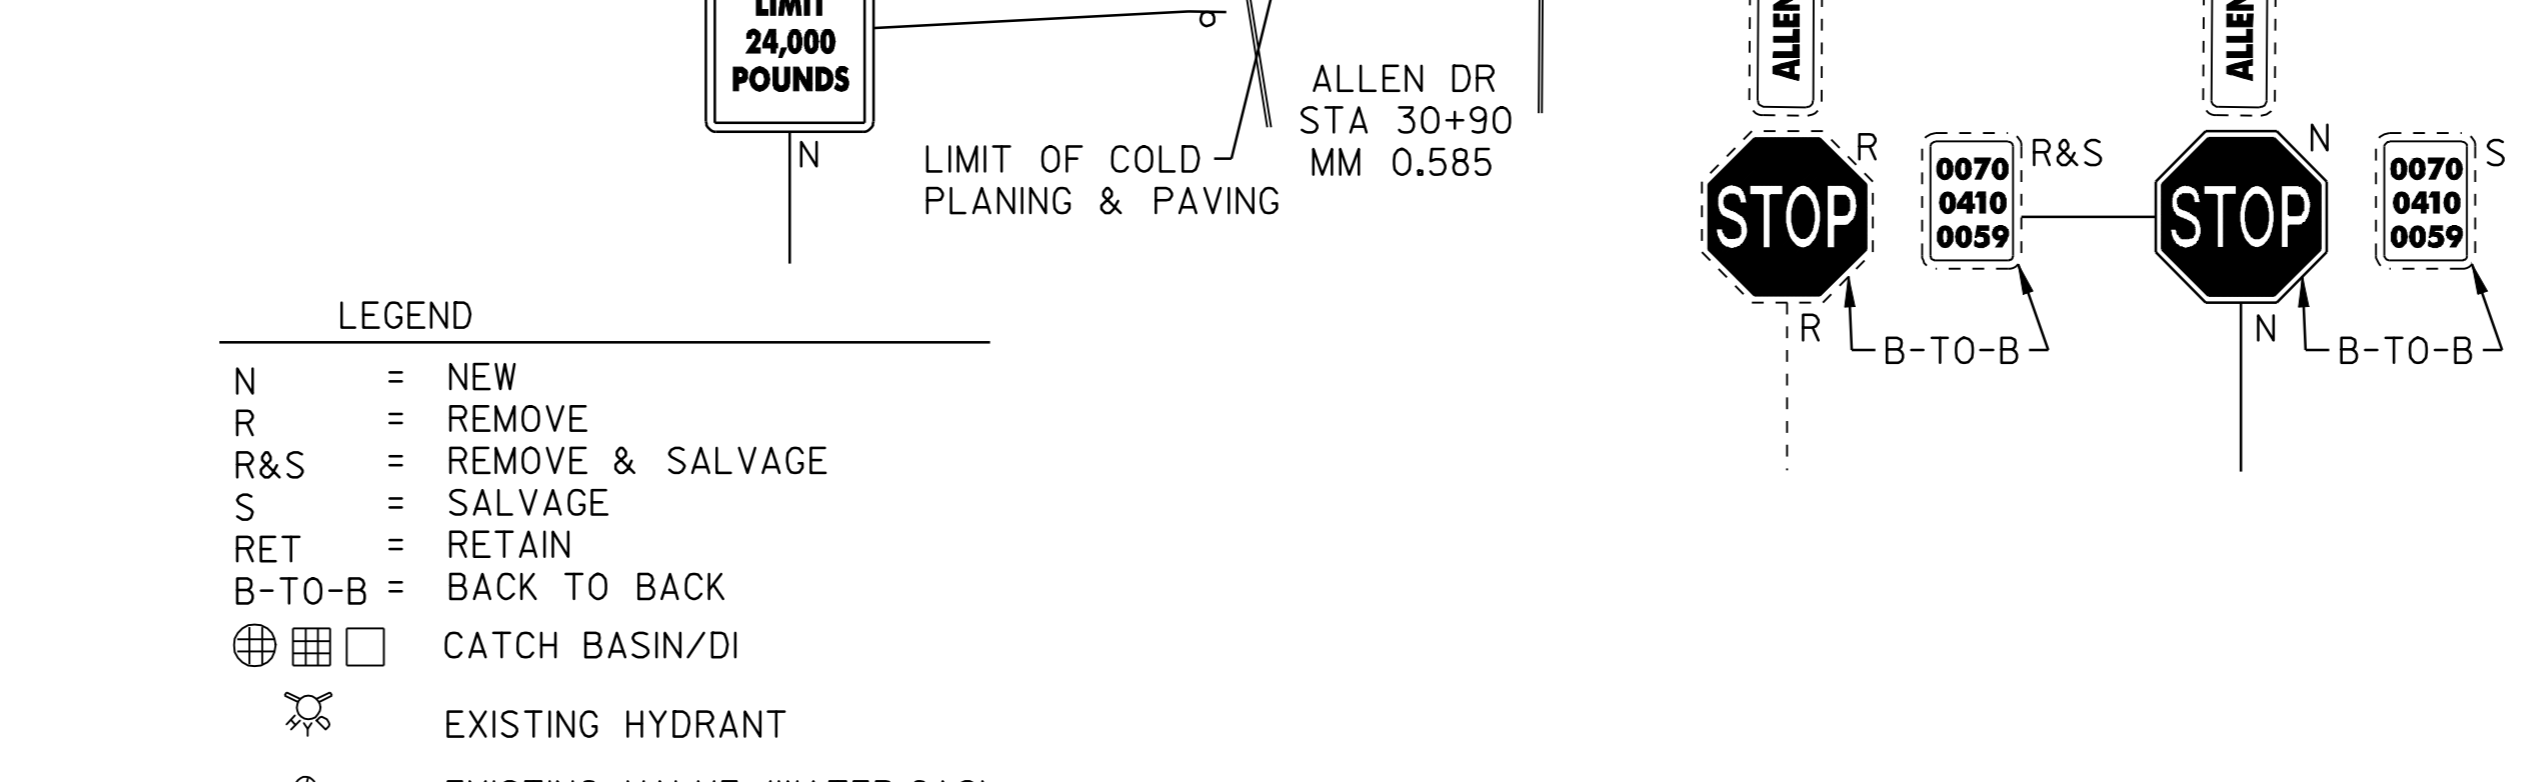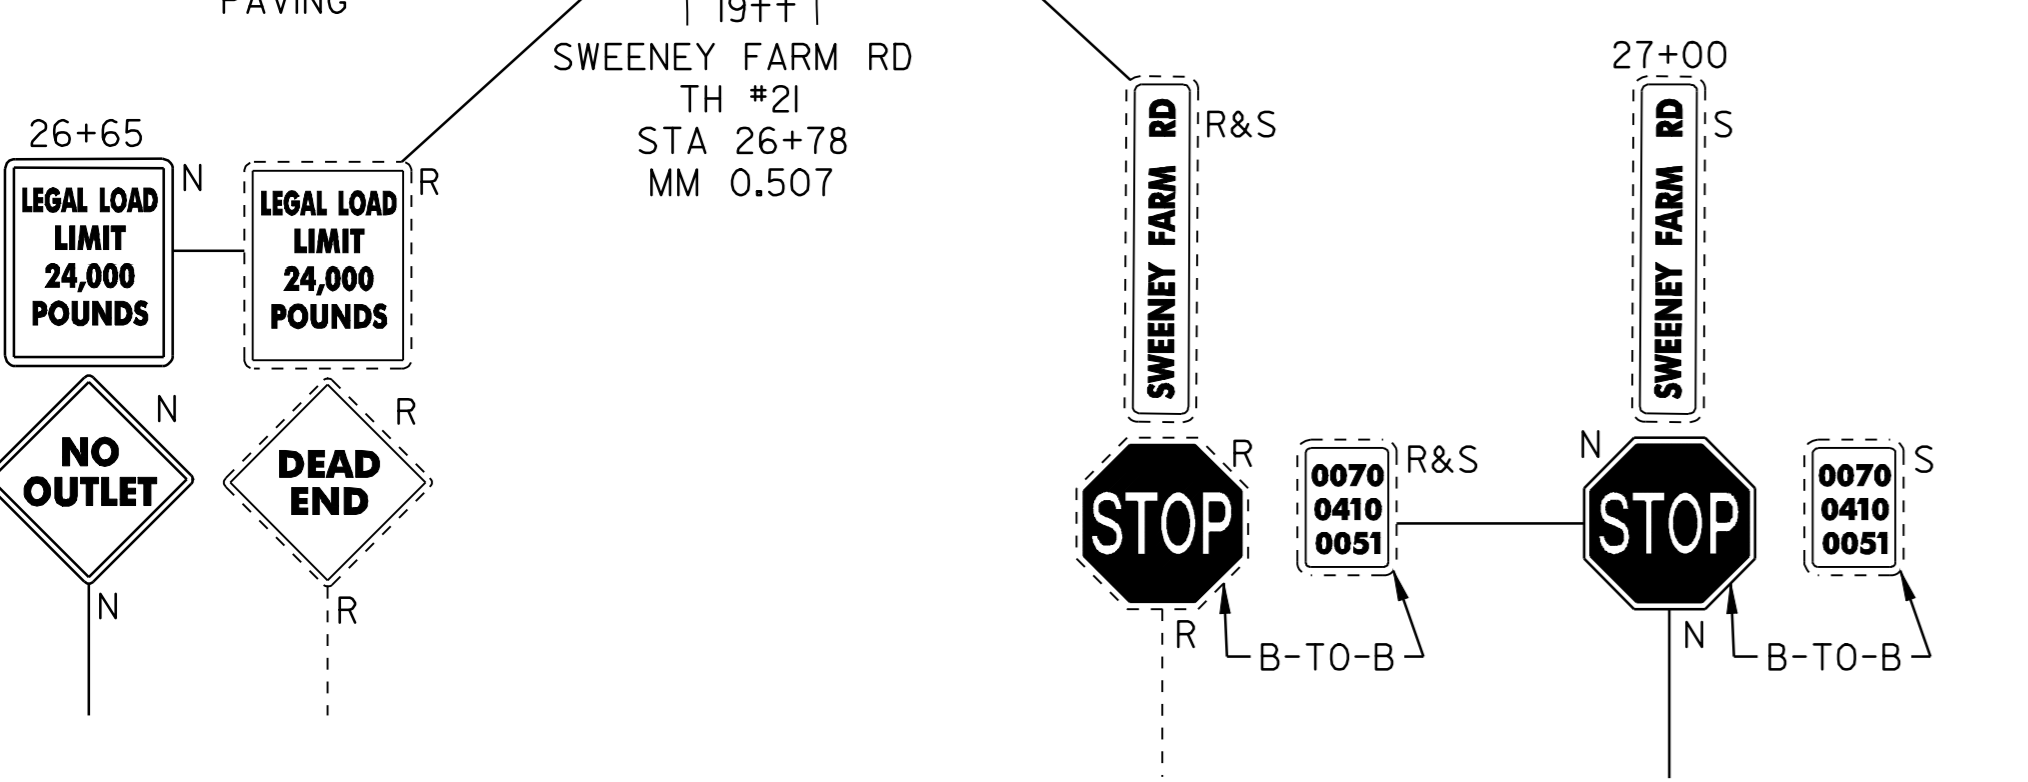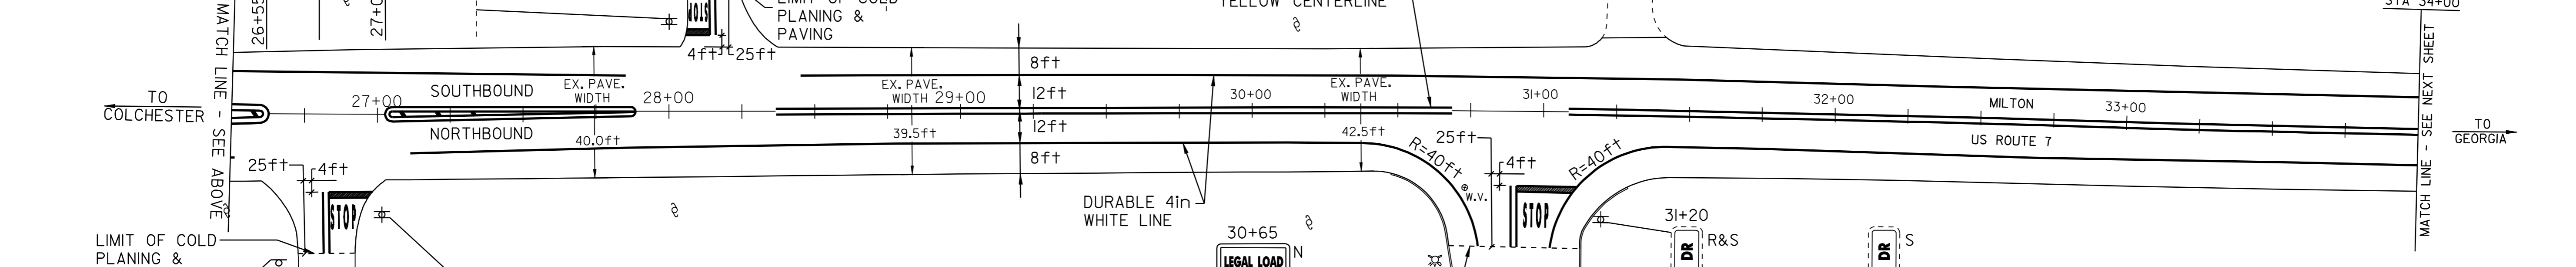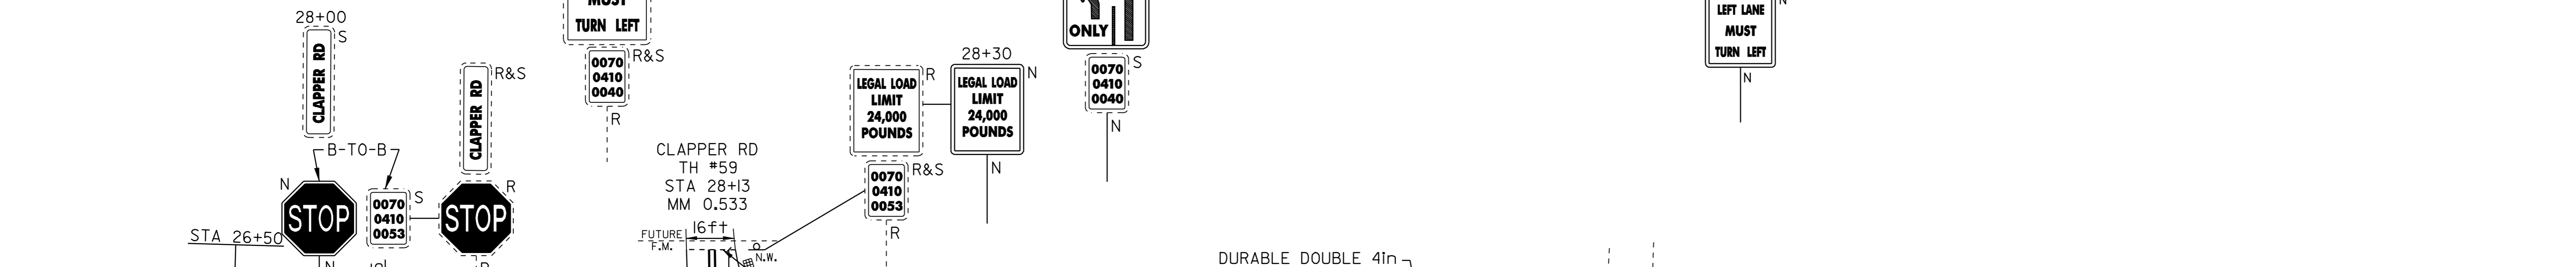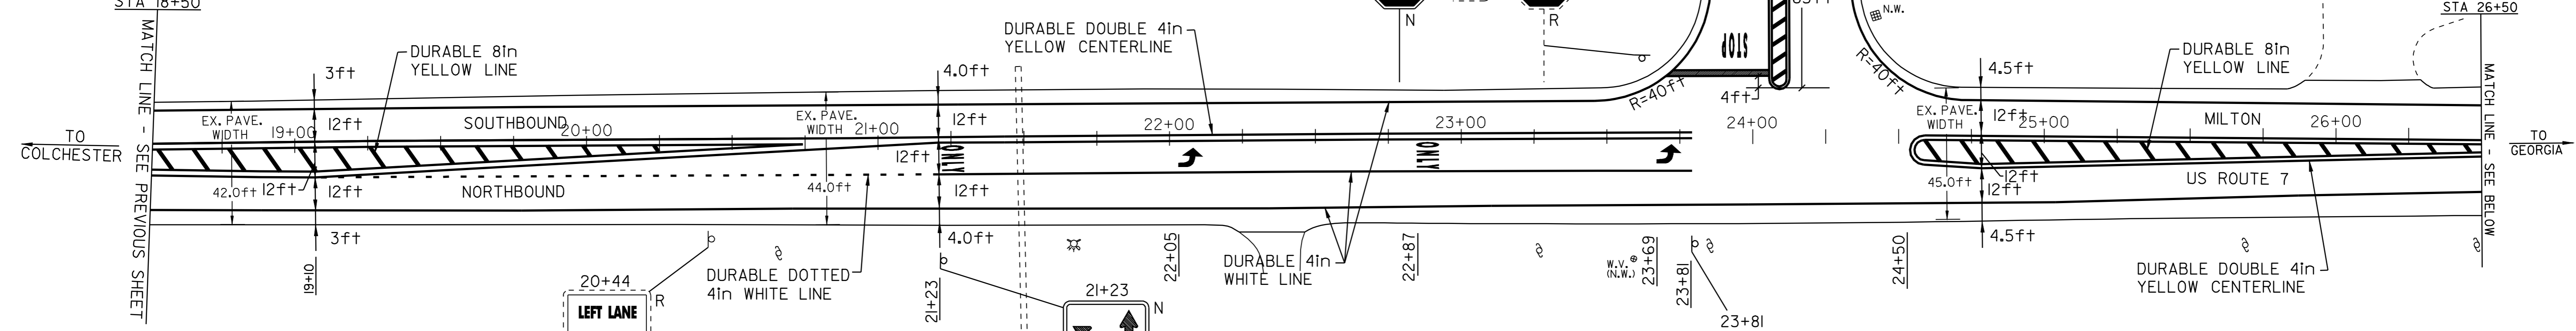

- LEGEND
- N = NEW
 - R = REMOVE
 - R&S = REMOVE & SALVAGE
 - S = SALVAGE
 - RET = RETAIN
 - B-T-O-B = BACK TO BACK
 - ⊕ □ CATCH BASIN/DI
 - ⊕ EXISTING HYDRANT
 - ⊕ EXISTING VALVE (WATER,GAS)
 - S.E.T EXISTING MANHOLE (SEWER,ELECTRIC,TEL.)
 - (N.W.) = NO WORK REQUIRED (TYP. FOR VALVES, M.H.'S, & C.B.'S WHERE NOTED)
 - ⊕ UTILITY POLE
 - ⊕ DRIVE

PAVING PROJECT LAYOUT SHEET #2

DESIGNED BY BCE/PJM DATE 8-06

DRAWN BY C.E.A., INC. DATE 8-06

DESIGN FILE NO. 05c158.dgn

PRF FILE 05c158p02.1 DATE PLOTTED 19-MAY-2009 12

PROJ. NAME **MILTON - GEORGIA**

PROJ. NO. **STP 2510(1)S**

SHEET **10** OF **44** SHEETS