



TEMPORARY 4in YELLOW LINE (PAINT)  
 DURABLE 4in YELLOW LINE (THERMOPLASTIC)

STA 97+00 TO 97+35 SOLID LT & DASHED RT  
 STA 97+35 TO 98+85 DASHED  
 STA 98+85 TO 105+88 DASHED LT & SOLID RT  
 STA 105+88 TO 113+00 SOLID LT&RT

TEMPORARY 4in WHITE LINE (PAINT)  
 DURABLE 4in WHITE LINE (THERMOPLASTIC)

STA 97+00 TO 113+00 SOLID LT&RT

DITCHING LOCATIONS (REFER TO SHEET 8 FOR DETAILS)  
 STA 97+00 TO 103+50 LT

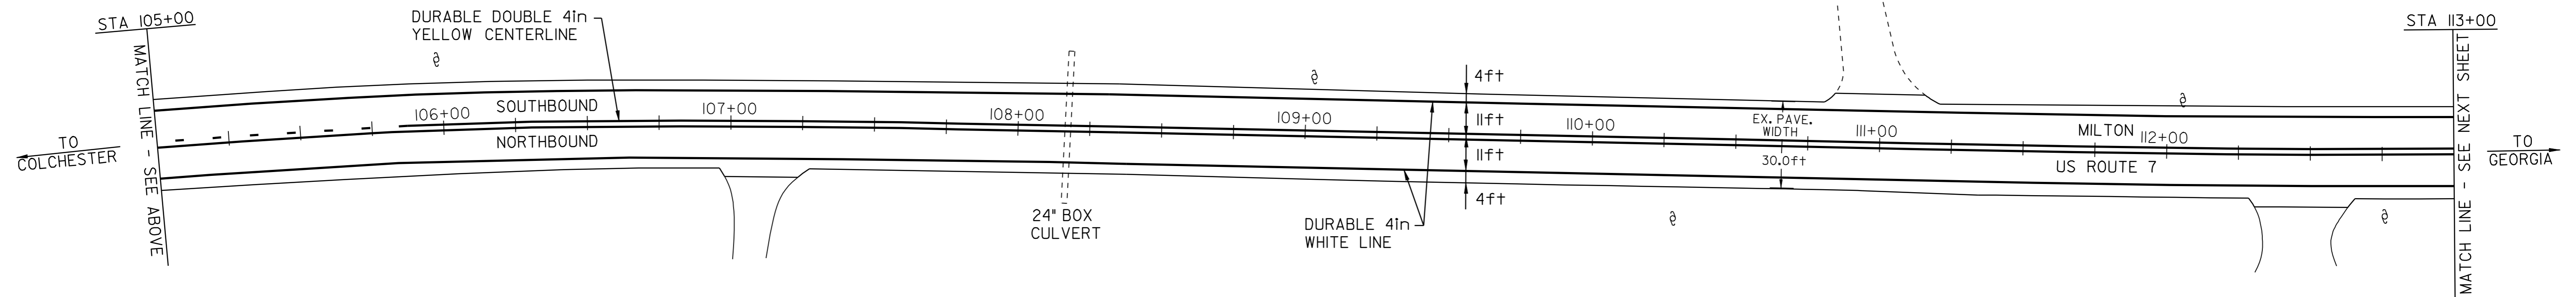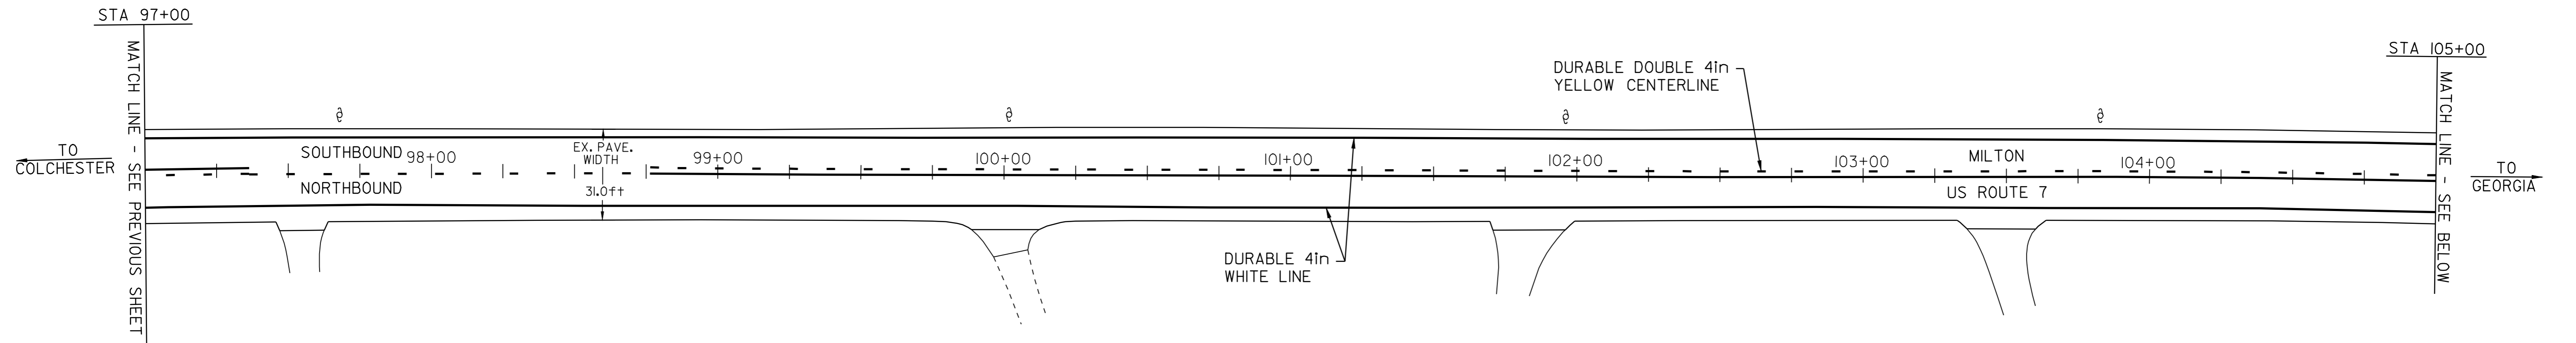

LEGEND

- N = NEW
- R = REMOVE
- R&S = REMOVE & SALVAGE
- S = SALVAGE
- RET = RETAIN
- B-TO-B = BACK TO BACK
- ⊕ □ CATCH BASIN/DI
- ⊗ EXISTING HYDRANT
- ⊙ EXISTING VALVE (WATER,GAS)
- <sub>S,E,T</sub> EXISTING MANHOLE (SEWER,ELECTRIC,TEL.)
- (N.W.) = NO WORK REQUIRED (TYP. FOR VALVES, M.H.'S, & C.B.'S WHERE NOTED)
- ⊘ UTILITY POLE
- DRIVE

**PAVING  
 PROJECT  
 LAYOUT  
 SHEET #7**

DESIGNED BY BCE/PJM DATE 8-06  
 DRAWN BY C.E.A., INC. DATE 8-06  
 DESIGN FILE NO. 05c158.dgn  
 PRF FILE 05c158p07.1 DATE PLOTTED 19-MAY-2009 12  
 PROJ. NAME **MILTON - GEORGIA**  
 PROJ. NO. **STP 2510(1)S**  
 SHEET **15** OF **44** SHEETS