

TEMPORARY 4in YELLOW LINE (PAINT)  
 DURABLE 4in WHITE LINE (THERMOPLASTIC)  
 STA 145+00 TO 161+00 SOLID LT&RT  
 STA 147+94 DOUBLE SOLID LT  
 (WITH CENTERLINE BREAKS FOR TOWN HIGHWAYS)


TEMPORARY 4in WHITE LINE (PAINT)  
 DURABLE 4in WHITE LINE (THERMOPLASTIC)  
 STA 145+00 TO 161+00 SOLID LT&RT  
 (WITH EDGELINE BREAKS FOR TOWN HIGHWAYS)

TEMPORARY LETTER OR SYMBOL (PAINT)  
 DURABLE LETTER OR SYMBOL (THERMOPLASTIC)  
 STA 147+94 LT "STOP"

TEMPORARY 24in STOP BAR (PAINT)  
 DURABLE 24in STOP BAR (THERMOPLASTIC)  
 STA 147+94 LT TH#146

REMOVING SIGNS  
 2

CHANGE ELEVATION OF SEWER MANHOLE  
 STA 147+83 LT

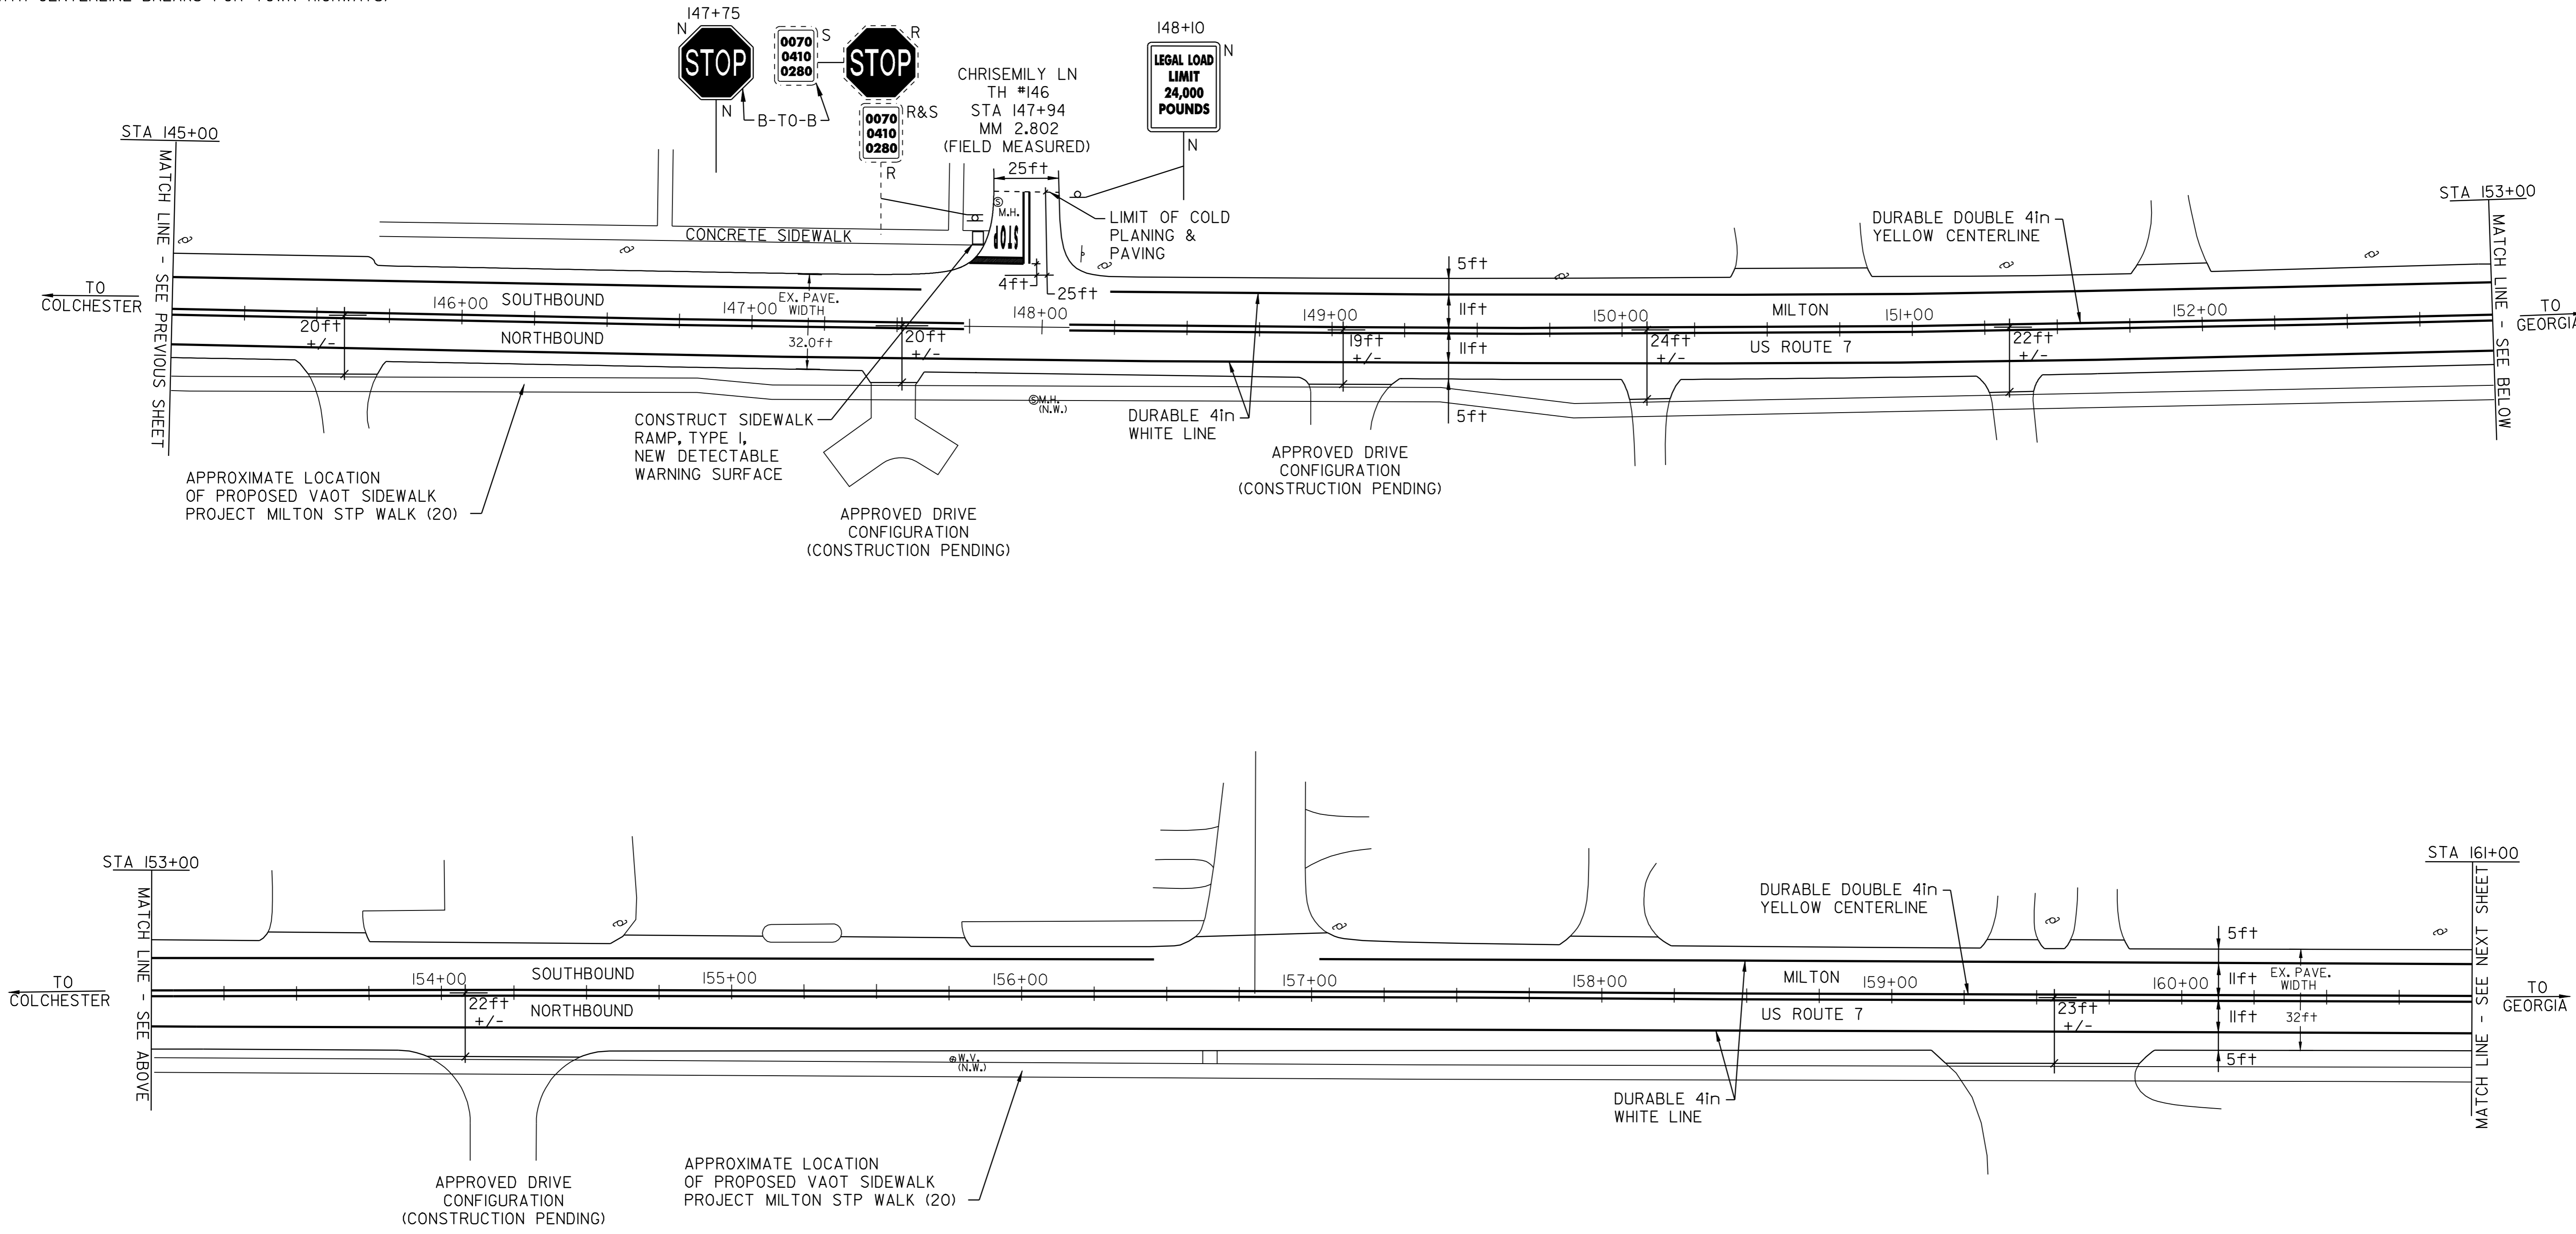

LEGEND

N	=	NEW
R	=	REMOVE
R&S	=	REMOVE & SALVAGE
S	=	SALVAGE
RET	=	RETAIN
B-TO-B	=	BACK TO BACK
⊕ ⊞ ⊠	=	CATCH BASIN/DI
⊗	=	EXISTING HYDRANT
⊙	=	EXISTING VALVE (WATER,GAS)
○ <sub>S,E,T</sub>	=	EXISTING MANHOLE (SEWER,ELECTRIC,TEL.)
(N.W.)	=	NO WORK REQUIRED (TYP. FOR VALVES, M.H.'S, & C.B.'S WHERE NOTED)
⊘	=	UTILITY POLE
---	=	DRIVE

## PAVING PROJECT LAYOUT SHEET #10

DESIGNED BY	BCE/PJM	DATE	8-06
DRAWN BY	C.E.A., INC.	DATE	8-06
DESIGN FILE NO.	05cl58.dgn		
PRF FILE	05cl58pl0.l	DATE PLOTTED	19-MAY-2009 12
PROJ. NAME	<b>MILTON - GEORGIA</b>		
PROJ. NO.	<b>STP 2510(1)S</b>		
SHEET	18	OF	44 SHEETS