

TEMPORARY 4in YELLOW LINE (PAINT)
 DURABLE 4in YELLOW LINE (THERMOPLASTIC)
 STA 161+00 TO 177+00 SOLID LT&RT
 STA 165+00 DOUBLE SOLID LT
 (WITH CENTERLINE BREAKS FOR TOWN HIGHWAYS)



TEMPORARY LETTER OR SYMBOL (PAINT)
 DURABLE LETTER OR SYMBOL (THERMOPLASTIC)
 STA 165+00 LT "STOP"

TEMPORARY 4in WHITE LINE (THERMOPLASTIC)
 STA 161+00 TO 177+00 SOLID LT&RT
 (WITH EDGE LINE BREAKS FOR TOWN HIGHWAYS)

TEMPORARY 24in STOP BAR (PAINT)
 DURABLE 24in STOP BAR (THERMOPLASTIC)
 STA 165+00 LT TH#90

REMOVING SIGNS
 3

CHANGE ELEVATION OF SEWER MANHOLE
 STA 165+00 LT

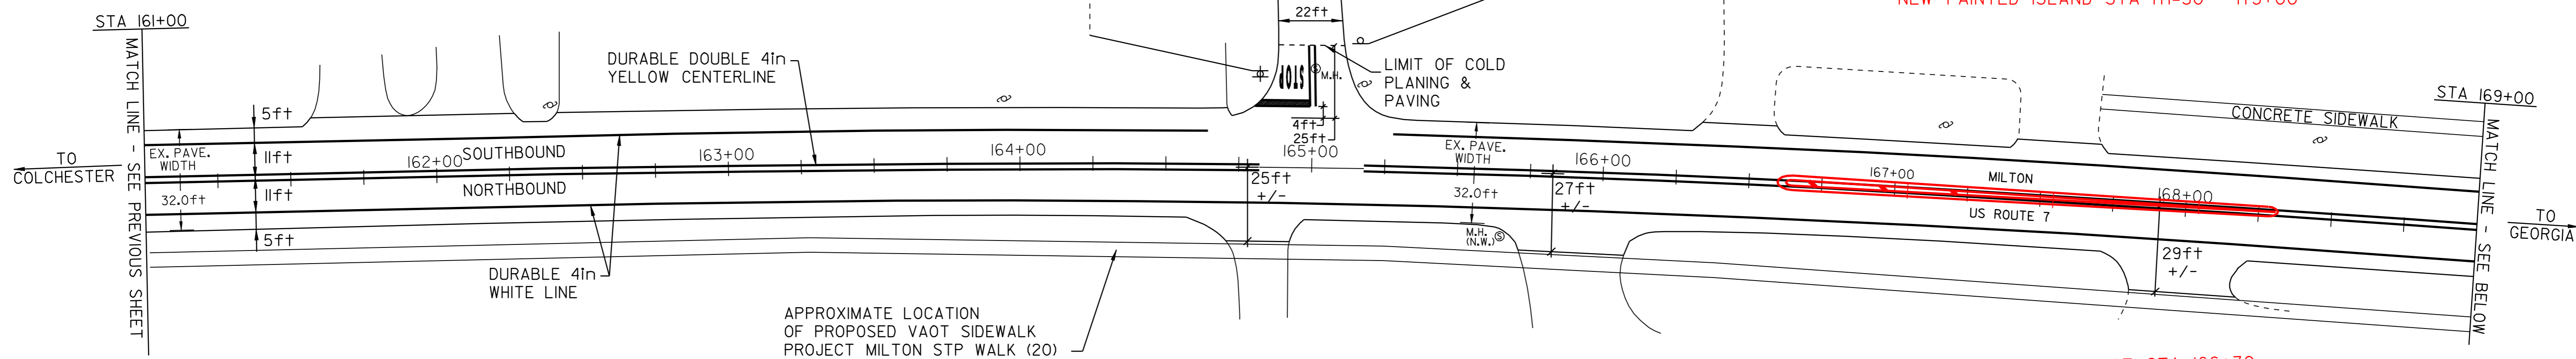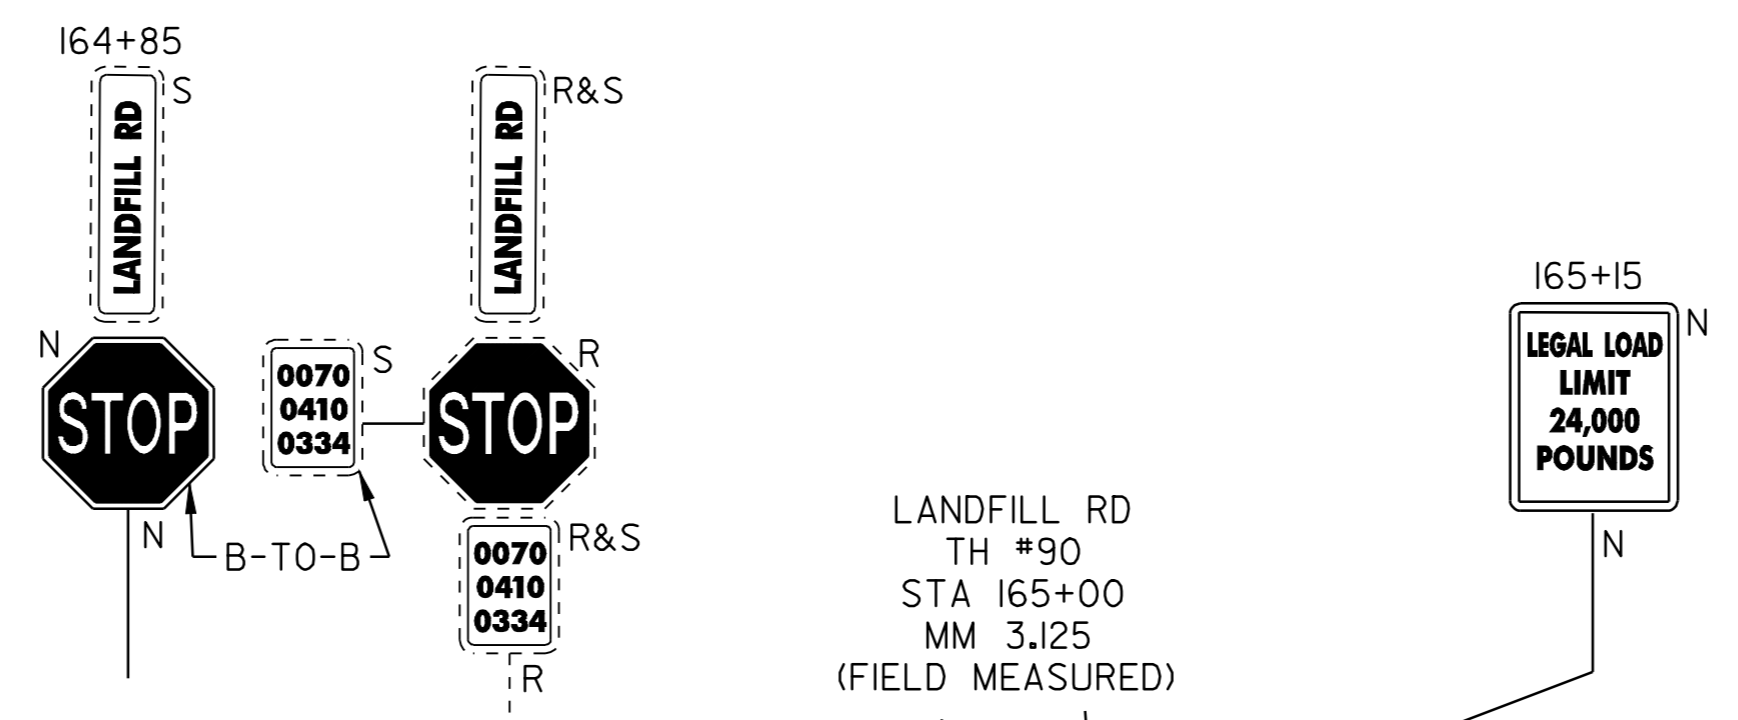

NEW PAINTED ISLAND STA 171=30 - 173+00


BEGIN ISLAND W/ 8" YELLOW LINE AT STA 166+30
 END AT STA 168+50

STA 171+75 TO 173+75 LT
 REMOVAL AND DISPOSAL OF GUARD RAIL

STA 171+75 LT
 INSTALL ANCHOR FOR STEEL BEAM RAIL

STA 171+75 TO 173+75 LT
 INSTALL STEEL BEAM GUARD RAIL, GALVANIZED w/8 FOOT POSTS

STA 173+75 LT
 INSTALL ANCHOR FOR STEEL BEAM RAIL

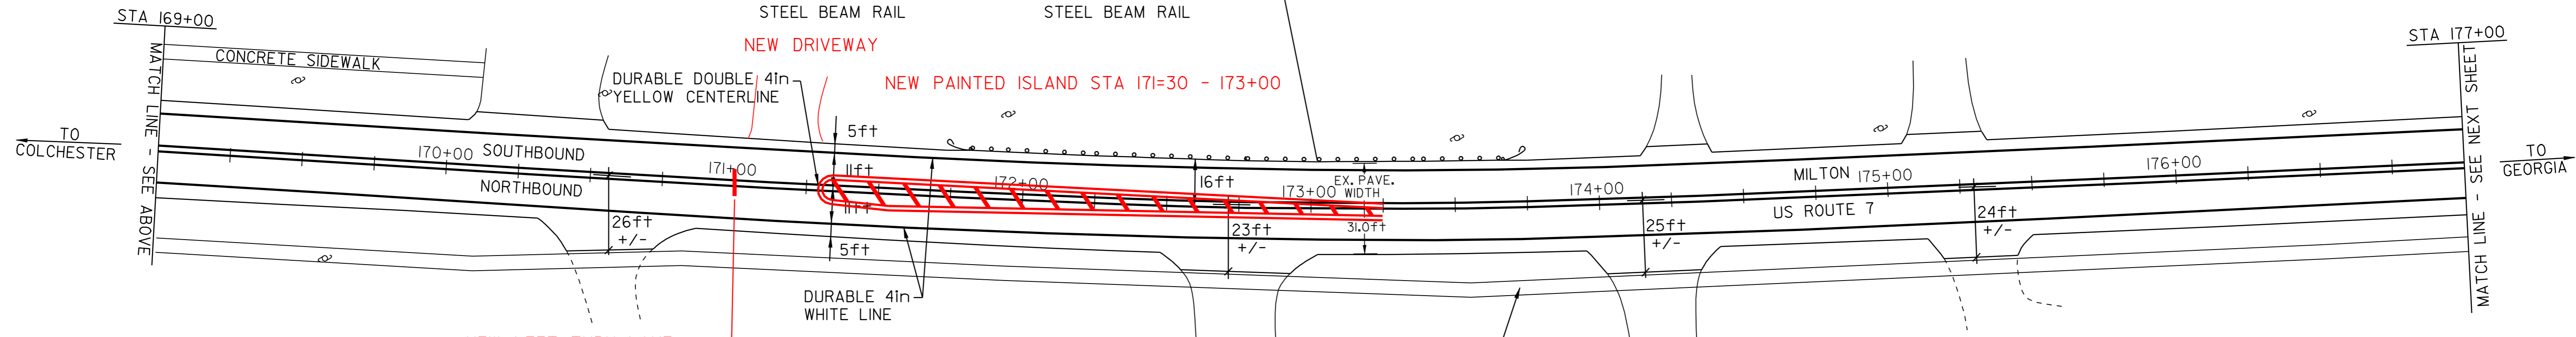

- LEGEND
- N = NEW
 - R = REMOVE
 - R&S = REMOVE & SALVAGE
 - S = SALVAGE
 - RET = RETAIN
 - B-TO-B = BACK TO BACK
 - ⊕ □ CATCH BASIN/DI
 - ⊗ EXISTING HYDRANT
 - ⊙ EXISTING VALVE (WATER,GAS)
 - S,E,T EXISTING MANHOLE (SEWER,ELECTRIC,TEL.)
 - (N.W.) = NO WORK REQUIRED (TYP. FOR VALVES, M.H.'S, & C.B.'S WHERE NOTED)
 - ⊕ UTILITY POLE
 - DRIVE

ANCHOR FOR STEEL BEAM RAIL
 STA 171+75 LT
 STA 173+75 LT

REMOVAL AND DISPOSAL OF GUARD RAIL
 STA 171+75 TO 173+75 LT

STEEL BEAM GUARD RAIL, GALVANIZED w/8 FOOT POSTS
 STA 171+75 TO 173+75 LT

PAVING PROJECT LAYOUT SHEET #11

DESIGNED BY	BCE/PJM	DATE	8-06
DRAWN BY	C.E.A., INC.	DATE	8-06
DESIGN FILE NO.	05cl58.dgn		
PRF FILE	05cl58pl1	DATE PLOTTED	19-MAY-2009 12
PROJ. NAME	MILTON - GEORGIA		
PROJ. NO.	STP 2510(1)S		
SHEET	19	OF	44 SHEETS