

TEMPORARY 4in YELLOW LINE (PAINT)  
 DURABLE 4in YELLOW LINE (THERMOPLASTIC)  
 STA 241+00 TO 257+00 SOLID LT&RT  
 STA 250+06 DOUBLE SOLID LT  
 STA 255+46 DOUBLE SOLID RT  
 (WITH CENTERLINE BREAKS FOR TOWN HIGHWAYS)

TEMPORARY 4in WHITE LINE (PAINT)  
 DURABLE 4in WHITE LINE (THERMOPLASTIC)  
 STA 241+00 TO 257+00 SOLID LT&RT  
 (WITH EDGELINE BREAKS FOR TOWN HIGHWAYS)

TEMPORARY LETTER OR SYMBOL (PAINT)  
 DURABLE LETTER OR SYMBOL (THERMOPLASTIC)  
 STA 250+06 LT "STOP"  
 STA 255+46 RT "STOP"


TEMPORARY 24in STOP BAR (PAINT)  
 DURABLE 24in STOP BAR (THERMOPLASTIC)  
 STA 250+06 LT TH #72  
 STA 255+46 RT TH #31

REMOVING SIGNS  
 6

CHANGE ELEVATION OF D.I.'S, C.B.'S, OR M.H.'S  
 STA 249+07 RT  
 STA 250+50 RT  
 STA 251+70 RT  
 STA 255+30 RT

TEMPORARY CROSSWALK (PAINT)  
 DURABLE CROSSWALK (TYPE I TAPE)  
 (REFER TO DETAIL ON SHEET 43)  
 STA 255+46 RT TH #31

DITCHING LOCATIONS (REFER TO SHEET 8 FOR DETAILS)  
 STA 243+45 TO 247+90 LT  
 STA 249+75 LT

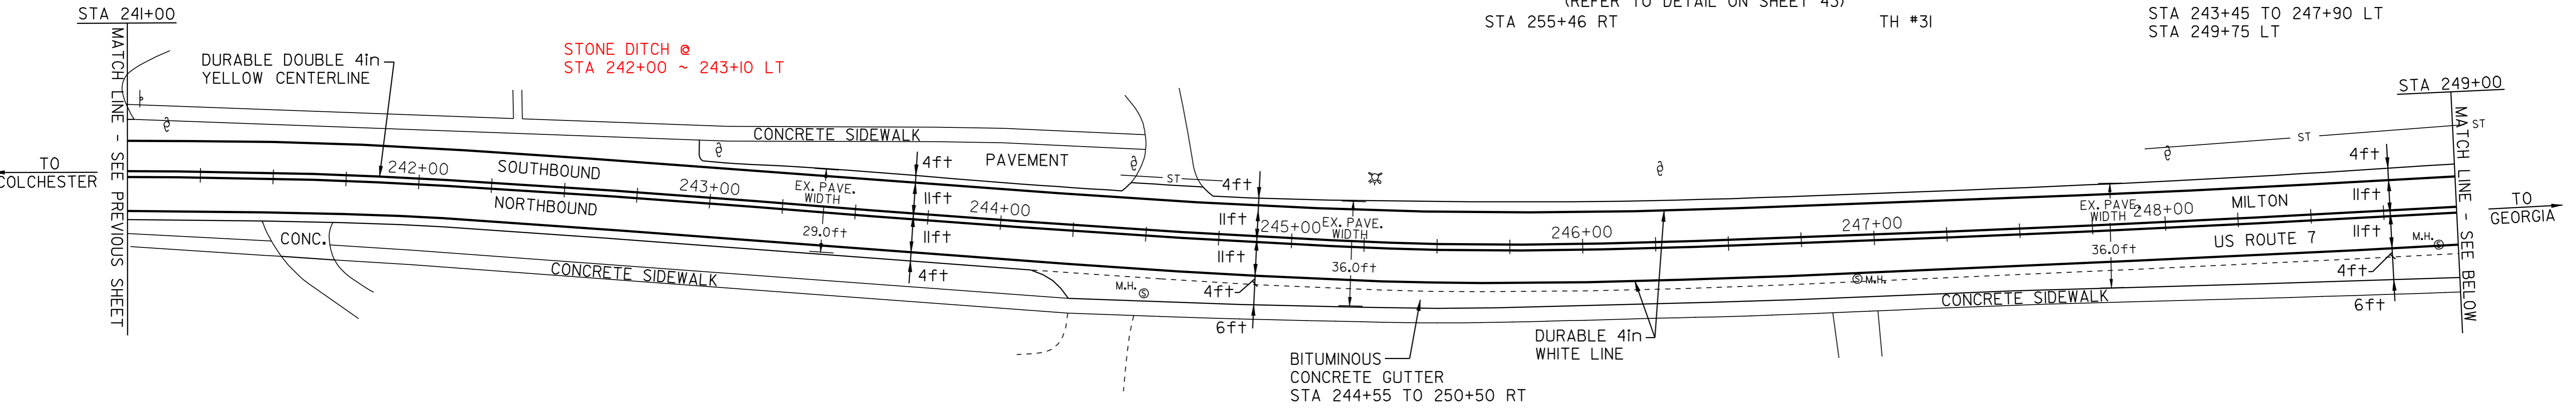


RELOCATE MAILBOX, MULTIPLE SUPPORT  
 STA 249+52 RT - 3

BITUMINOUS CONCRETE GUTTER (SEE DETAIL, SHEET 3)  
 STA 244+55 TO 250+50 RT

ADJUST ELEVATION OF VALVE BOX  
 STA 250+00 LT - 3

CHANGE ELEVATION OF SEWER MANHOLE  
 STA 244+50 RT  
 STA 246+92 RT  
 STA 248+94 RT  
 STA 250+19 LT  
 STA 251+77 RT  
 STA 255+20 RT  
 STA 255+50 RT - 2

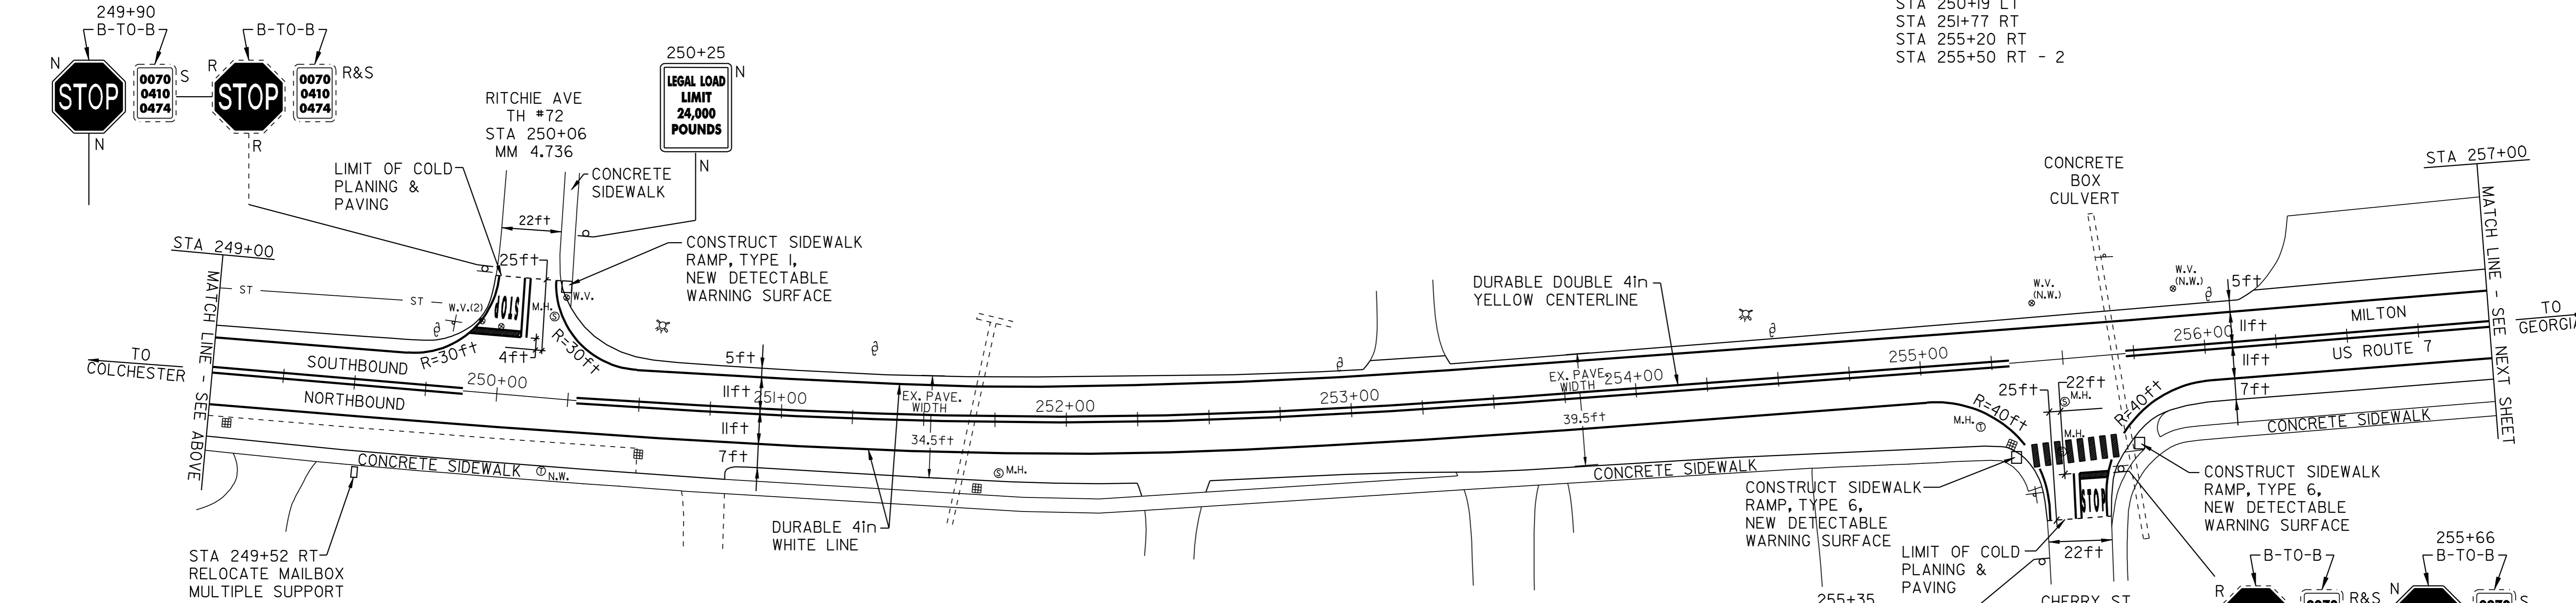

- LEGEND**
- N = NEW
  - R = REMOVE
  - R&S = REMOVE & SALVAGE
  - S = SALVAGE
  - RET = RETAIN
  - B-TO-B = BACK TO BACK
  - ⊕ □ CATCH BASIN/DI
  - ⊗ EXISTING HYDRANT
  - ⊙ EXISTING VALVE (WATER,GAS)
  - <sub>S,E,T</sub> EXISTING MANHOLE (SEWER,ELECTRIC,TEL.)
  - (N.W.) = NO WORK REQUIRED (TYP. FOR VALVES, M.H.'S, & C.B.'S WHERE NOTED)
  - ⊘ UTILITY POLE
  - ⌒ DRIVE

## PAVING PROJECT LAYOUT SHEET #16

DESIGNED BY	BCE/PJM	DATE	8-06
DRAWN BY	C.E.A., INC.	DATE	8-06
DESIGN FILE NO.	05c158.dgn		
PRF FILE	05c158pl6.l	DATE PLOTTED	19-MAY-2009 12
PROJ. NAME	MILTON - GEORGIA		
PROJ. NO.	STP 2510(1)S		
SHEET	24	OF	44 SHEETS