


TEMPORARY 4in YELLOW LINE (PAINT)
 DURABLE 4in YELLOW LINE (THERMOPLASTIC)
 STA 273+25 TO 289+43 SOLID LT&RT
 STA 289+43 TO 297+00 SOLID LT & DASHED RT

TEMPORARY 4in WHITE LINE (PAINT)
 DURABLE 4in WHITE LINE (THERMOPLASTIC)
 STA 273+25 TO 297+00 SOLID LT&RT

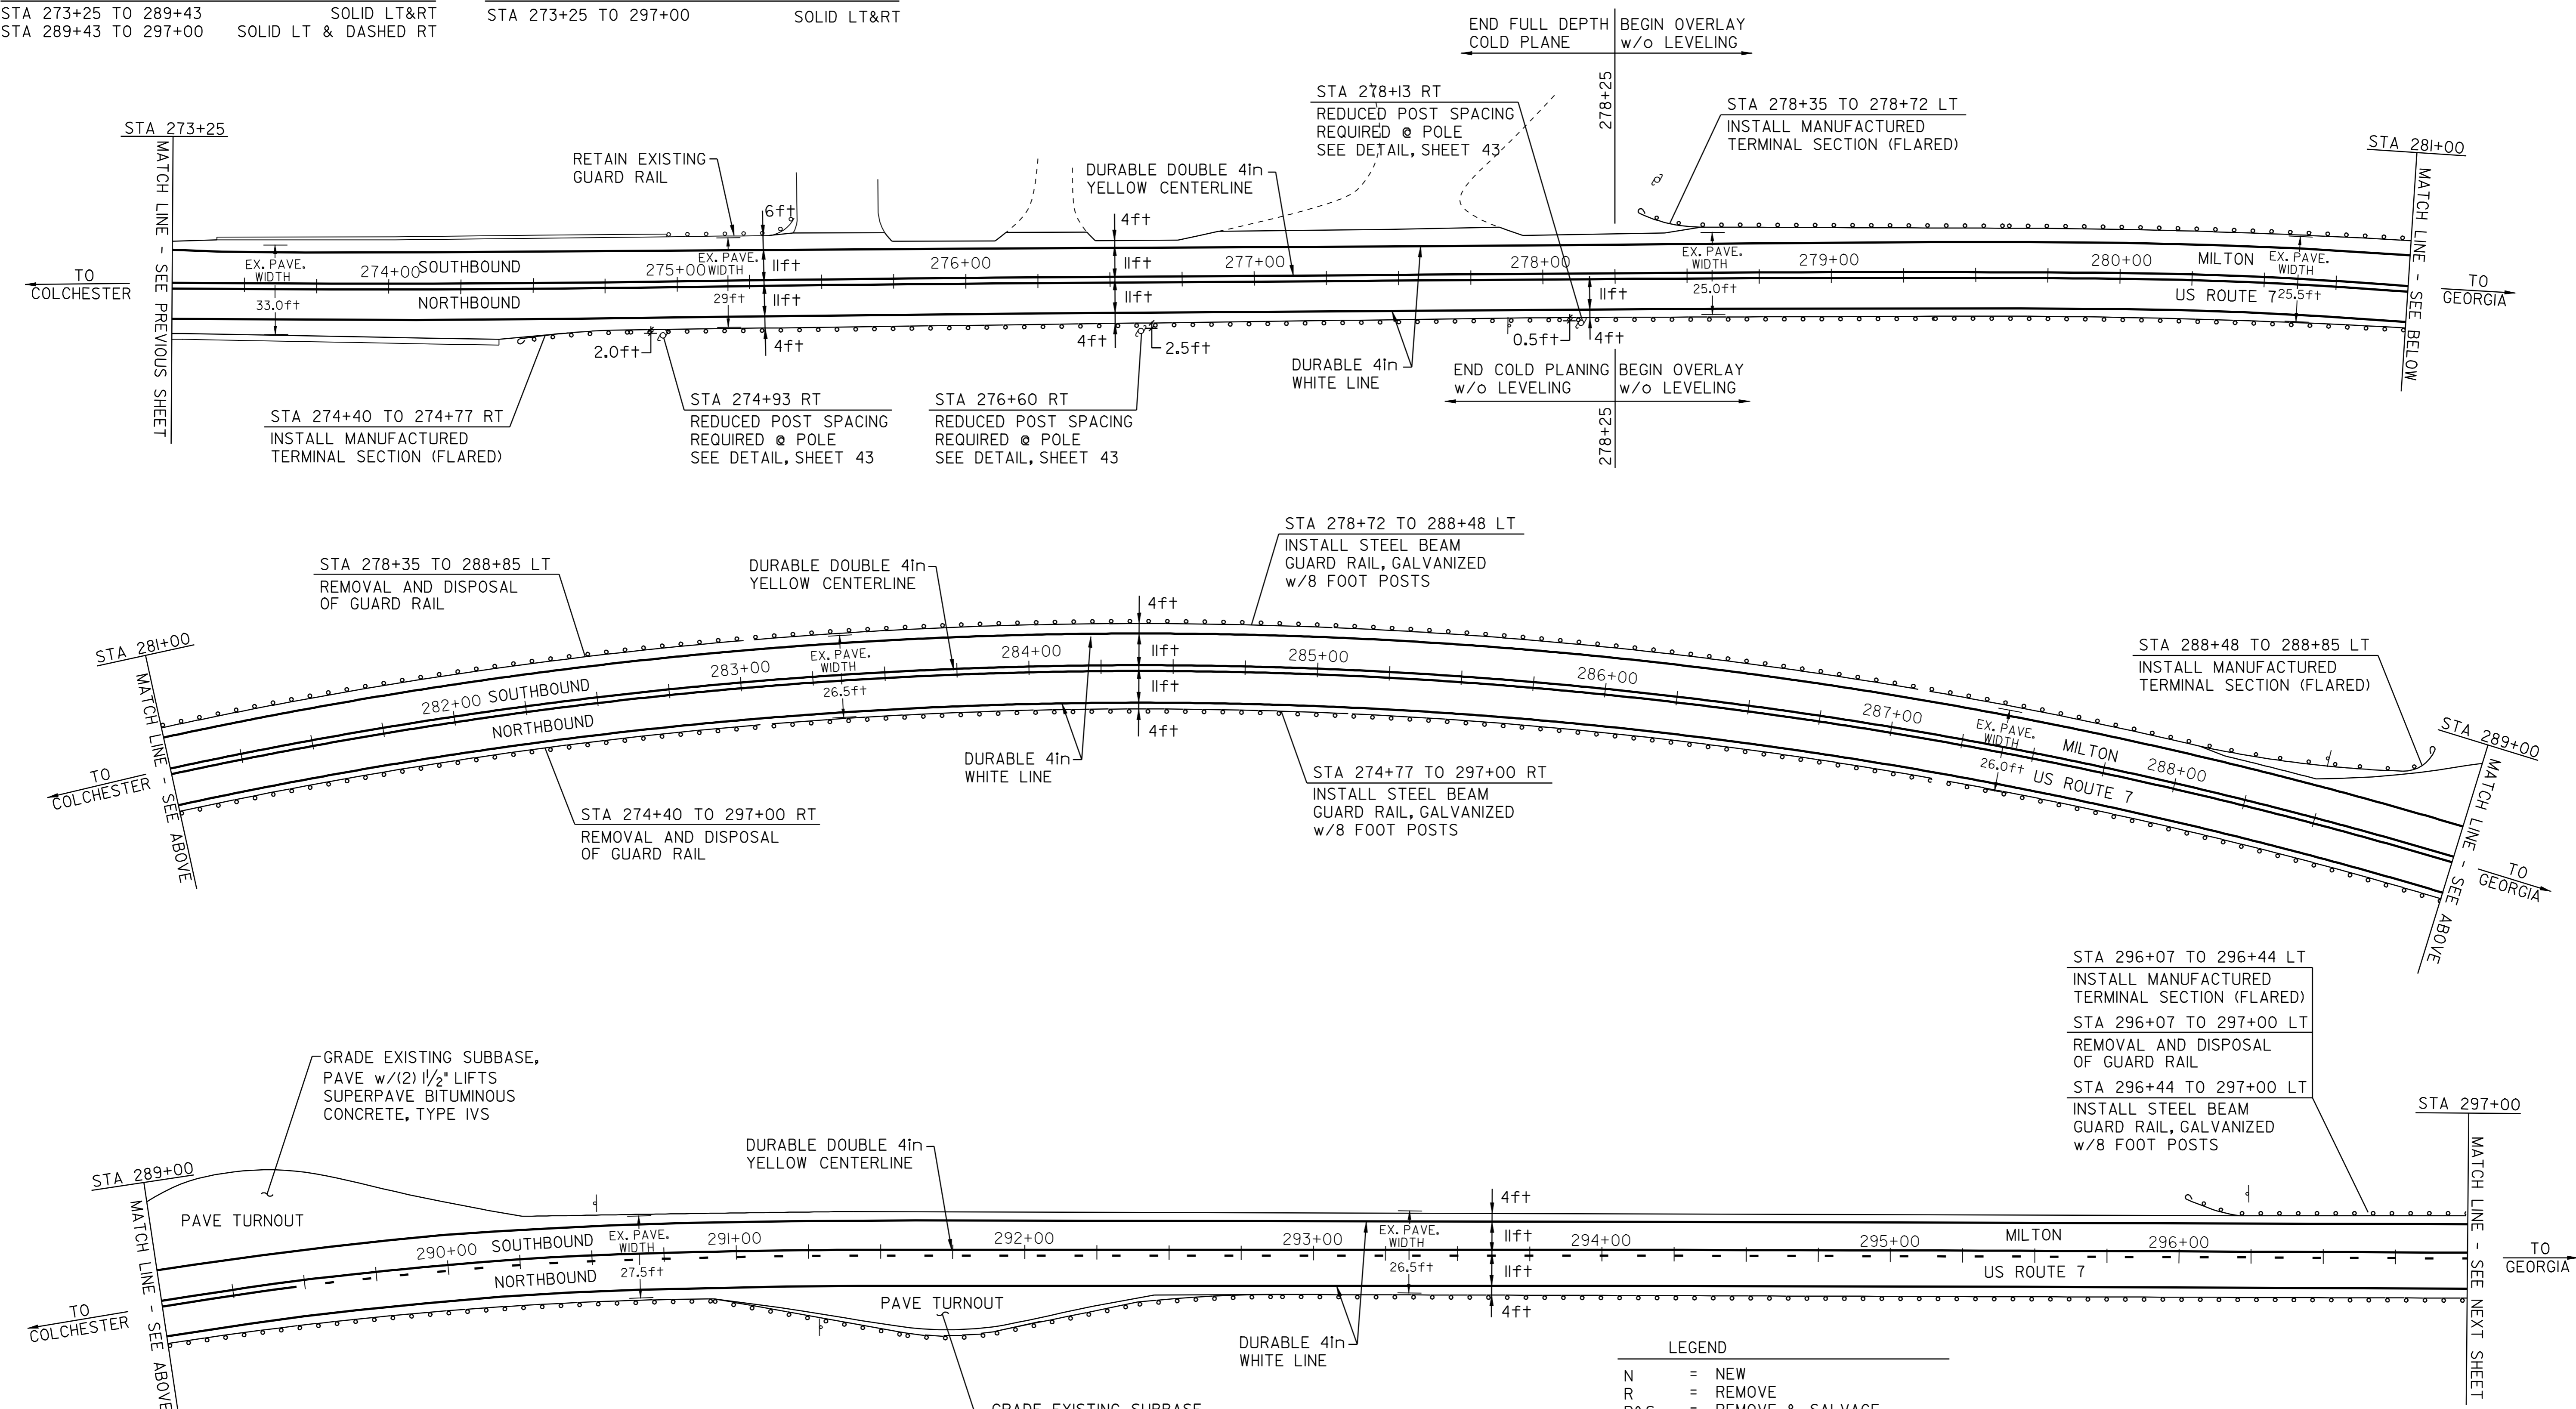

- REMOVAL AND DISPOSAL OF GUARD RAIL
 STA 274+40 TO 297+00 RT
 STA 278+35 TO 288+85 LT
 STA 296+07 TO 297+00 LT
- STEEL BEAM GUARD RAIL, GALVANIZED w/8 FOOT POSTS
 STA 274+77 TO 297+00 RT
 STA 278+72 TO 288+48 LT
 STA 296+44 TO 297+00 LT
- MANUFACTURED TERMINAL SECTION, FLARED
 STA 274+40 TO 274+77 RT
 STA 278+35 TO 278+72 LT
 STA 288+48 TO 288+85 LT
 STA 296+07 TO 296+44 LT

LEGEND

N	=	NEW
R	=	REMOVE
R&S	=	REMOVE & SALVAGE
S	=	SALVAGE
RET	=	RETAIN
B-TO-B	=	BACK TO BACK
☐	=	CATCH BASIN/DI
⊕	=	EXISTING HYDRANT
⊗	=	EXISTING VALVE (WATER,GAS)
○ _{S,E,T}	=	EXISTING MANHOLE (SEWER,ELECTRIC,TEL.)
(N.W.)	=	NO WORK REQUIRED (TYP. FOR VALVES, M.H.'S, & C.B.'S WHERE NOTED)
⊙	=	UTILITY POLE
⌋	=	DRIVE

PAVING PROJECT LAYOUT SHEET #18

DESIGNED BY	BCE/PJM	DATE	8-06
DRAWN BY	C.E.A., INC.	DATE	8-06
DESIGN FILE NO.	05c158.dgn		
PRF FILE	05c158p18.l	DATE PLOTTED	19-MAY-2009 12
PROJ. NAME	MILTON - GEORGIA		
PROJ. NO.	STP 2510(1)S		
SHEET	26	OF	44 SHEETS