

TEMPORARY 4in YELLOW LINE (PAINT)
 DURABLE 4in YELLOW LINE (THERMOPLASTIC)
 STA 313+50 TO 316+95 SOLID LT&RT
 STA 316+95 TO 324+10 SOLID LT & DASHED RT
 STA 324+10 TO 324+70 SOLID LT&RT
 STA 324+70 TO 331+77 DASHED LT & SOLID RT
 STA 331+77 TO 339+00 SOLID LT&RT
 STA 333+20 DOUBLE SOLID RT
 (WITH CENTERLINE BREAKS FOR TOWN HIGHWAYS)

TEMPORARY 4in WHITE LINE (PAINT)
 DURABLE 4in WHITE LINE (THERMOPLASTIC)
 STA 313+50 TO 339+00 SOLID LT&RT
 (WITH EDGE LINE BREAKS FOR TOWN HIGHWAYS)
 TEMPORARY LETTER OR SYMBOL (PAINT)
 DURABLE LETTER OR SYMBOL (THERMOPLASTIC)
 STA 333+20 RT "STOP"
 TEMPORARY 24in STOP BAR (PAINT)
 DURABLE 24in STOP BAR (THERMOPLASTIC)
 STA 333+20 RT EDGEWATER TER.




REMOVING SIGNS
 3

DITCHING LOCATIONS (REFER TO SHEET 8 FOR DETAILS)
 STA 313+50 TO 318+25 LT
 STA 334+25 TO 339+00 LT

RELOCATE MAILBOX, SINGLE SUPPORT
 STA 320+35 RT

320+92.5
 STA 320+80 TO 322+05 LT
 REMOVAL AND DISPOSAL OF GUARD RAIL
 320+92.5 321+30
 STA 320+80 TO 321+17 LT
 INSTALL MANUFACTURED TERMINAL SECTION (FLARED)

321+30 321+67.5
 STA 321+17 TO 321+68 LT
 INSTALL STEEL BEAM GUARD RAIL, GALVANIZED w/8 FOOT POSTS
 67.5
 STA 321+68 TO 322+05 LT
 INSTALL MANUFACTURED TERMINAL SECTION (FLARED)

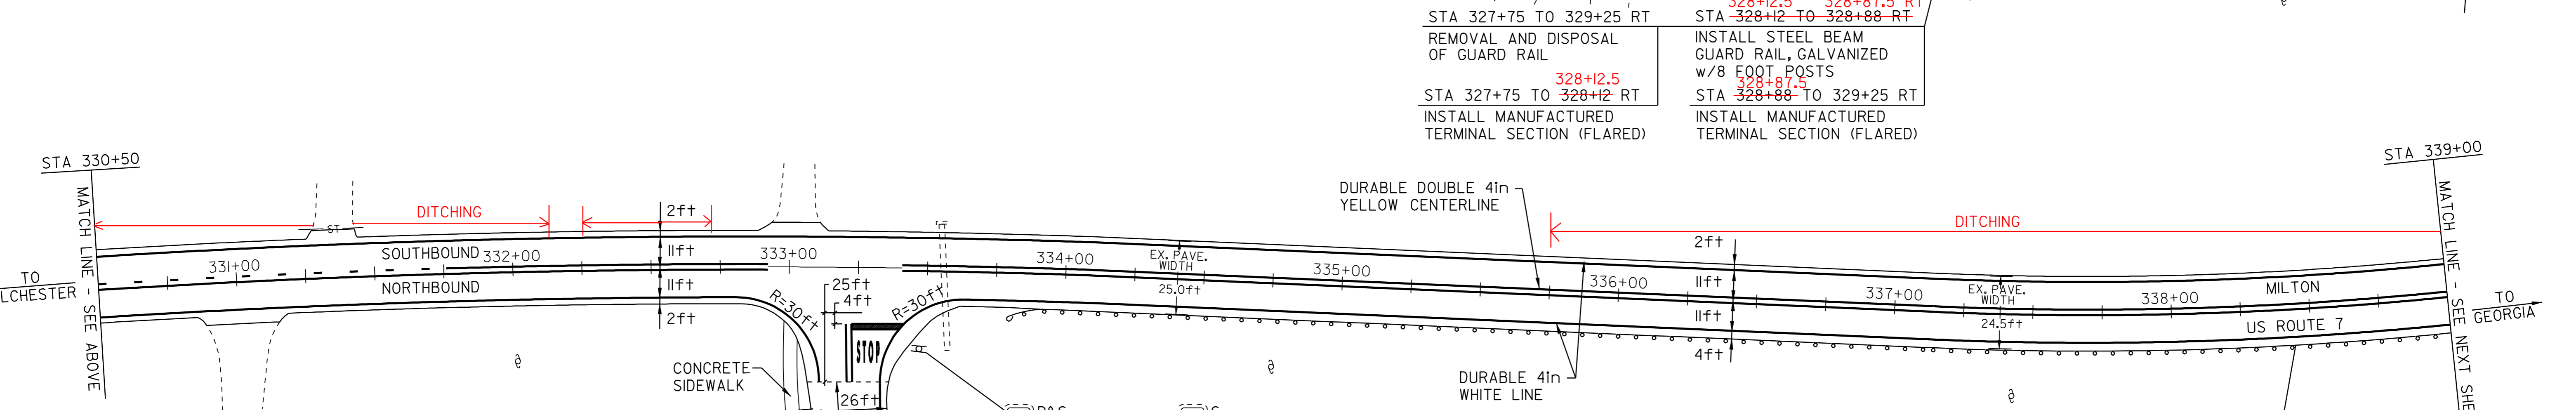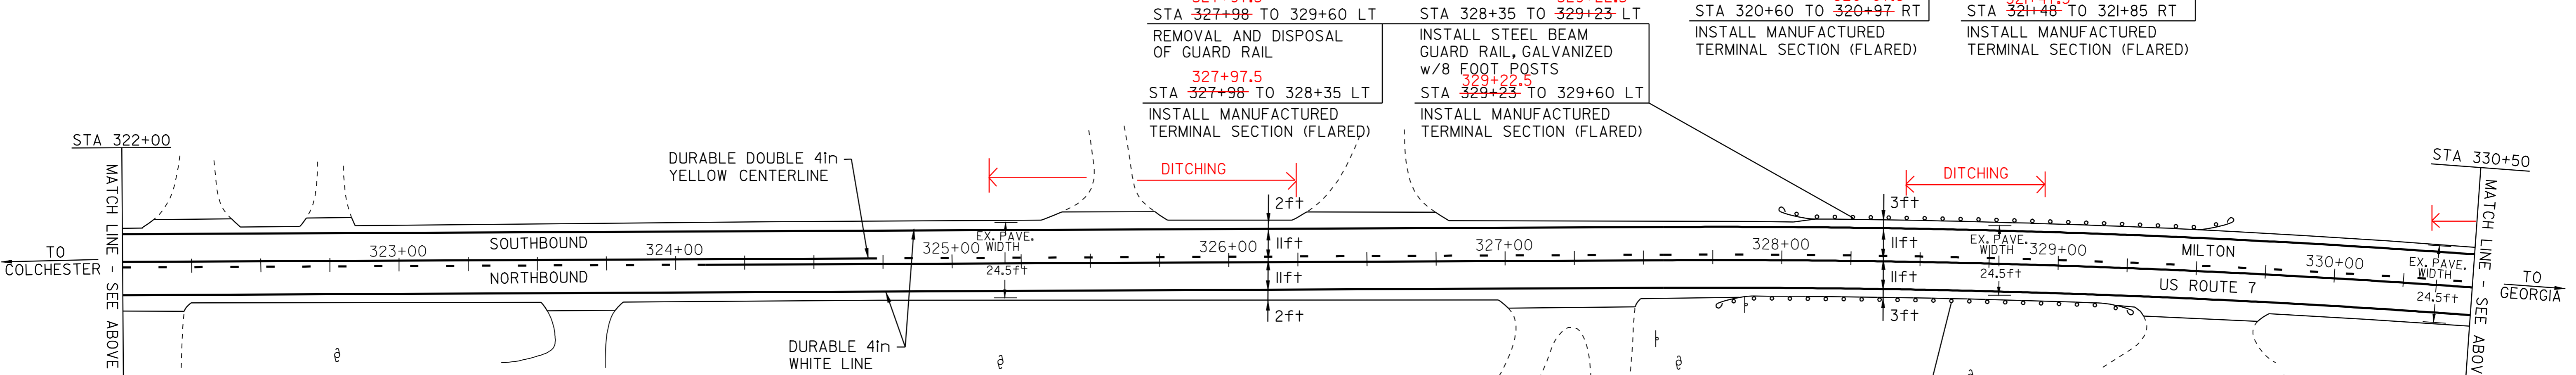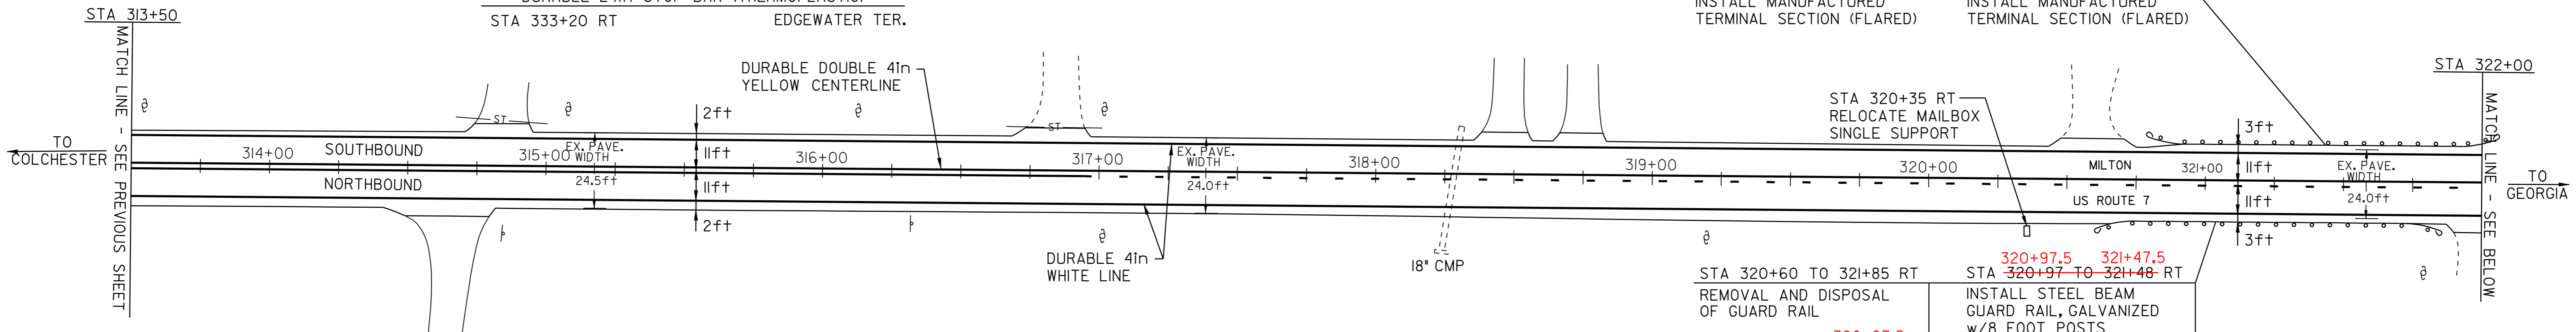

MANUFACTURED TERMINAL SECTION, FLARED
 STA 320+60 TO 320+97 RT
 STA 320+80 TO 321+17 LT
 STA 321+48 TO 321+85 RT
 STA 321+68 TO 322+05 LT
 STA 327+75 TO 328+12 RT
 STA 327+98 TO 328+35 LT
 STA 328+88 TO 329+25 RT
 STA 329+23 TO 329+60 LT
 STA 333+80 TO 334+17 RT


STEEL BEAM GUARD RAIL, GALVANIZED
 STA 334+17 TO 336+04 RT

REMOVAL AND DISPOSAL OF GUARD RAIL
 STA 320+60 TO 321+85 RT
 STA 320+80 TO 322+05 LT
 STA 327+75 TO 329+25 RT
 STA 327+98 TO 329+60 LT
 STA 334+05 TO 339+00 RT

STEEL BEAM GUARD RAIL, GALVANIZED w/8 FOOT POSTS
 STA 320+97 TO 321+48 RT
 STA 321+17 TO 321+68 LT
 STA 328+12 TO 328+88 RT
 STA 328+35 TO 329+23 LT
 STA 336+04 TO 339+00 RT

333+05
 LEGAL LOAD LIMIT 24,000 POUNDS

EDGEWATER TER TH #151
 STA 333+20 MM 6.311 (FIELD MEASURED)

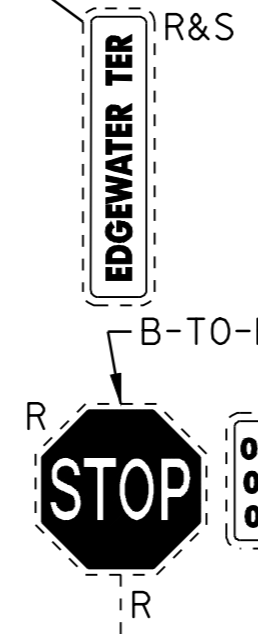

- LEGEND
- N = NEW
 - R = REMOVE
 - R&S = REMOVE & SALVAGE
 - S = SALVAGE
 - RET = RETAIN
 - B-T-O-B = BACK TO BACK
 - ⊕ ⊞ ⊠ CATCH BASIN/DI
 - ⊕ EXISTING HYDRANT
 - ⊕ EXISTING VALVE (WATER,GAS)
 - ⊕ s,e,t EXISTING MANHOLE (SEWER,ELECTRIC,TEL.)
 - (N.W.) = NO WORK REQUIRED (TYP. FOR VALVES, M.H.'S, & C.B.'S WHERE NOTED)
 - ⊕ UTILITY POLE
 - ⊕ DRIVE

STA 334+05 TO 339+00 RT
 REMOVAL AND DISPOSAL OF GUARD RAIL
 STA 333+80 TO 334+17 RT
 INSTALL MANUFACTURED TERMINAL SECTION (FLARED)

STA 334+17 TO 336+04 RT
 INSTALL STEEL BEAM GUARD RAIL, GALVANIZED
 STA 336+04 TO 339+00 RT
 INSTALL STEEL BEAM GUARD RAIL, GALVANIZED w/8 FOOT POSTS

PAVING PROJECT LAYOUT SHEET #20

DESIGNED BY BCE/PJM DATE 8-06
 DRAWN BY C.E.A., INC. DATE 8-06
 DESIGN FILE NO. 05c158.dgn
 PRF FILE 05c158p20.I DATE PLOTTED 19-MAY-2009 12
 PROJ. NAME **MILTON - GEORGIA**
 PROJ. NO. **STP 2510(1)S**
 SHEET **28** OF **44** SHEETS