
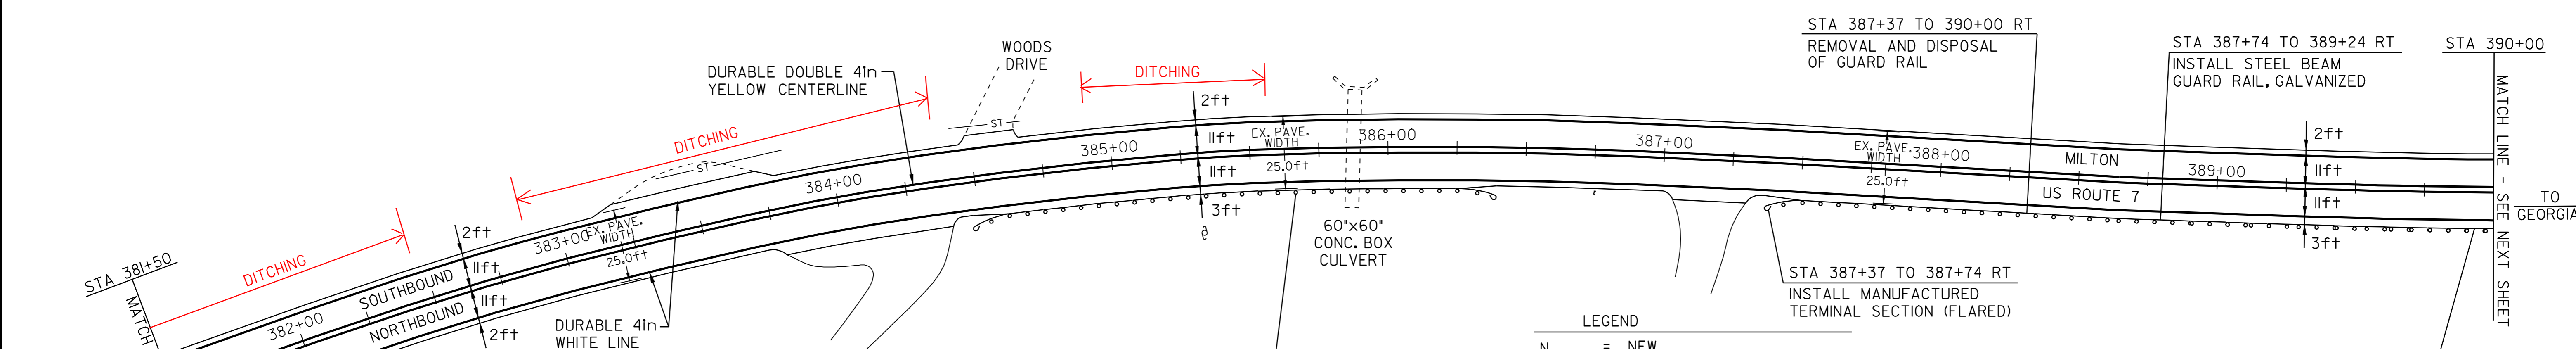
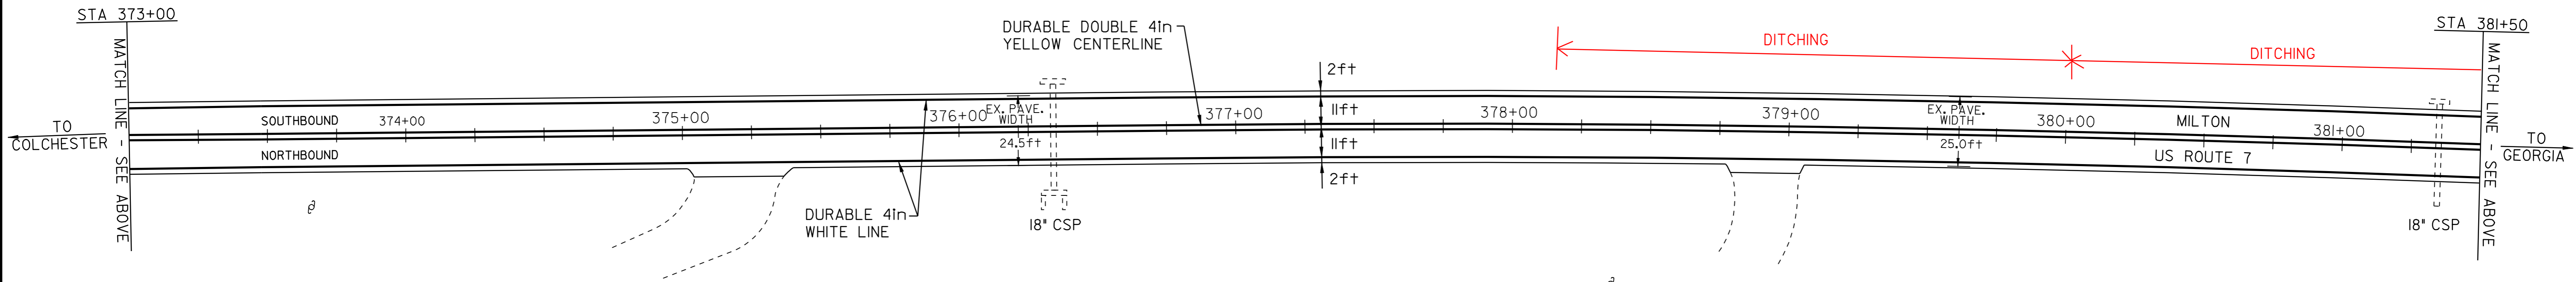


TEMPORARY 4in YELLOW LINE (PAINT)
DURABLE 4in YELLOW LINE (THERMOPLASTIC)
STA 364+50 TO 390+00
SOLID LT&RT

TEMPORARY 4in WHITE LINE (PAINT)
DURABLE 4in WHITE LINE (THERMOPLASTIC)
STA 364+50 TO 390+00
SOLID LT&RT

DITCHING LOCATIONS (REFER TO SHEET 8 FOR DETAILS)
STA 364+50 TO 384+50 LT

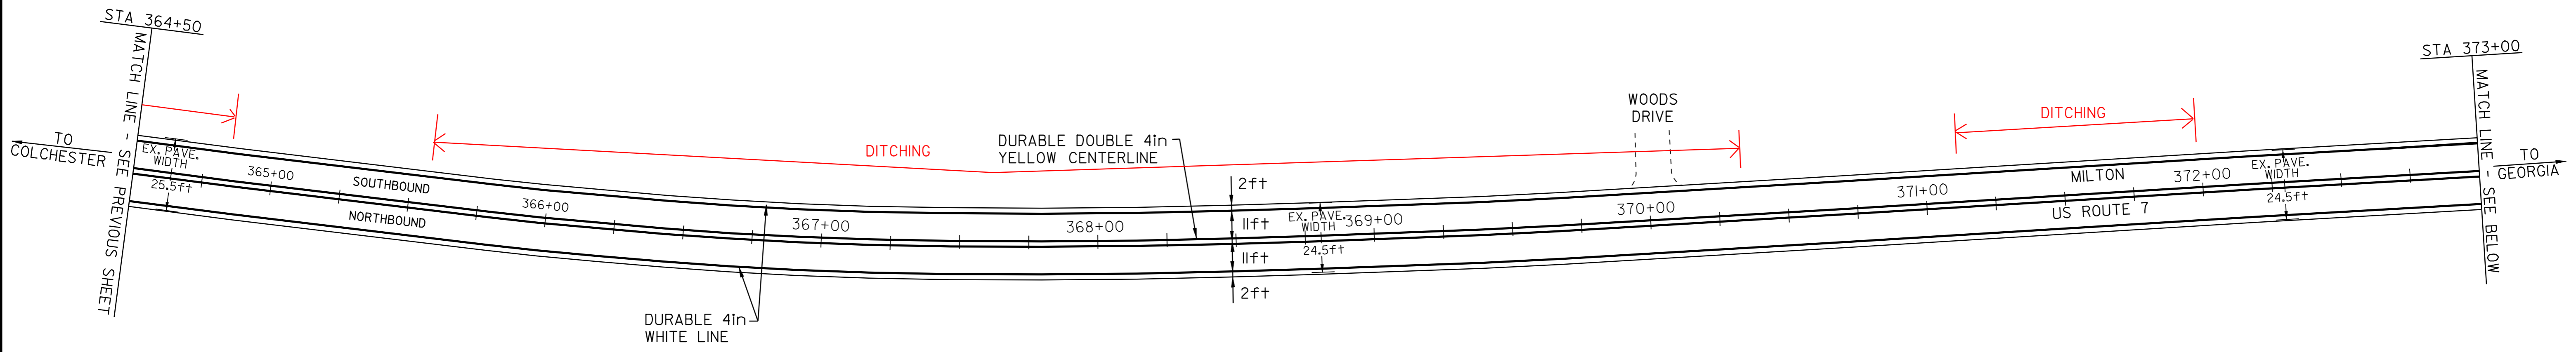

STA 384+50 TO 386+38 RT REMOVAL AND DISPOSAL OF GUARD RAIL	STA 384+87 TO 386+0IRT INSTALL STEEL BEAM GUARD RAIL, GALVANIZED w/8 FOOT POSTS
STA 384+50 TO 384+87 RT INSTALL MANUFACTURED TERMINAL SECTION (FLARED)	STA 386+0IT TO 386+38 RT INSTALL MANUFACTURED TERMINAL SECTION (FLARED)

- LEGEND**
- N = NEW
 - R = REMOVE
 - R&S = REMOVE & SALVAGE
 - S = SALVAGE
 - RET = RETAIN
 - B-TO-B = BACK TO BACK
 - ☐ = CATCH BASIN/DI
 - ⊕ = EXISTING HYDRANT
 - ⊗ = EXISTING VALVE (WATER,GAS)
 - _{S,E,T} = EXISTING MANHOLE (SEWER,ELECTRIC,TEL.)
 - (N.W.) = NO WORK REQUIRED (TYP. FOR VALVES, M.H.'S, & C.B.'S WHERE NOTED)
 - ⊕ = UTILITY POLE
 - = DRIVE

<u>MANUFACTURED TERMINAL SECTION, FLARED</u> STA 384+50 TO 384+87 RT STA 386+0IT TO 386+38 RT STA 387+37 TO 387+74 RT	<u>REMOVAL AND DISPOSAL OF GUARD RAIL</u> STA 384+50 TO 386+38 RT STA 387+37 TO 390+00 RT	<u>STEEL BEAM GUARD RAIL, GALVANIZED w/8 FOOT POSTS</u> STA 384+87 TO 386+0IRT STA 389+24 TO 390+00 RT	<u>STEEL BEAM GUARD RAIL, GALVANIZED</u> STA 387+74 TO 389+24 RT
--	---	--	---

STA 387+37 TO 390+00 RT REMOVAL AND DISPOSAL OF GUARD RAIL	STA 387+74 TO 389+24 RT INSTALL STEEL BEAM GUARD RAIL, GALVANIZED	STA 390+00 MATCH LINE - SEE NEXT SHEET
STA 387+37 TO 387+74 RT INSTALL MANUFACTURED TERMINAL SECTION (FLARED)	STA 389+24 TO 390+00 RT INSTALL STEEL BEAM GUARD RAIL, GALVANIZED w/8 FOOT POSTS	

PAVING PROJECT LAYOUT SHEET #22

DESIGNED BY	BCE/PJM	DATE	8-06
DRAWN BY	C.E.A., INC.	DATE	8-06
DESIGN FILE NO.	05c158.dgn		
PRF FILE	05c158p22.i	DATE PLOTTED	19-MAY-2009 12
PROJ. NAME	MILTON - GEORGIA		
PROJ. NO.	STP 2510(1)S		
SHEET	30	OF	44 SHEETS