

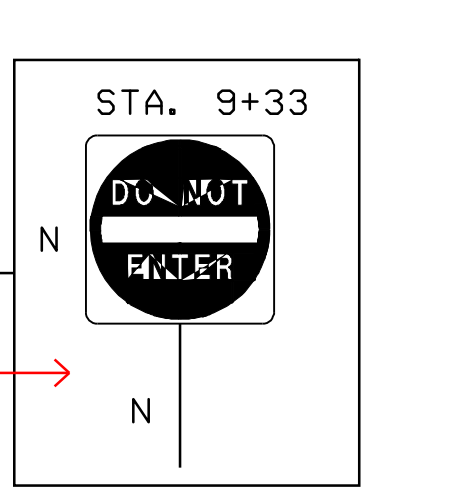
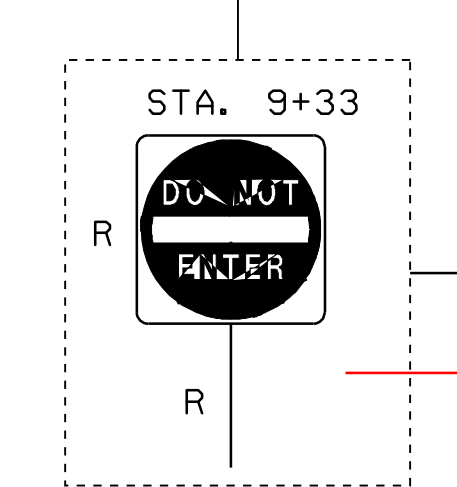
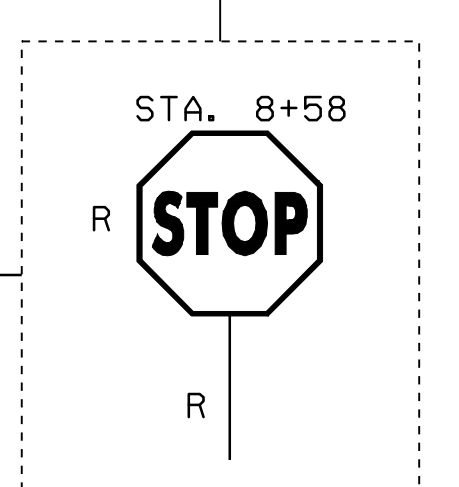
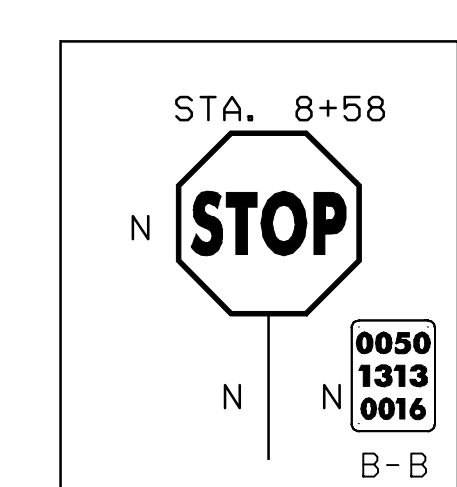
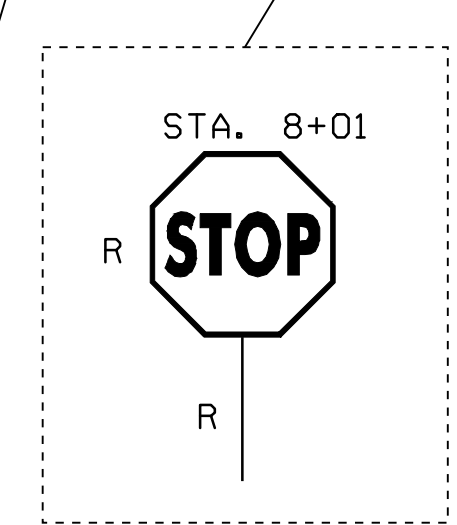


STA. 5+00
MATCHLINE

STA. 10+00
MATCHLINE

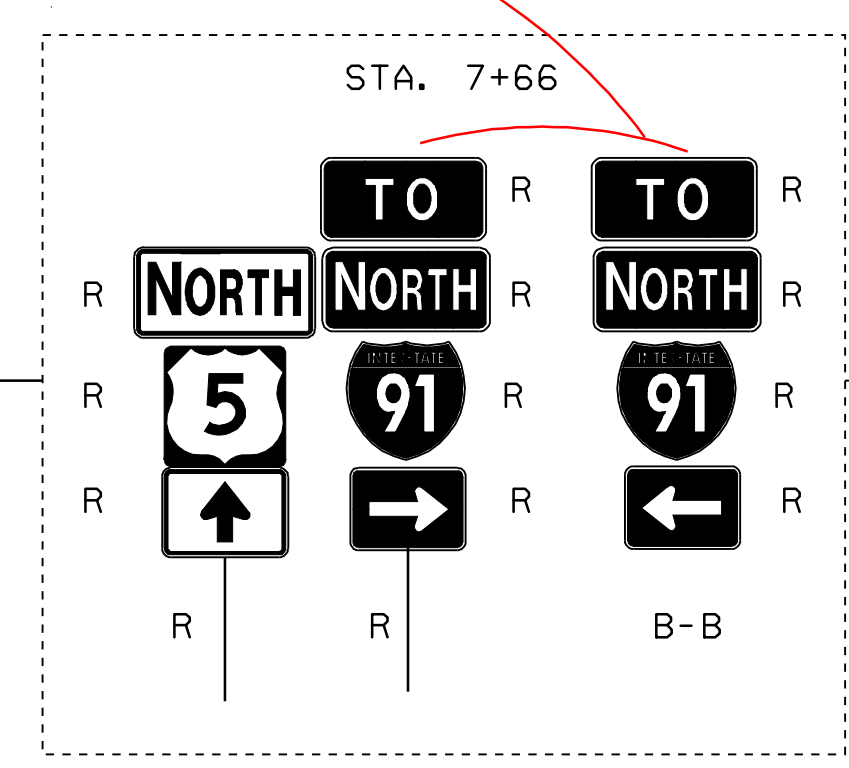

LEGEND:
 N = NEW
 R = REMOVE
 S = SALVAGED
 RET = RETAINED
 ----- = EXISTING
 _____ = NEW

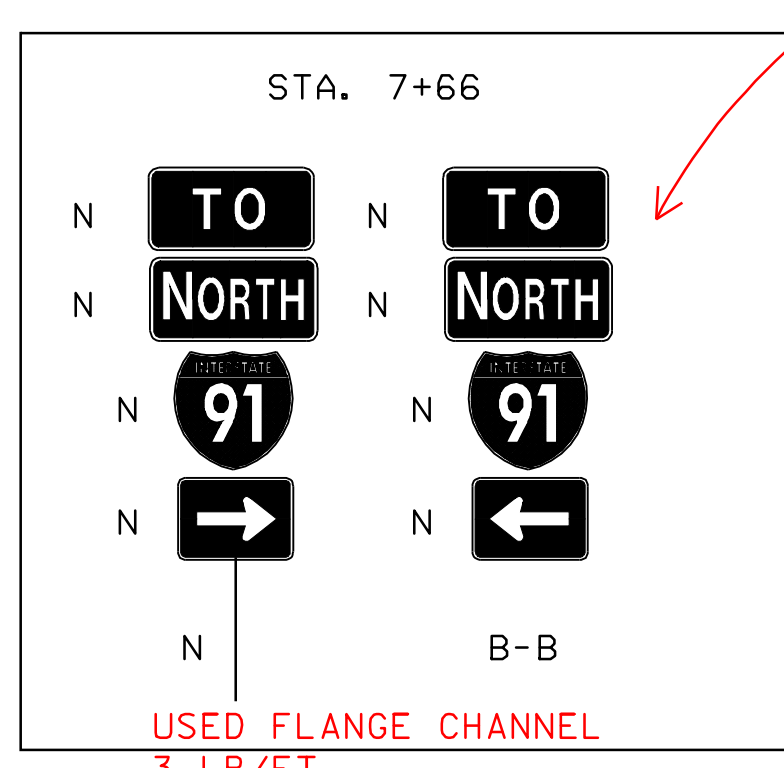

LAYOUT SHEET # 2

PROJECT NAME:	PUTNEY	FILE NAME:	STPG SIGN (13).DGN	PLOT DATE:	12-DEC-2008 13:2
PROJECT NUMBER:	STPG SIGN (13)	PROJECT LEADER:	N. AVERY	DRAWN BY:	N. AVERY
		DESIGNED BY:	N. AVERY & M. MILLER	CHECKED BY:	A. GAMBLE
		SIGN(13) L02		SHEET	4 OF 38