

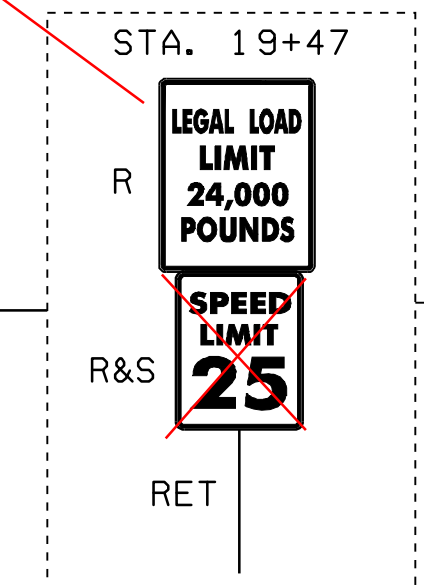
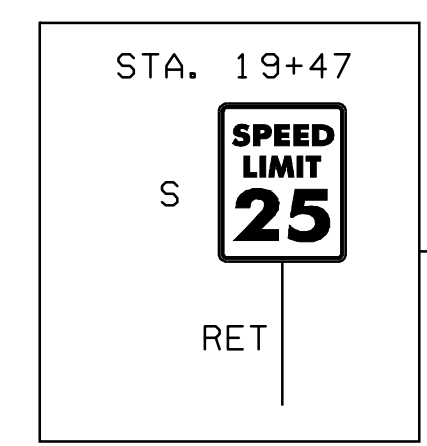


OLD DEPOT RD  
MM 0.384 = STA. 20+27  
(PAVED)

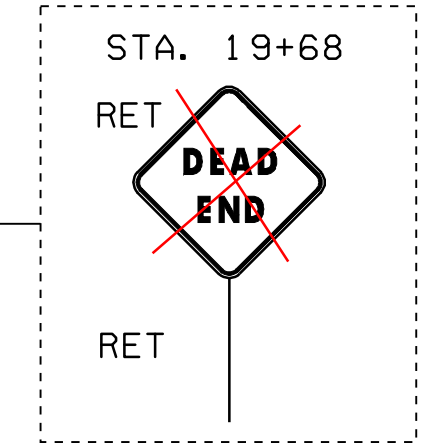

LEGEND:  
N = NEW  
R = REMOVE  
S = SALVAGED  
RET = RETAINED

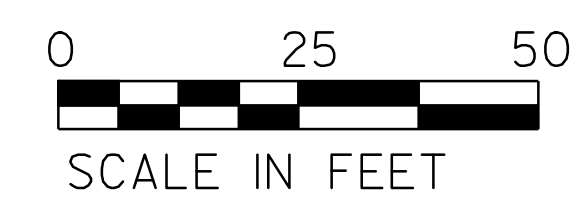

LAYOUT SHEET # 4

PROJECT NAME: PUTNEY  
PROJECT NUMBER: STPG SIGN (13)

FILE NAME: STPG SIGN (13).DGN  
PROJECT LEADER: N. AVERY  
DESIGNED BY: N. AVERY & M. MILLER  
SIGN(13) L04

PLOT DATE: 12-DEC-2008 13:2  
DRAWN BY: N. AVERY  
CHECKED BY: A. GAMBLE  
SHEET 6 OF 38