

#NET&GMP3-25K17785

STA. 30+00

STA. 35+00

30+00

35+00

MATCHLINE

MATCHLINE

US ROUTE 5

SOUTHBOUND

NORTHBOUND

STA. 32+10
LEGAL LOAD LIMIT
24,000
POUNDS

STA. 32+47
CHRISTIAN SQUARE

STA. 32+42
STOP

STA. 32+42
CHRISTIAN SQUARE
STOP


STA. 33+74
SPEED LIMIT
30

STA. 33+74
SPEED LIMIT
30
NO PARKING
MIDNIGHT
THRU
NOV 1 - APR 15

TH-57
CHRISTIAN SQUARE
MM 0.611 = STA. 32+26
(PAVED)

LEGEND:
N = NEW
R = REMOVE
S = SALVAGED
RET = RETAINED

----- = EXISTING
_____ = NEW

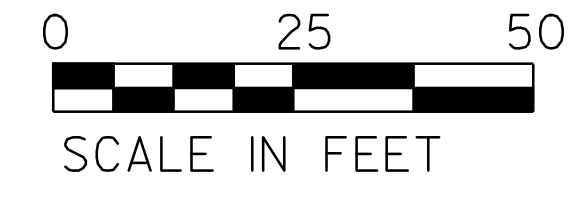

LAYOUT SHEET # 7

PROJECT NAME: PUTNEY
PROJECT NUMBER: STPG SIGN (13)

FILE NAME: STPG SIGN (13).DGN
PROJECT LEADER: N. AVERY
DESIGNED BY: N. AVERY & M. MILLER
SIGN(13) L07

PLOT DATE: 12-DEC-2008 13:2
DRAWN BY: N. AVERY
CHECKED BY: A. GAMBLE
SHEET 9 OF 38