


LEGEND:
 N = NEW
 R = REMOVE
 S = SALVAGED
 RET = RETAINED
 ----- = EXISTING
 _____ = NEW

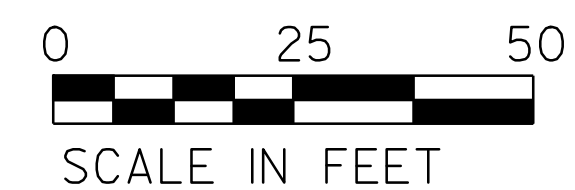

LAYOUT SHEET # 10

PROJECT NAME: PUTNEY
 PROJECT NUMBER: STPG SIGN (13)

FILE NAME: STPG SIGN (13).DGN
 PROJECT LEADER: N. AVERY
 DESIGNED BY: N. AVERY & M. MILLER
 SIGN(13) L10

PLOT DATE: 12-DEC-2008 13:22
 DRAWN BY: N. AVERY
 CHECKED BY: A. GAMBLE
 SHEET 12 OF 38