


LEGEND:
 N = NEW
 R = REMOVE
 S = SALVAGED
 RET = RETAINED
 ----- = EXISTING
 _____ = NEW

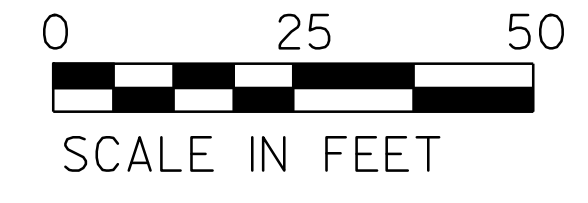

LAYOUT SHEET # 15

PROJECT NAME:	PUTNEY	PLOT DATE:	12-DEC-2008 13:22
PROJECT NUMBER:	STPG SIGN (13)	DRAWN BY:	N. AVERY
FILE NAME:	STPG SIGN (13).DGN	CHECKED BY:	A. GAMBLE
DESIGNED BY:	N. AVERY & M. MILLER	SHEET	17 OF 38
SIGN(13) L15			