


STA. 100+00
MATCHLINE



LEGEND:
 N = NEW
 R = REMOVE
 S = SALVAGED
 RET = RETAINED
 ----- = EXISTING
 _____ = NEW

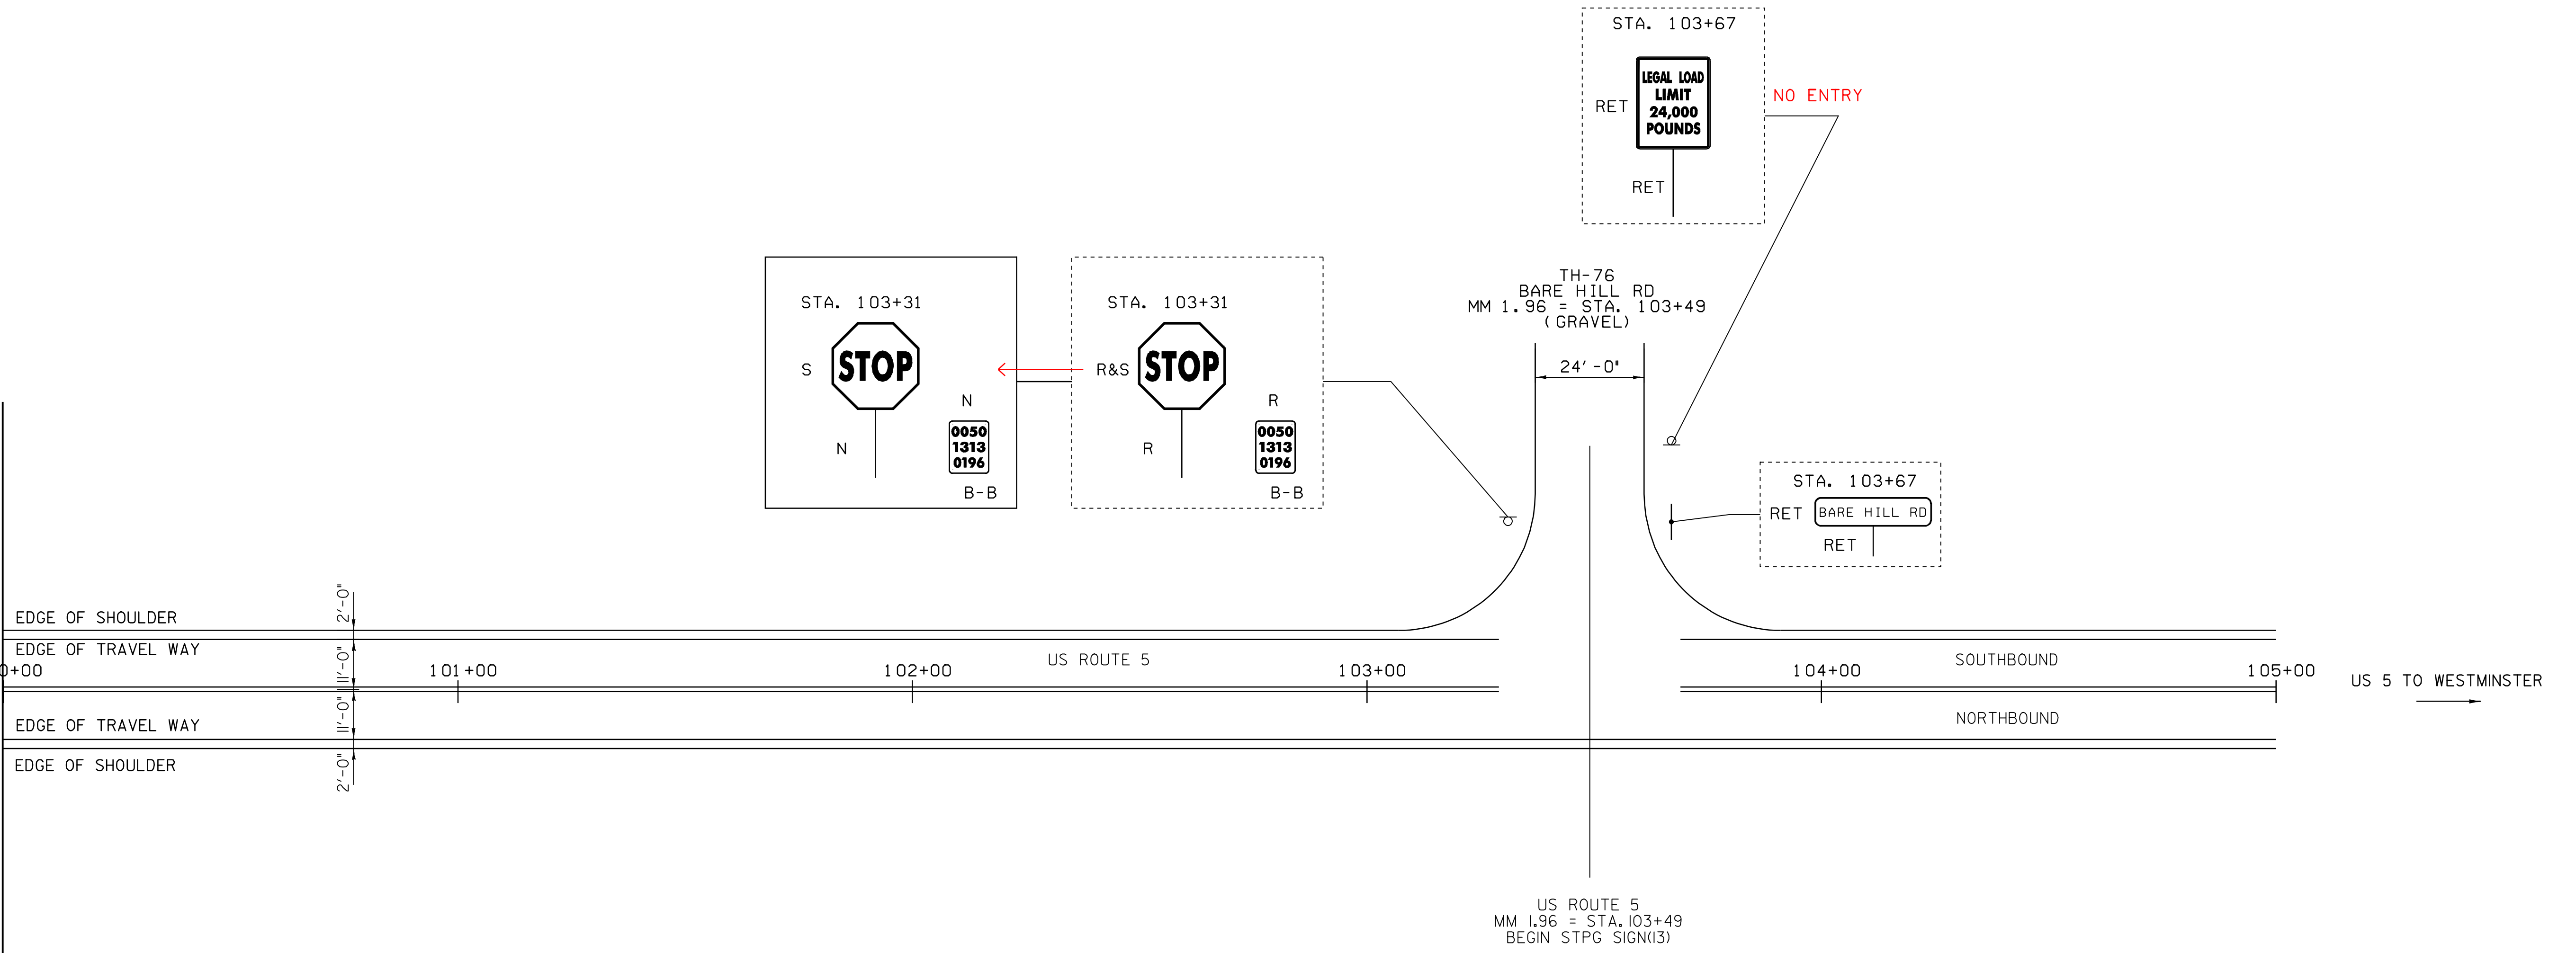

LAYOUT SHEET # 21

PROJECT NAME:	PUTNEY	PLOT DATE:	12-DEC-2008 13:2
PROJECT NUMBER:	STPG SIGN (13)	DRAWN BY:	
FILE NAME:	STPG SIGN (13).DGN	CHECKED BY:	
DESIGNED BY:		SHEET	23 OF 38
SIGN(13) L21			