

646.40 - DURABLE 4" WHITE LINE
(TYPE I, TAPE)

43+60 - 43+85 (4' LT.)
43+96 - 44+38 (DIAGONALS) (208')
44+38 - 49+20 (4' LT.)
43+60 - 46+00 (40' LT.)
43+60 - 46+00 (DIAGONALS) (40' LT.)
45+58 - 45+12 (28' LT.) (LANE LINE)
45+12 - 45+40 (28' LT.) (DOTTED LINE)
45+12 - 45+40 (16' LT.) (DOTTED LINE)
45+40 - 46+00 (16' LT.) (LANE LINE)
46+40 - 46+63 (40' LT.)
47+26 - 48+07 (40' LT.)
48+66 - 49+20 (40' LT.)

646.60 - TEMPORARY 4" WHITE LINE
(PAINT)

43+60 - 43+85 (4' LT.) (2 APPLICATIONS)
44+38 - 49+20 (4' LT.) (2 APPLICATIONS)
43+60 - 46+00 (40' LT.) (2 APPLICATIONS)
45+58 - 45+12 (28' LT.) (LANE LINE) (2 APPLICATIONS)
45+12 - 45+40 (28' LT.) (DOTTED LINE) (2 APPLICATIONS)
45+12 - 45+40 (16' LT.) (DOTTED LINE) (2 APPLICATIONS)
45+40 - 46+00 (16' LT.) (LANE LINE) (2 APPLICATIONS)
46+40 - 46+63 (40' LT.) (2 APPLICATIONS)
47+26 - 48+07 (40' LT.) (2 APPLICATIONS)
48+66 - 49+20 (40' LT.) (2 APPLICATIONS)

646.41 - DURABLE 4" YELLOW LINE
(TYPE I, TAPE)

43+60 - 43+79 (16' LT.) (DBL.)
43+60 - 43+79 (28' LT.) (DBL.)
44+58 - 45+12 (15' LT.) (DBL.)
45+12 (15' LT.) - 45+42 (27' LT.) (DBL.)
45+42 - 45+97 (27' LT.) (DBL.)
46+00 (28' LT.) - 46+70 (16' LT.) (DOTTED)
46+70 - 49+20 (16' LT.) (DBL.)

646.61 - TEMPORARY 4" YELLOW LINE
(PAINT)

43+60 - 43+79 (16' LT.) (DBL.) (2 APPLICATIONS)
43+60 - 43+79 (28' LT.) (DBL.) (2 APPLICATIONS)
44+58 - 45+12 (15' LT.) (DBL.) (2 APPLICATIONS)
45+12 (15' LT.) - 45+42 (27' LT.) (DBL.) (2 APPLICATIONS)
45+42 - 45+97 (27' LT.) (DBL.) (2 APPLICATIONS)
46+00 (28' LT.) - 46+70 (16' LT.) (DOTTED) (2 APPLICATIONS)
46+70 - 49+20 (16' LT.) (DBL.) (2 APPLICATIONS)

646.43 - DURABLE 8" YELLOW LINE
(TYPE I, TAPE)

43+60 - 43+79 (DIAG.)

646.46 - DURABLE 24" WHITE LINE
(THERMOPLASTIC)

44+57 (24')
45+98 (28')
46+71 (24')
TIGAN ST. (17')

646.66 - TEMPORARY 24" WHITE LINE
(PAINT)

44+57 (24') (2 APPLICATIONS)
45+98 (28') (2 APPLICATIONS)
46+71 (24') (2 APPLICATIONS)
TIGAN ST. (17') (2 APPLICATIONS)

646.70 TEMPORARY LETTERS OR SYMBOLS
(PAINT)

45+08 (21' LT.) (2 APPLICATIONS)
45+46 (21' LT.) (2 APPLICATIONS)
46+80 (34' LT.) (2 APPLICATIONS)
46+80 (22' LT.) (2 APPLICATIONS)
48+24 (34' LT.) (2 APPLICATIONS)
48+24 (22' LT.) (2 APPLICATIONS)

646.50 DURABLE LETTER OR SYMBOL
(THERMOPLASTIC)

45+08 (21' LT.) (2 APPLICATIONS)
45+46 (21' LT.) (2 APPLICATIONS)
46+80 (34' LT.) (2 APPLICATIONS)
46+80 (22' LT.) (2 APPLICATIONS)
47+68 (O,N,L,Y) (34' LT.)
48+24 (34' LT.)
48+24 (22' LT.)
48+67 (O,N,L,Y) (34' LT.)

646.51 DURABLE CROSSWALK MARKING W/DIAG. LINES
(MOD.) (THERMOPLASTIC)

46+56 (48')
TIGAN ST. (37')

646.71 TEMPORARY CROSSWALK MARKING W/DIAG LINES
(MOD.) (PAINT)

46+56 (48') (2 APPLICATIONS)
TIGAN ST. (37') (2 APPLICATIONS)

618.10 - PORTLAND CEMENT CONCRETE SIDEWALK, 5" (MOD.)

43+85 LT. - 13.55 SY
43+95 RT. - 15.66 SY
44+40 RT. - 14.22 SY
45+96 LT. - 6.22 SY
46+40 LT. - 20 SY
46+56 RT. - 8.34 SY

618.30 - DETECTABLE WARNING SURFACE

43+85 LT.
43+95 RT.
44+40 RT.
45+96 LT.
46+40 LT.
46+56 RT.

675.50 REMOVING SIGNS
AS SHOWN - 28

604.412 - REHABING DI, CB OR MH



43+97 - 17' RT (DI)
44+24 - 18' RT (DI)
44+41 - @ CURB RT (DI)
44+41 - 48' LT (DI) 46+10 TIGAN STR. LT
46+11 - @ CURB RT (DI)
46+69 - 48' LT (DI)
47+17 - @ CURB RT (DI)
48+20 - @ CURB RT (DI)
48+20 - 48' LT (DI)

604.42 - CHANGE ELEVATION OF SEWER MANHOLES

39+53 - 24' LT (SMH)

629.20 - ADJUST ELEVATION OF VALVE BOXES

44+02 - 10' RT (WSO)
46+13 - 22' LT (WSO)
46+19 - 40' LT (WSO)
46+33 - 48' LT (WSO)
46+35 - 40' LT (WSO)
46+47 - 48' LT (WSO)
46+49 - 48' LT (WSO)
47+37 - 38' LT (WSO)
47+39 - 11' RT (WSO)

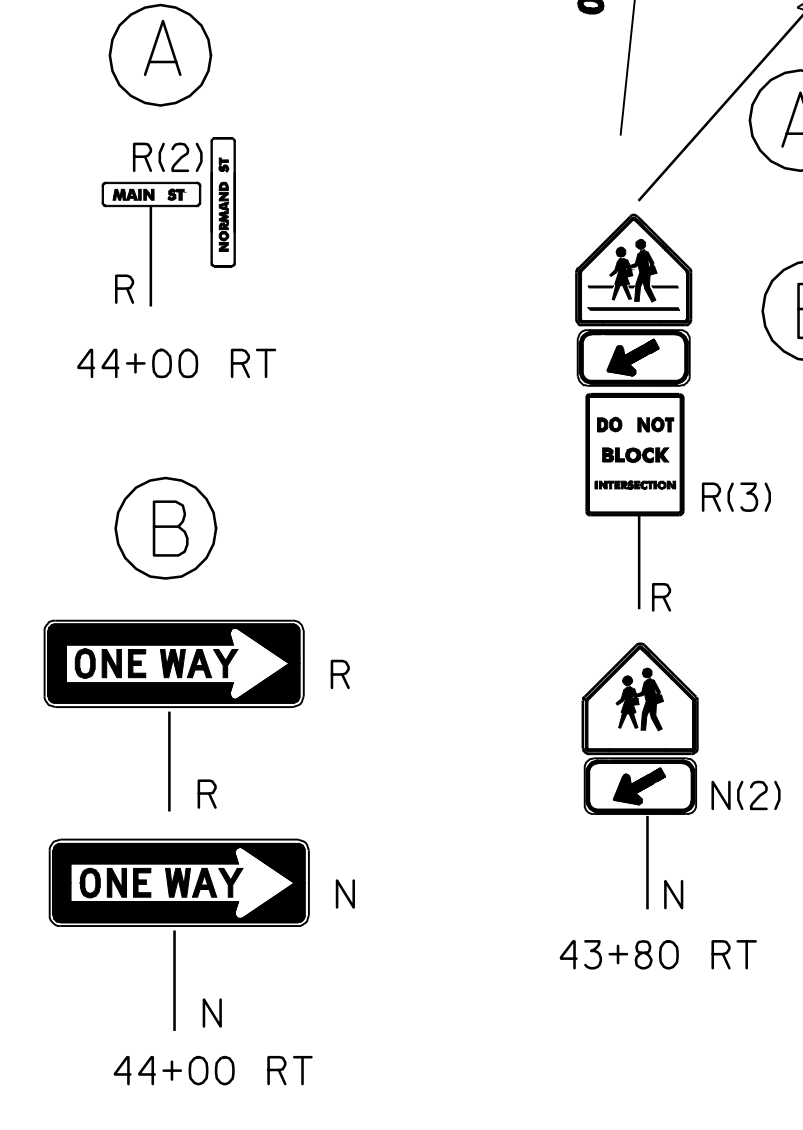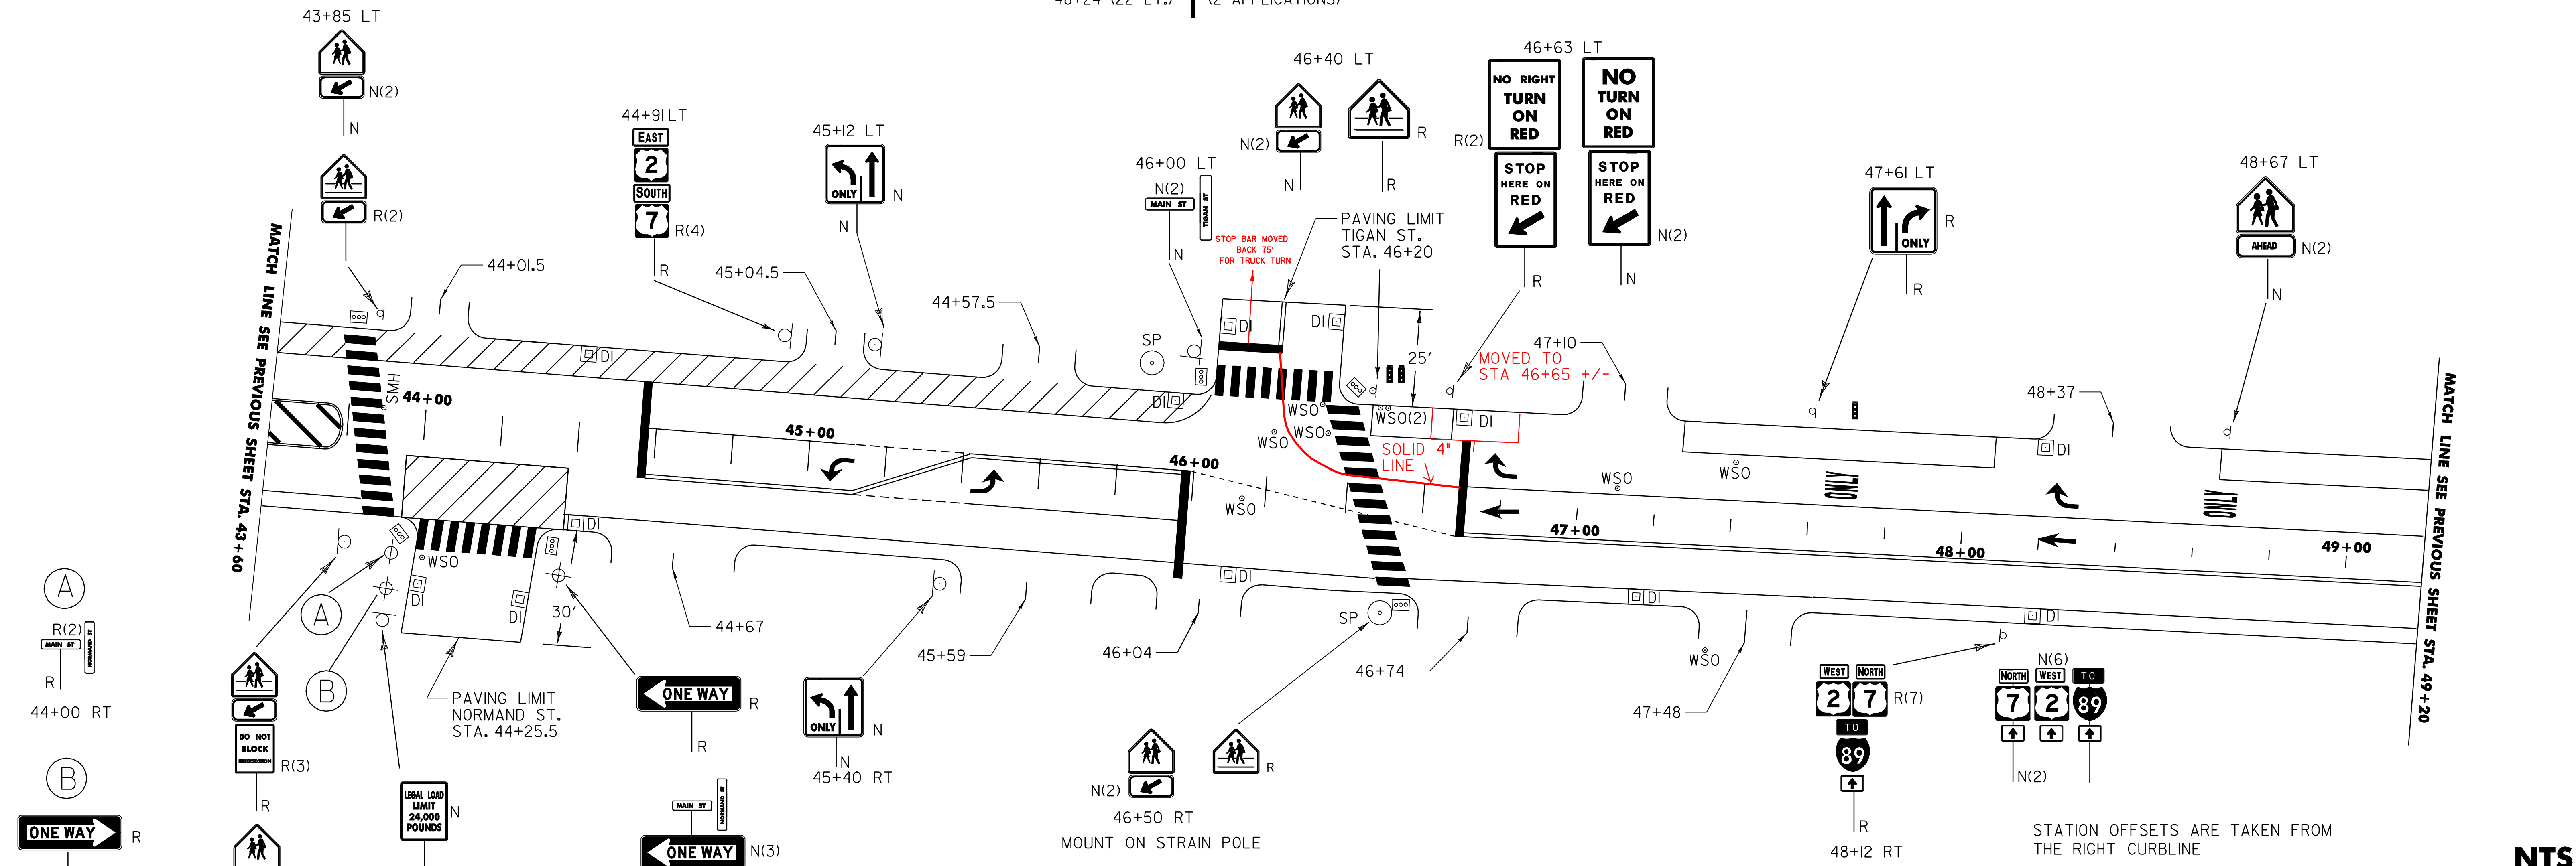

LEGEND

R = REMOVE
N = NEW
[Symbol] = DETECTABLE WARNING SURFACE
SP = STRAIN POLE

PROJECT LAYOUT SHEET 6

PROJECT NAME: WINOOSKI	PLOT DATE: 18-JAN-2008 14:43
PROJECT NUMBER: STP 2306(1)S	DRAWN BY: WILDER
FILE NAME: /pave /05d144 /p05d144.dgn	CHECKED BY: PAVT MGMT
PROJECT LEADER: WOOLAVER	SHEET 12 OF 23
IPARM NAME: p05d144106.i	

NTS