


TYPICAL REPRESENTATIVE SECTION - MAINLINE-RAMPS THROUGH S.P.D.I.

REPRESENTATIVE SECTION ONLY - ROUTE 9 : ROUTE 7 SPDI
FOR FULL BUILD OF NORTHBOUND

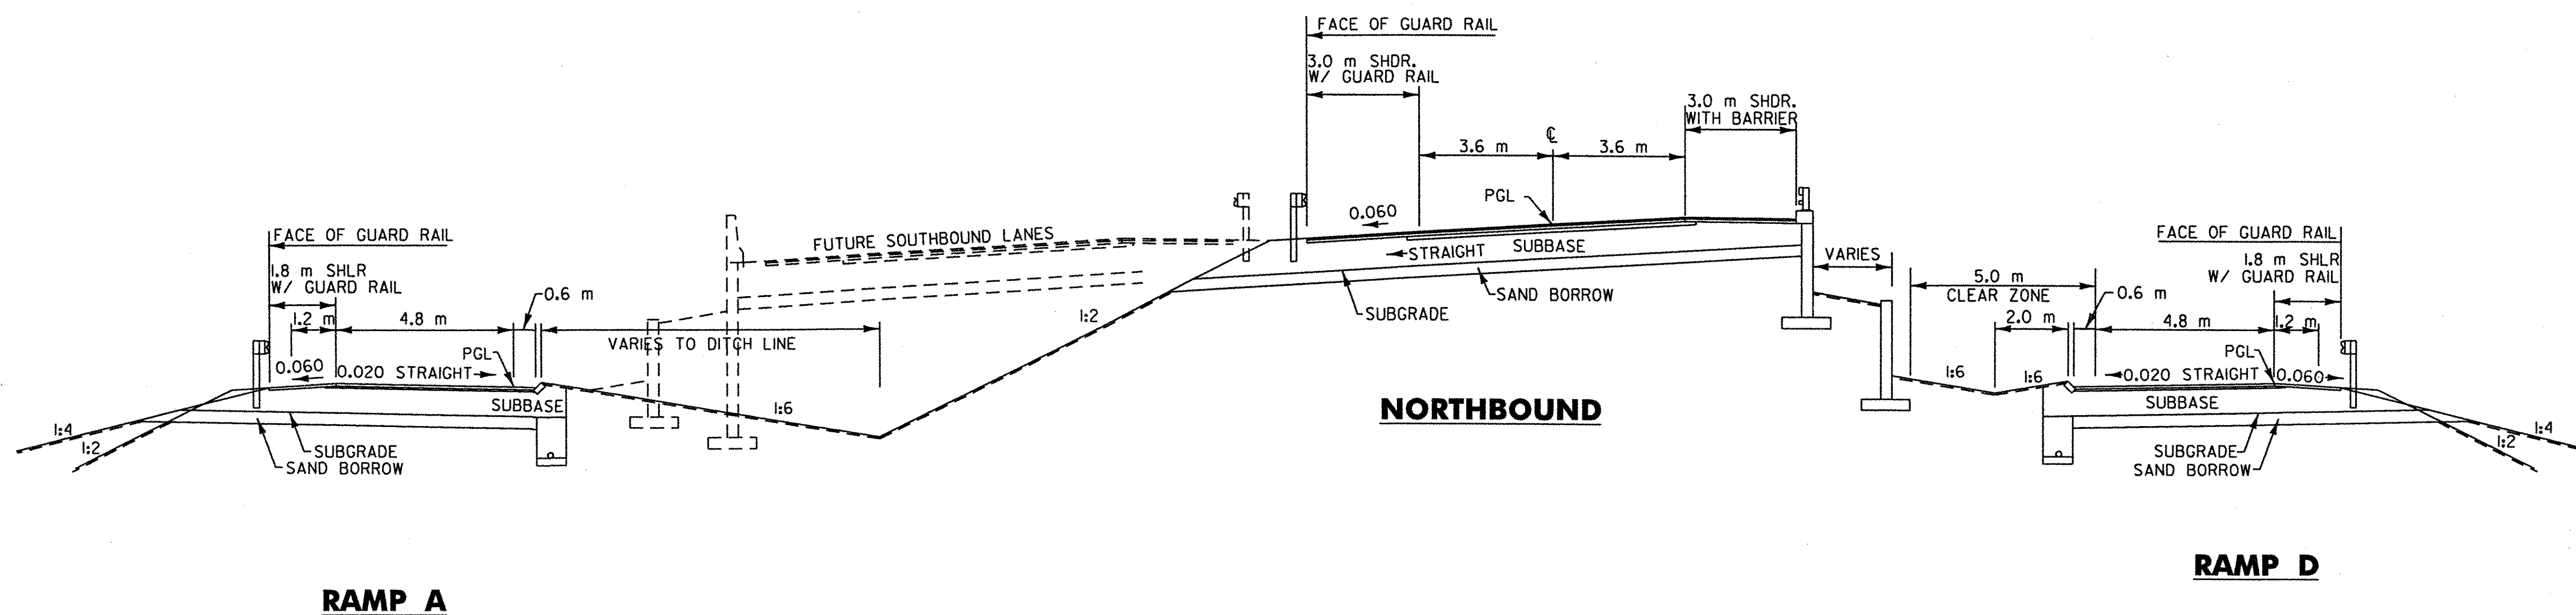

K:\6380020 (Benn)\Highway\PlotFiles\typicals.ptf

PGL=PROFILE GRADE LINE

| | |
|--|---|
| VERMONT AGENCY OF TRANSPORTATION | |
| | PROJECT NAME: BENNINGTON |
| | PROJECT NUMBER: NH F019-1(5) REVISED |
| FILE NAME: ...Highway\PlotFiles\typicals.ptf | PLOT DATE: 11/9/2004 |
| DESIGN SUPERVISOR: GREG EDWARDS | DRAWN BY: DUFRESNE-HENRY |
| DESIGNED BY: MARC FOISY | CHECKED BY: GARY SANTY |
| TYPICAL TS-04 | SHEET 6 OF 112 |