



MAINLINE TIE DATA

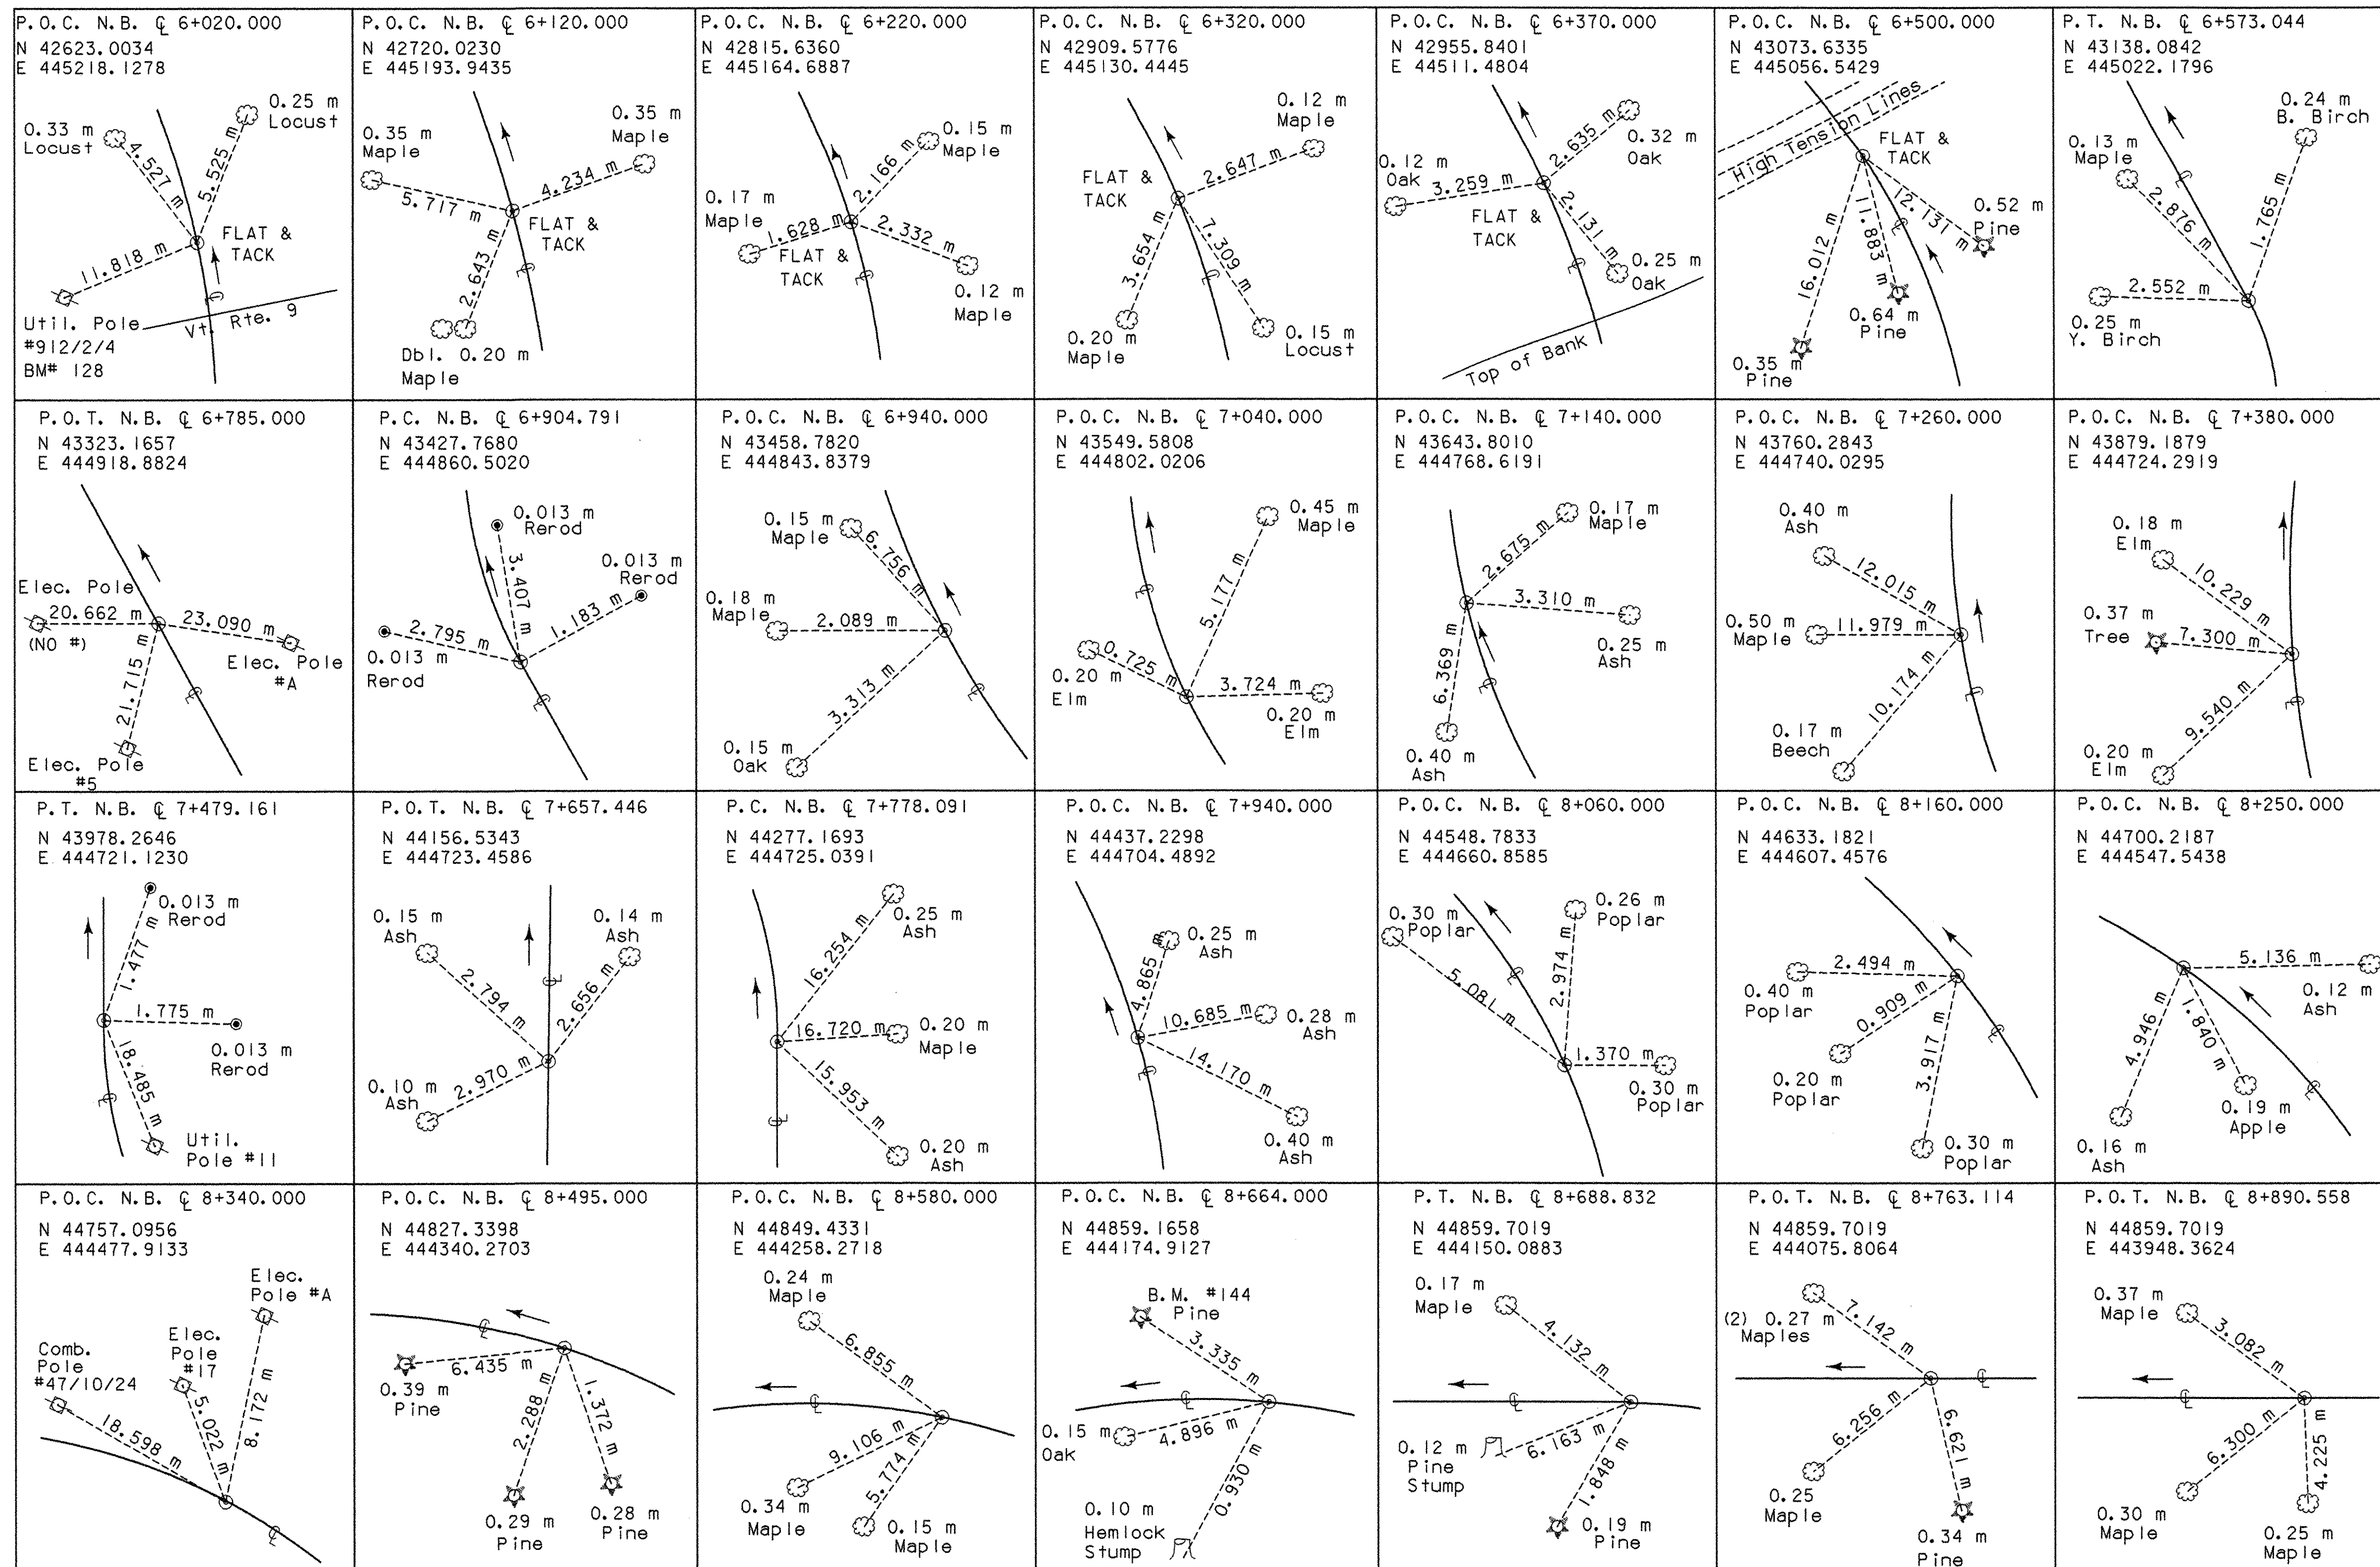

NORTH IS
COMMON TO
ALL INSERTS

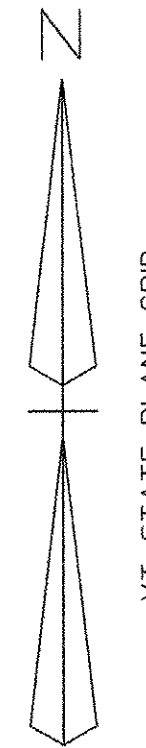

CONTROL TIE SHEET CT-1	PROJECT NAME: BENNINGTON BYPASS	PROJECT NUMBER: NH FO19-1(5)
	DESIGN FILE NAME: c:\dh\bennington\row	PLOT DATE: 07-28-05
	PROJECT LEADER: JDP	DRAWN BY: MBB CHECKED BY: GAK
SHEET: 19 OF 112		