


+0.080
 +0.060
 +0.040
 +0.020
 LEVEL
 -0.020
 -0.040
 -0.060
 -0.080

NOTE: FINISH GRADE SHOWN IS FOR FUTURE BUILD III. THIS PROJECT WILL BUILD TO SUBGRADE TO STATION NB 6+574.000

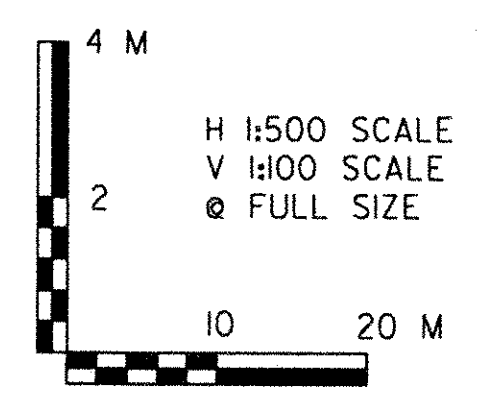

VERMONT AGENCY OF TRANSPORTATION

DH
Dufresne-Henry

PROJECT NAME: BENNINGTON
PROJECT NUMBER: NH F019-1(5)

FILE NAME: ...PlotFiles\Profiles\mlpro05.pft
DESIGN SUPERVISOR: GREG EDWARDS
DESIGNED BY: MARC FOISY
NORTHBOUND - PR-1

REVISED

PLOT DATE: 11/23/2004
DRAWN BY: DUFRESNE-HENRY
CHECKED BY: GARY SANTY
SHEET 30 OF 112

K:\E80020_bennNHHighway\PlotFiles\Profiles\mlpro05.pft