


LEVEL
 +0.080
 +0.060
 +0.040
 +0.020
 -0.020
 -0.040
 -0.060
 -0.080

K:\6380020 (Bennington Highway) Proj Files\A\Prof Files\mipr006.dwg

NOTE: FINISH GRADE SHOWN IS FOR FUTURE BUILD III. THIS PROJECT WILL BUILD TO SUBGRADE TO STATION NB 6+574.000

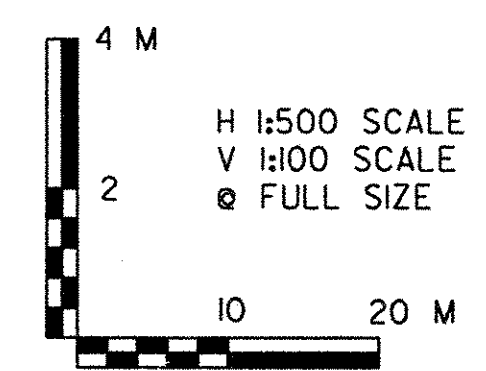

VERMONT AGENCY OF TRANSPORTATION	
	PROJECT NAME: BENNINGTON
	PROJECT NUMBER: NH F019-1(5)
FILE NAME: ...\mipr006.pxf	PLOT DATE: 05/27/2003
DESIGN SUPERVISOR: GREG EDWARDS	DRAWN BY: DUFRESNE-HENRY
DESIGNED BY: BJM/MARC FOISY	CHECKED BY: GARY SANTY
NORTHBOUND - PR-2	SHEET 31 OF 112