


K:\ASB0020\Benn\Highway\Profile\Files\Profile\pr07.dwg

NOTE: FINISH GRADE SHOWN IS FOR FUTURE BUILD III. THIS PROJECT WILL BUILD TO SUBGRADE TO STATION NB 6+574.000

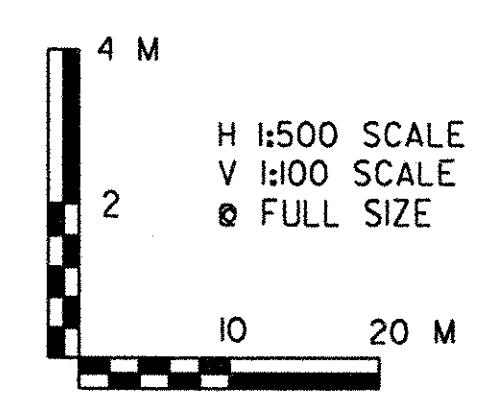

<b>VERMONT AGENCY OF TRANSPORTATION</b>	
	PROJECT NAME: BENNINGTON
	PROJECT NUMBER: NH F019-1(5)
FILE NAME: ...\mplpro07.prf	PLOT DATE: 05/27/2003
DESIGN SUPERVISOR: GREG EDWARDS	DRAWN BY: DUFRESNE-HENRY
DESIGNED BY: BJM/MARC FOISY	CHECKED BY: GARY SANTY
<b>NORTHBOUND - PR-3</b>	SHEET 32 OF 112