


LEVEL
+0.080
+0.060
+0.040
+0.020
-0.020
-0.040
-0.060
-0.080

R:\6380020 (Bennington)Highway\PlotFiles\VRofFinal\mplpro08.prf

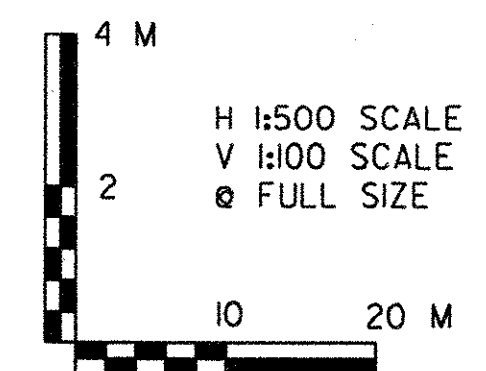

VERMONT AGENCY OF TRANSPORTATION

PROJECT NAME: BENNINGTON	PLOT DATE: 05/27/2003
PROJECT NUMBER: NH F019-1(5)	DRAWN BY: DUFRESNE-HENRY
FILE NAME: ...\mplpro08.prf	CHECKED BY: GARY SANTY
DESIGN SUPERVISOR: GREG EDWARDS	SHEET 33 OF 112
DESIGNED BY: BJM/MARC FOISY	

NORTHBOUND - PR-4