


K:\6380020 (Bennington)Highway\Profile\Profiles\mp010.prf



VERMONT AGENCY OF TRANSPORTATION

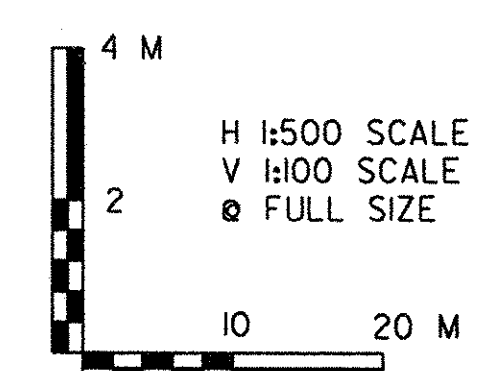

PROJECT NAME: BENNINGTON
 PROJECT NUMBER: NH F019-K(5)
 FILE NAME: ...\mp010.prf
 DESIGN SUPERVISOR: GREG EDWARDS
 DESIGNED BY: BJM/MARC FOISY
 NORTHBOUND - PR-6
 PLOT DATE: 05/27/2003
 DRAWN BY: DUFRESNE-HENRY
 CHECKED BY: GARY SANTY
 SHEET 35 OF 112