


K:\3380020 (Benning)Highway\Profile\Files\Profile.mpr.plt

LEVEL  
+0.080  
+0.060  
+0.040  
+0.020  
-0.020  
-0.040  
-0.060  
-0.080



**VERMONT AGENCY OF TRANSPORTATION**

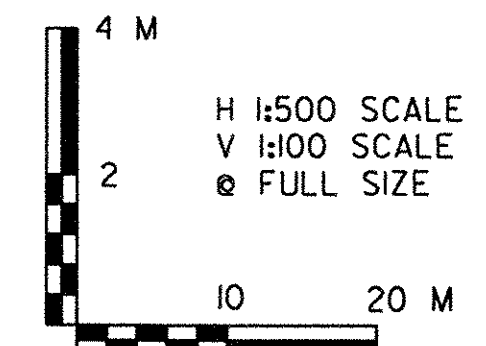

PROJECT NAME: BENNINGTON	PLOT DATE: 05/27/2003
PROJECT NUMBER: NH FO19-1(5)	DRAWN BY: DUFRESNE-HENRY
FILE NAME: ...\mproll.plt	DESIGNED BY: GARY SANTY
DESIGN SUPERVISOR: GREG EDWARDS	CHECKED BY: GARY SANTY
DESIGNED BY: BJM/MARC FOISY	SHEET 36 OF 112
<b>NORTHBOUND - PR-7</b>	