

LEVEL  
 +0.080  
 +0.060  
 +0.040  
 +0.020  
 -0.020  
 -0.040  
 -0.060  
 -0.080


STA. = NB 8+120  
 e = 0.078

STA. = NB 8+420  
 e = 0.078

RIGHT e = +0.078

CONST. CL (PGL)

LEFT e = -0.078

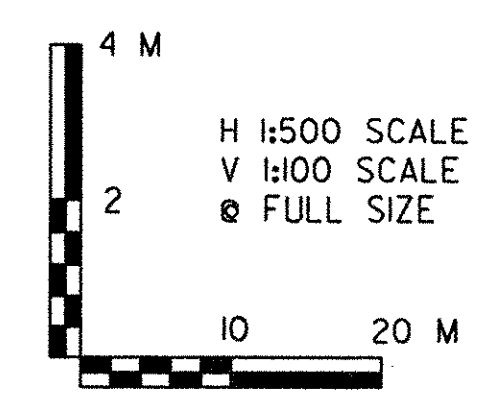

**VERMONT AGENCY OF TRANSPORTATION**



PROJECT NAME: BENNINGTON  
 PROJECT NUMBER: NH FO19-1(5)  
 FILE NAME: ...\mproj2.ptf  
 DESIGN SUPERVISOR: GREG EDWARDS  
 DESIGNED BY: BJM/MARC FOISY  
 NORTHBOUND - PR-8  
 PLOT DATE: 05/27/2003  
 DRAWN BY: DUFRESNE-HENRY  
 CHECKED BY: GARY SANTY  
 SHEET 37 OF 112

K:\6380020 (Benning Highway)\Plot Files\A\Pro Files\mproj2.ptf