


K:\638020\Bennington\Highway\PlotFiles\Profile\VTConnector.plt

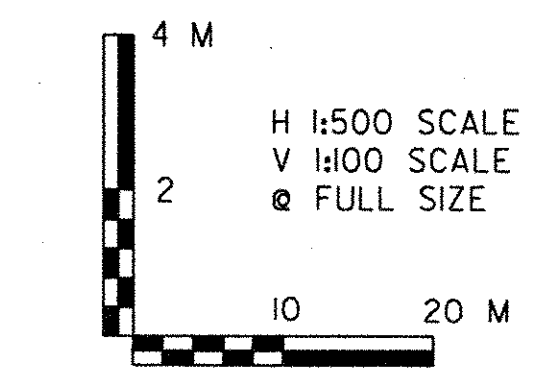

VERMONT AGENCY OF TRANSPORTATION	
	PROJECT NAME: BENNINGTON PROJECT NUMBER: NH FO19-1(5)
	REVISED
FILE NAME: ...Profiles\RT7Connector.plt DESIGN SUPERVISOR: GREG EDWARDS DESIGNED BY: MARC FOISY	PLOT DATE: 11/20/2004 DRAWN BY: DUFRESNE-HENRY CHECKED BY: GARY SANTY
ROUTE 7 CONNECTOR - PR-23	

STA. = CN 1+600