



POT STA. A 1+000.000=
POC STA. VT 1+345.000,495.0m LT.

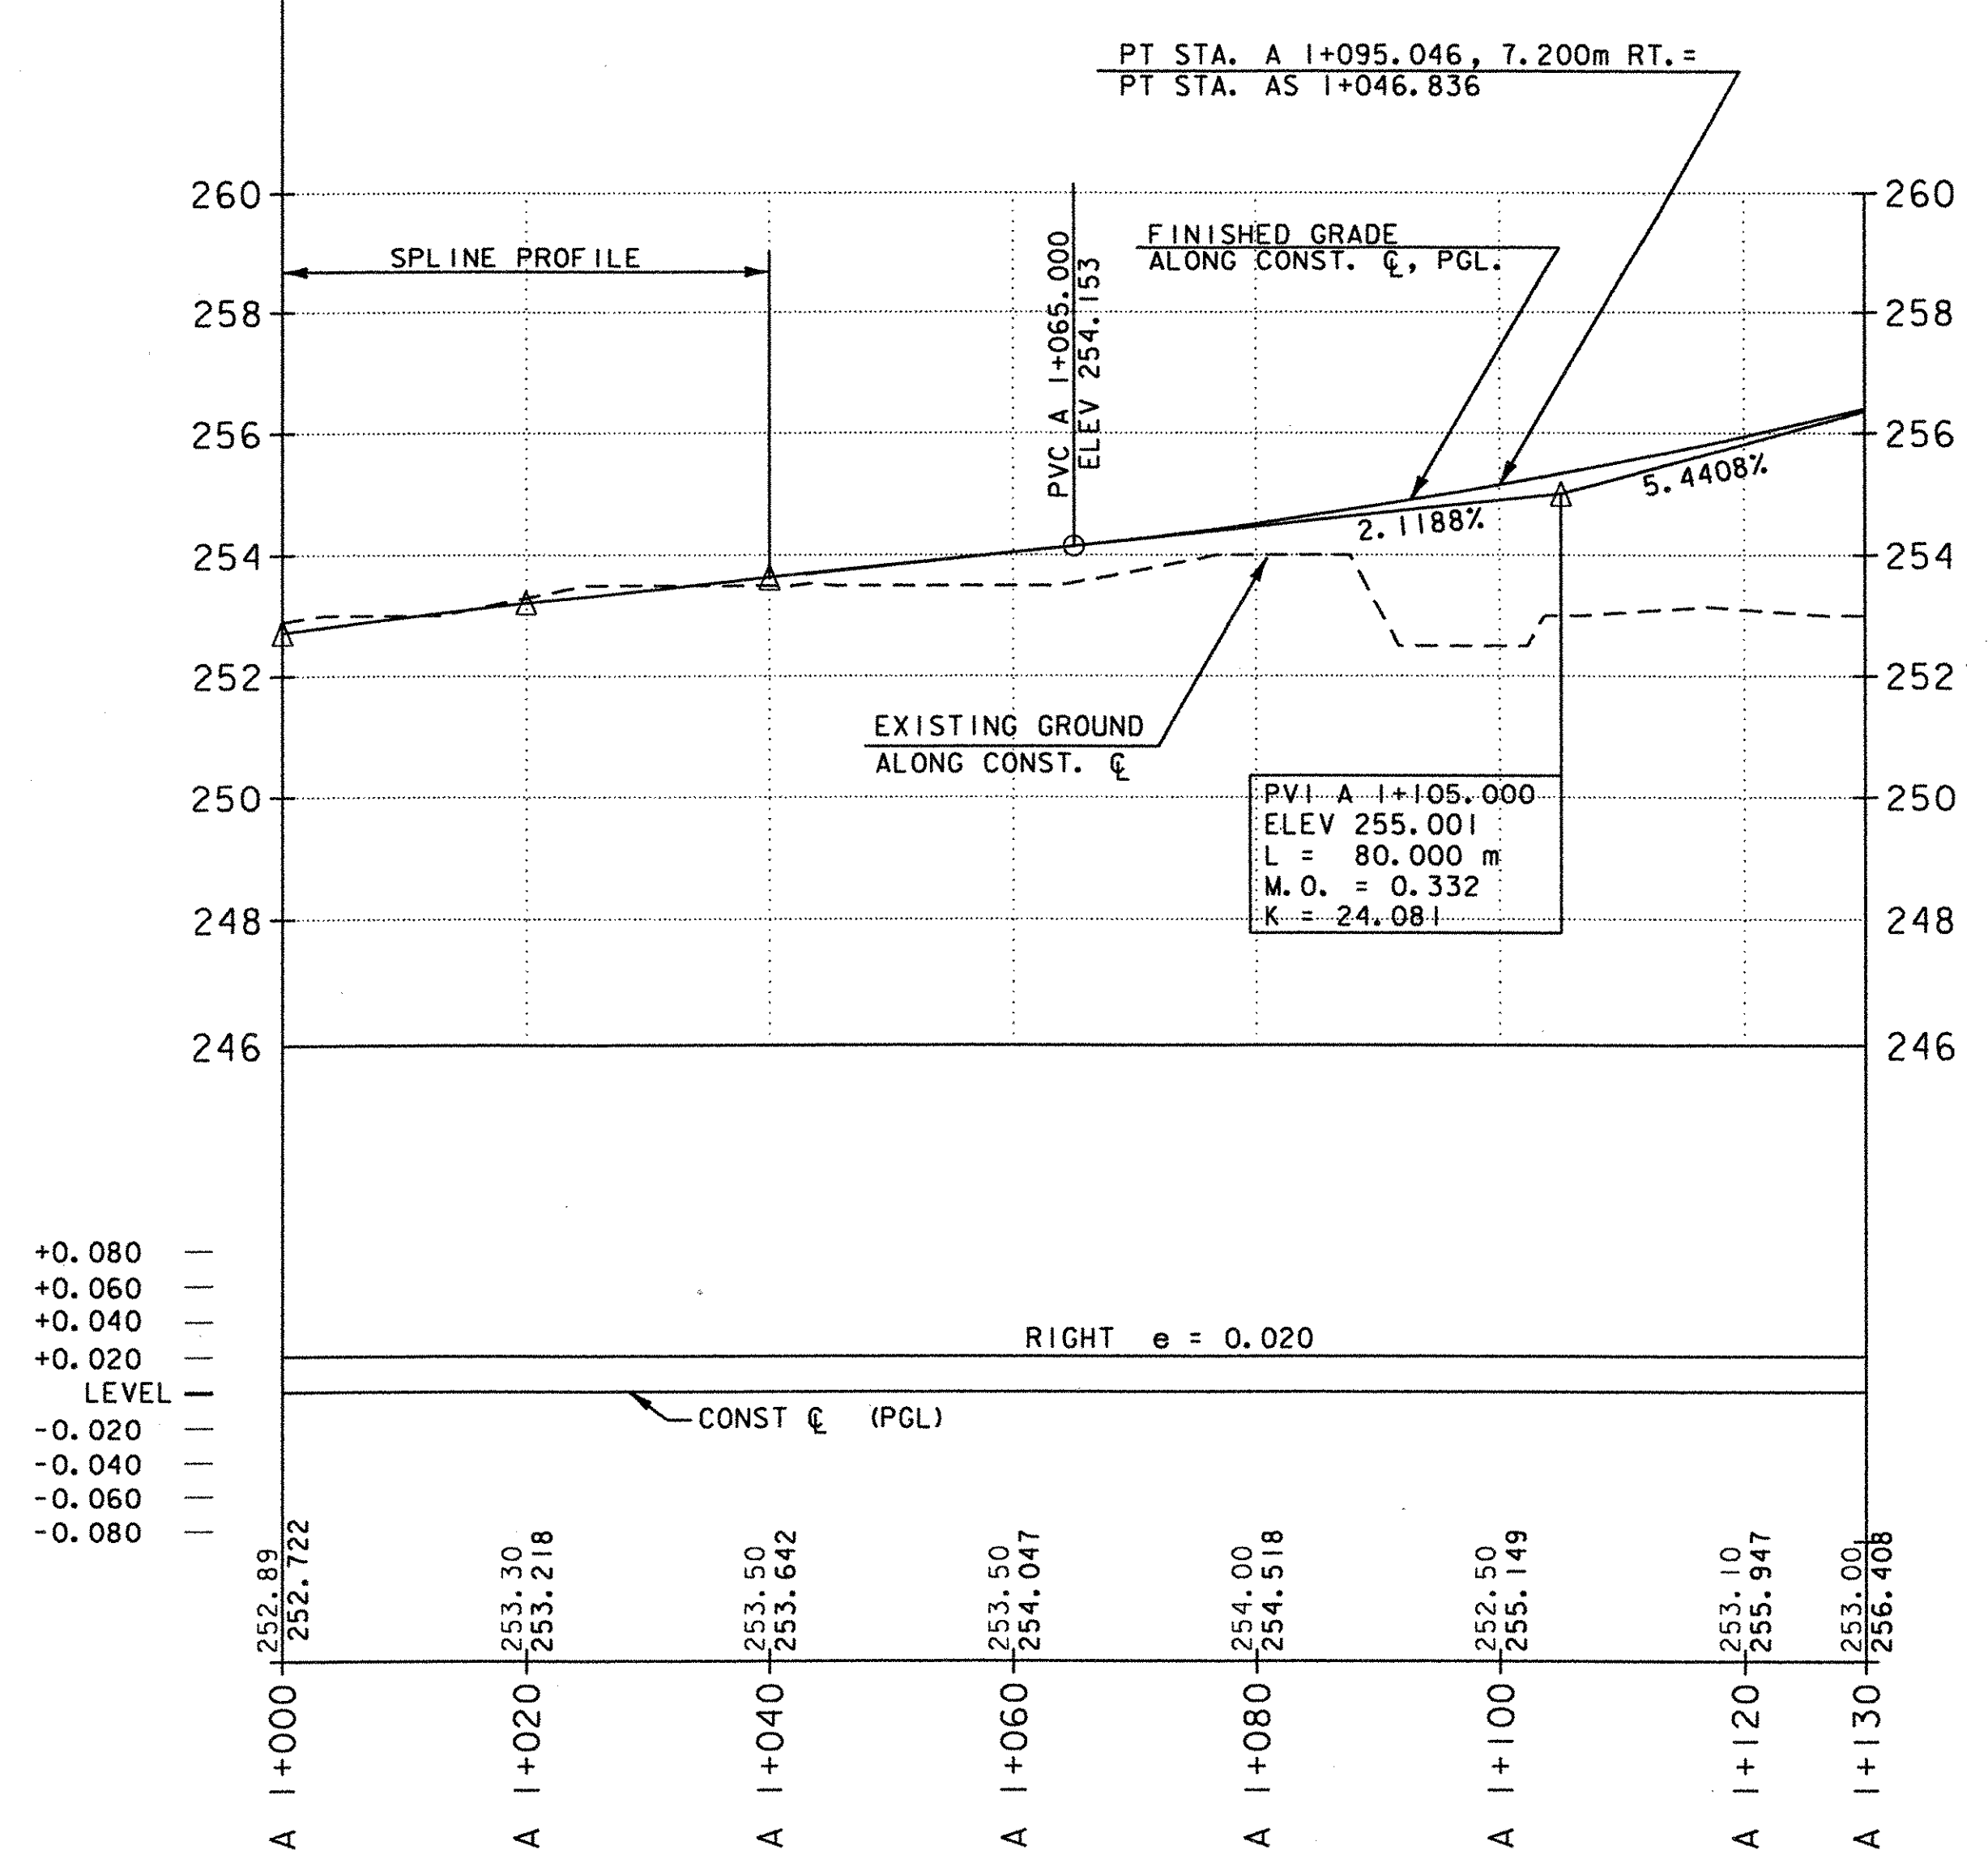

K:\6380020 (benn)\highway\plot files\profiles\ampc.prf

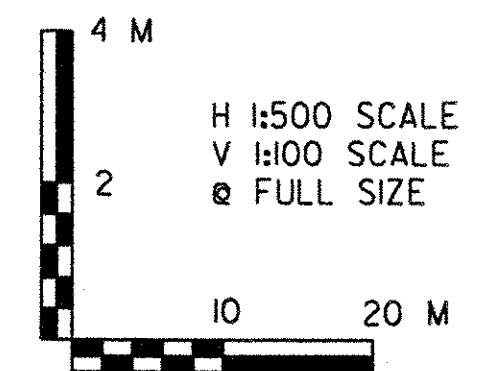

VERMONT AGENCY OF TRANSPORTATION	
DH Dufresne-Henry	PROJECT NAME: BENNINGTON
	PROJECT NUMBER: NH F019-1(5)
FILE NAME: ...rampa.prf	PLOT DATE: 05/27/2003
DESIGN SUPERVISOR: GREG EDWARDS	DRAWN BY: DUFRESNE-HENRY
DESIGNED BY: BJM/MARC FOISY	CHECKED BY: GARY SANTY
RAMP A - PR-33	SHEET 40 OF 112