


K:\636020 (Barn)Highway\ProFiles\ProFiles\RampD.pff

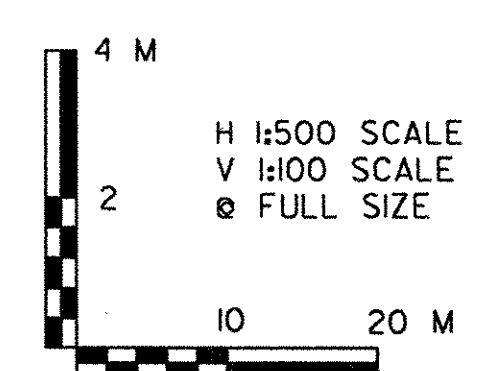

<b>VERMONT AGENCY OF TRANSPORTATION</b>	
	PROJECT NAME: BENNINGTON
	PROJECT NUMBER: NH FO19-K(5)
	FILE NAME: ...RampD.pff
	PLOT DATE: 05/28/2003
DESIGN SUPERVISOR: GREG EDWARDS	DRAWN BY: DUFRESNE-HENRY
DESIGNED BY: BJM/MARC FOISY	CHECKED BY: GARY SANTY
<b>RAMP D - PR-37</b>	SHEET 41 OF 112