


K:\A6380020 (Benn)\Highway\Profile\Files\RampK.plt

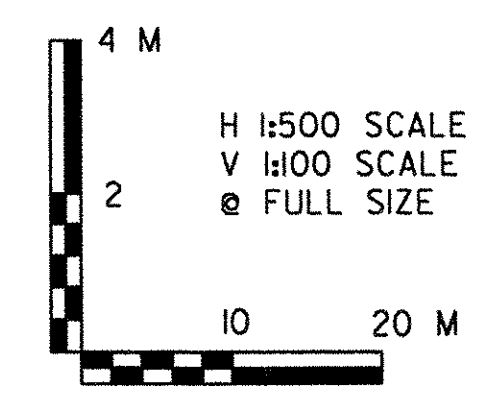

VERMONT AGENCY OF TRANSPORTATION

PROJECT NAME: BENNINGTON	PLOT DATE: 05/27/2003
PROJECT NUMBER: NH FO19-1(5)	DRAWN BY: DUFRESNE-HENRY
FILE NAME: ...RampK.plt	CHECKED BY: GARY SANTY
DESIGN SUPERVISOR: GREG EDWARDS	SHEET 42 OF 112
DESIGNED BY: BJM/MARC FOISY	
RAMP K - PR-45	