


K:\6380020 (Benn)\Highway\Plots\Files\Profile\K.ramp.k.plt

+0.080
 +0.060
 +0.040
 +0.020
 LEVEL
 -0.020
 -0.040
 -0.060
 -0.080

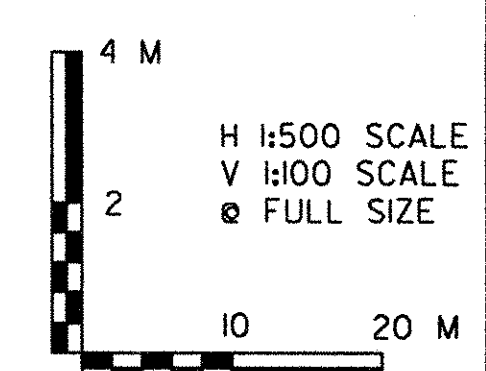

VERMONT AGENCY OF TRANSPORTATION	
PROJECT NAME: BENNINGTON	PLOT DATE: 05/27/2003
PROJECT NUMBER: NH F019-1(5)	DRAWN BY: DUFRESNE-HENRY
FILE NAME: ...RampK.plt	DESIGNED BY: GARY SANTY
DESIGN SUPERVISOR: GREG EDWARDS	CHECKED BY: GARY SANTY
DESIGNED BY: BJM/MARC FOISY	SHEET 43 OF 112
RAMP K - PR-46	