


K:\638020\Bennington\Highway\Profile\Files\VT9Profile.prf

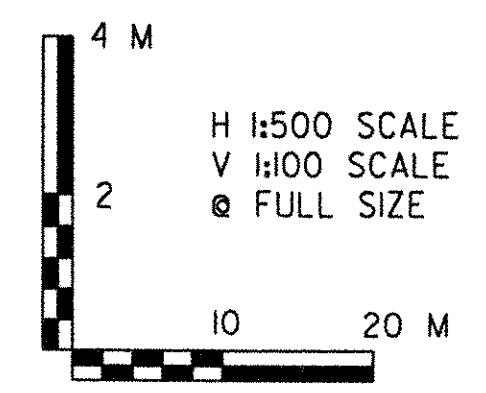

<b>VERMONT AGENCY OF TRANSPORTATION</b>	
<b>DH</b> Dufresne-Henry	PROJECT NAME: BENNINGTON
	PROJECT NUMBER: NH FO19-1(5)
FILE NAME: ...Profiles\VT9Profile.prf	PLOT DATE: 11/24/2004
DESIGN SUPERVISOR: GREG EDWARDS	DRAWN BY: DUFRESNE-HENRY
DESIGNED BY: MARC FOISY	CHECKED BY: GARY SANTY
<b>VT ROUTE 9 - PR-56</b>	<b>REVISED</b> SHEET 44 OF 112