


K:\6380020 (benn)\highway\plotfiles\profiles\chapel.dwg

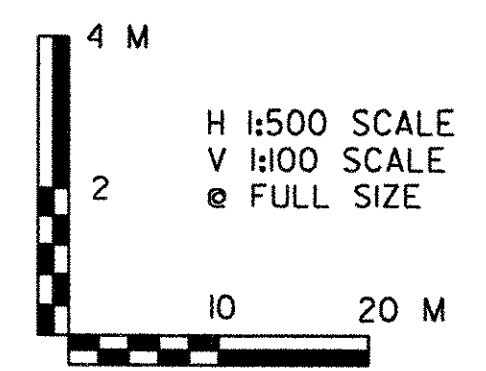

**VERMONT AGENCY OF TRANSPORTATION**

PROJECT NAME: BENNINGTON	PROJECT NUMBER: NH FO19-(K5)
FILE NAME: ...chapel.dwg	PLOT DATE: 05/27/2003
DESIGN SUPERVISOR: GREG EDWARDS	DRAWN BY: DUFRESNE-HENRY
DESIGNED BY: BJM/MARC FOISY	CHECKED BY: GARY SANTY
<b>CHAPEL ROAD - PR-58</b>	SHEET 46 OF 112