


+0.080
+0.060
+0.040
+0.020
LEVEL
-0.020
-0.040
-0.060
-0.080

K:\6380020\benm\highway\profile\files\profiles\east.prf

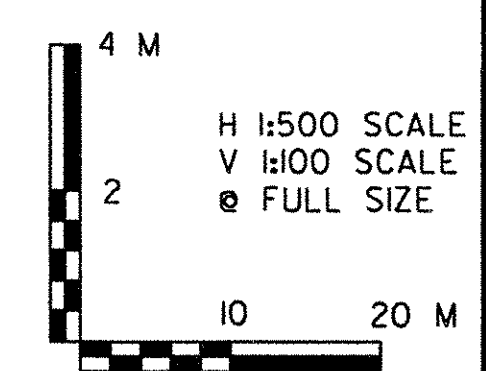

VERMONT AGENCY OF TRANSPORTATION

DH
Dufresne-Henry

PROJECT NAME: BENNINGTON
PROJECT NUMBER: NH F019-K(5)

FILE NAME: ...east.prf
DESIGN SUPERVISOR: GREG EDWARDS
DESIGNED BY: BJM/MARC FOISY
EAST ROAD - PR-60

PLOT DATE: 05/27/2003
DRAWN BY: DUFRESNE-HENRY
CHECKED BY: GARY SANTY
SHEET 48 OF 112