


LINES SHOWN ON THIS PLAN AS EXISTING PROPERTY LINES P/L ARE BELIEVED TO BE ACCURATE BUT SHOULD NOT BE RELIED UPON FOR PURPOSES UNRELATED TO THE STATE OF VERMONT'S ACQUISITION OF LAND AND RIGHTS FOR THIS PROJECT.

THIS SHEET TO BE USED FOR RIGHT-OF-WAY INFORMATION ONLY

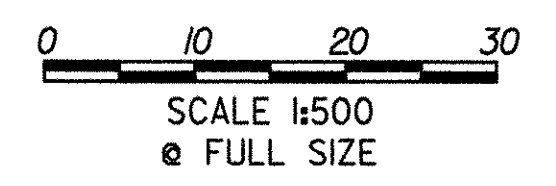

R.O.W. PLAN ROW-2	PROJECT NAME: BENNINGTON BYPASS	PROJECT NUMBER: NH FO19-1(5)
	DESIGN FILE NAME: c:\dh\bennington\row	PLOT DATE: 11-02-05
	PROJECT LEADER: JDP	DRAWN BY: MBB CHECKED BY: GAK
		SHEET: 65 OF 112

DATUM
VERTICAL NAVD 88
HORIZONTAL NAD 83 (1992)