



CURVE NB5	CURVE SB5	CURVE A3	CURVE D2	CURVE VRI
Δ = 55°24'30.7" LT. R. = 1900.000m T. = 997.703m L. = 1837.417m E. = 246.022m BANK = 0.032 PI STA. NB5+733.330 N = 42266.8841 E = 445508.4114 PCC N = 41372.0092 E = 445067.2651 PT N = 43138.0842 E = 445022.1796	Δ = 60°16'16.5" LT. R. = 1820.000m T. = 1056.530m L. = 1914.516m E. = 284.437m BANK = 0.032 PI STA. SB5+743.932 N = 42277.9017 E = 445532.0537 PCC N = 41350.4354 E = 445026.0287 PT N = 43177.2504 E = 444977.5929	Δ = 5°39'26.0" LT. R. = 450.000m T. = 22.234m L. = 44.432m E. = 0.549m BANK = 0.020 PI STA. A1+644.917 N = 43175.8508 E = 444991.7992 PC N = 43155.1242 E = 444999.8463 PT N = 43195.6832 E = 444981.7481	Δ = 13°35'37.7" LT. R. = 1375.000m T. = 163.883m L. = 326.228m E. = 9.732m BANK = 0.020 PI STA. D1+326.502 N = 42897.6240 E = 445165.6290 PC N = 42739.9592 E = 445210.3454 PT N = 43040.3620 E = 445085.1082	Δ = 76°07'56.8" RT. R. = 15.000m T. = 11.747m L. = 19.931m E. = 4.052m BANK = N/A PI STA. VRI+030.968 N = 43224.4220 E = 445027.0230 PC N = 43228.7195 E = 445037.9559 PT N = 43234.0062 E = 445020.2304

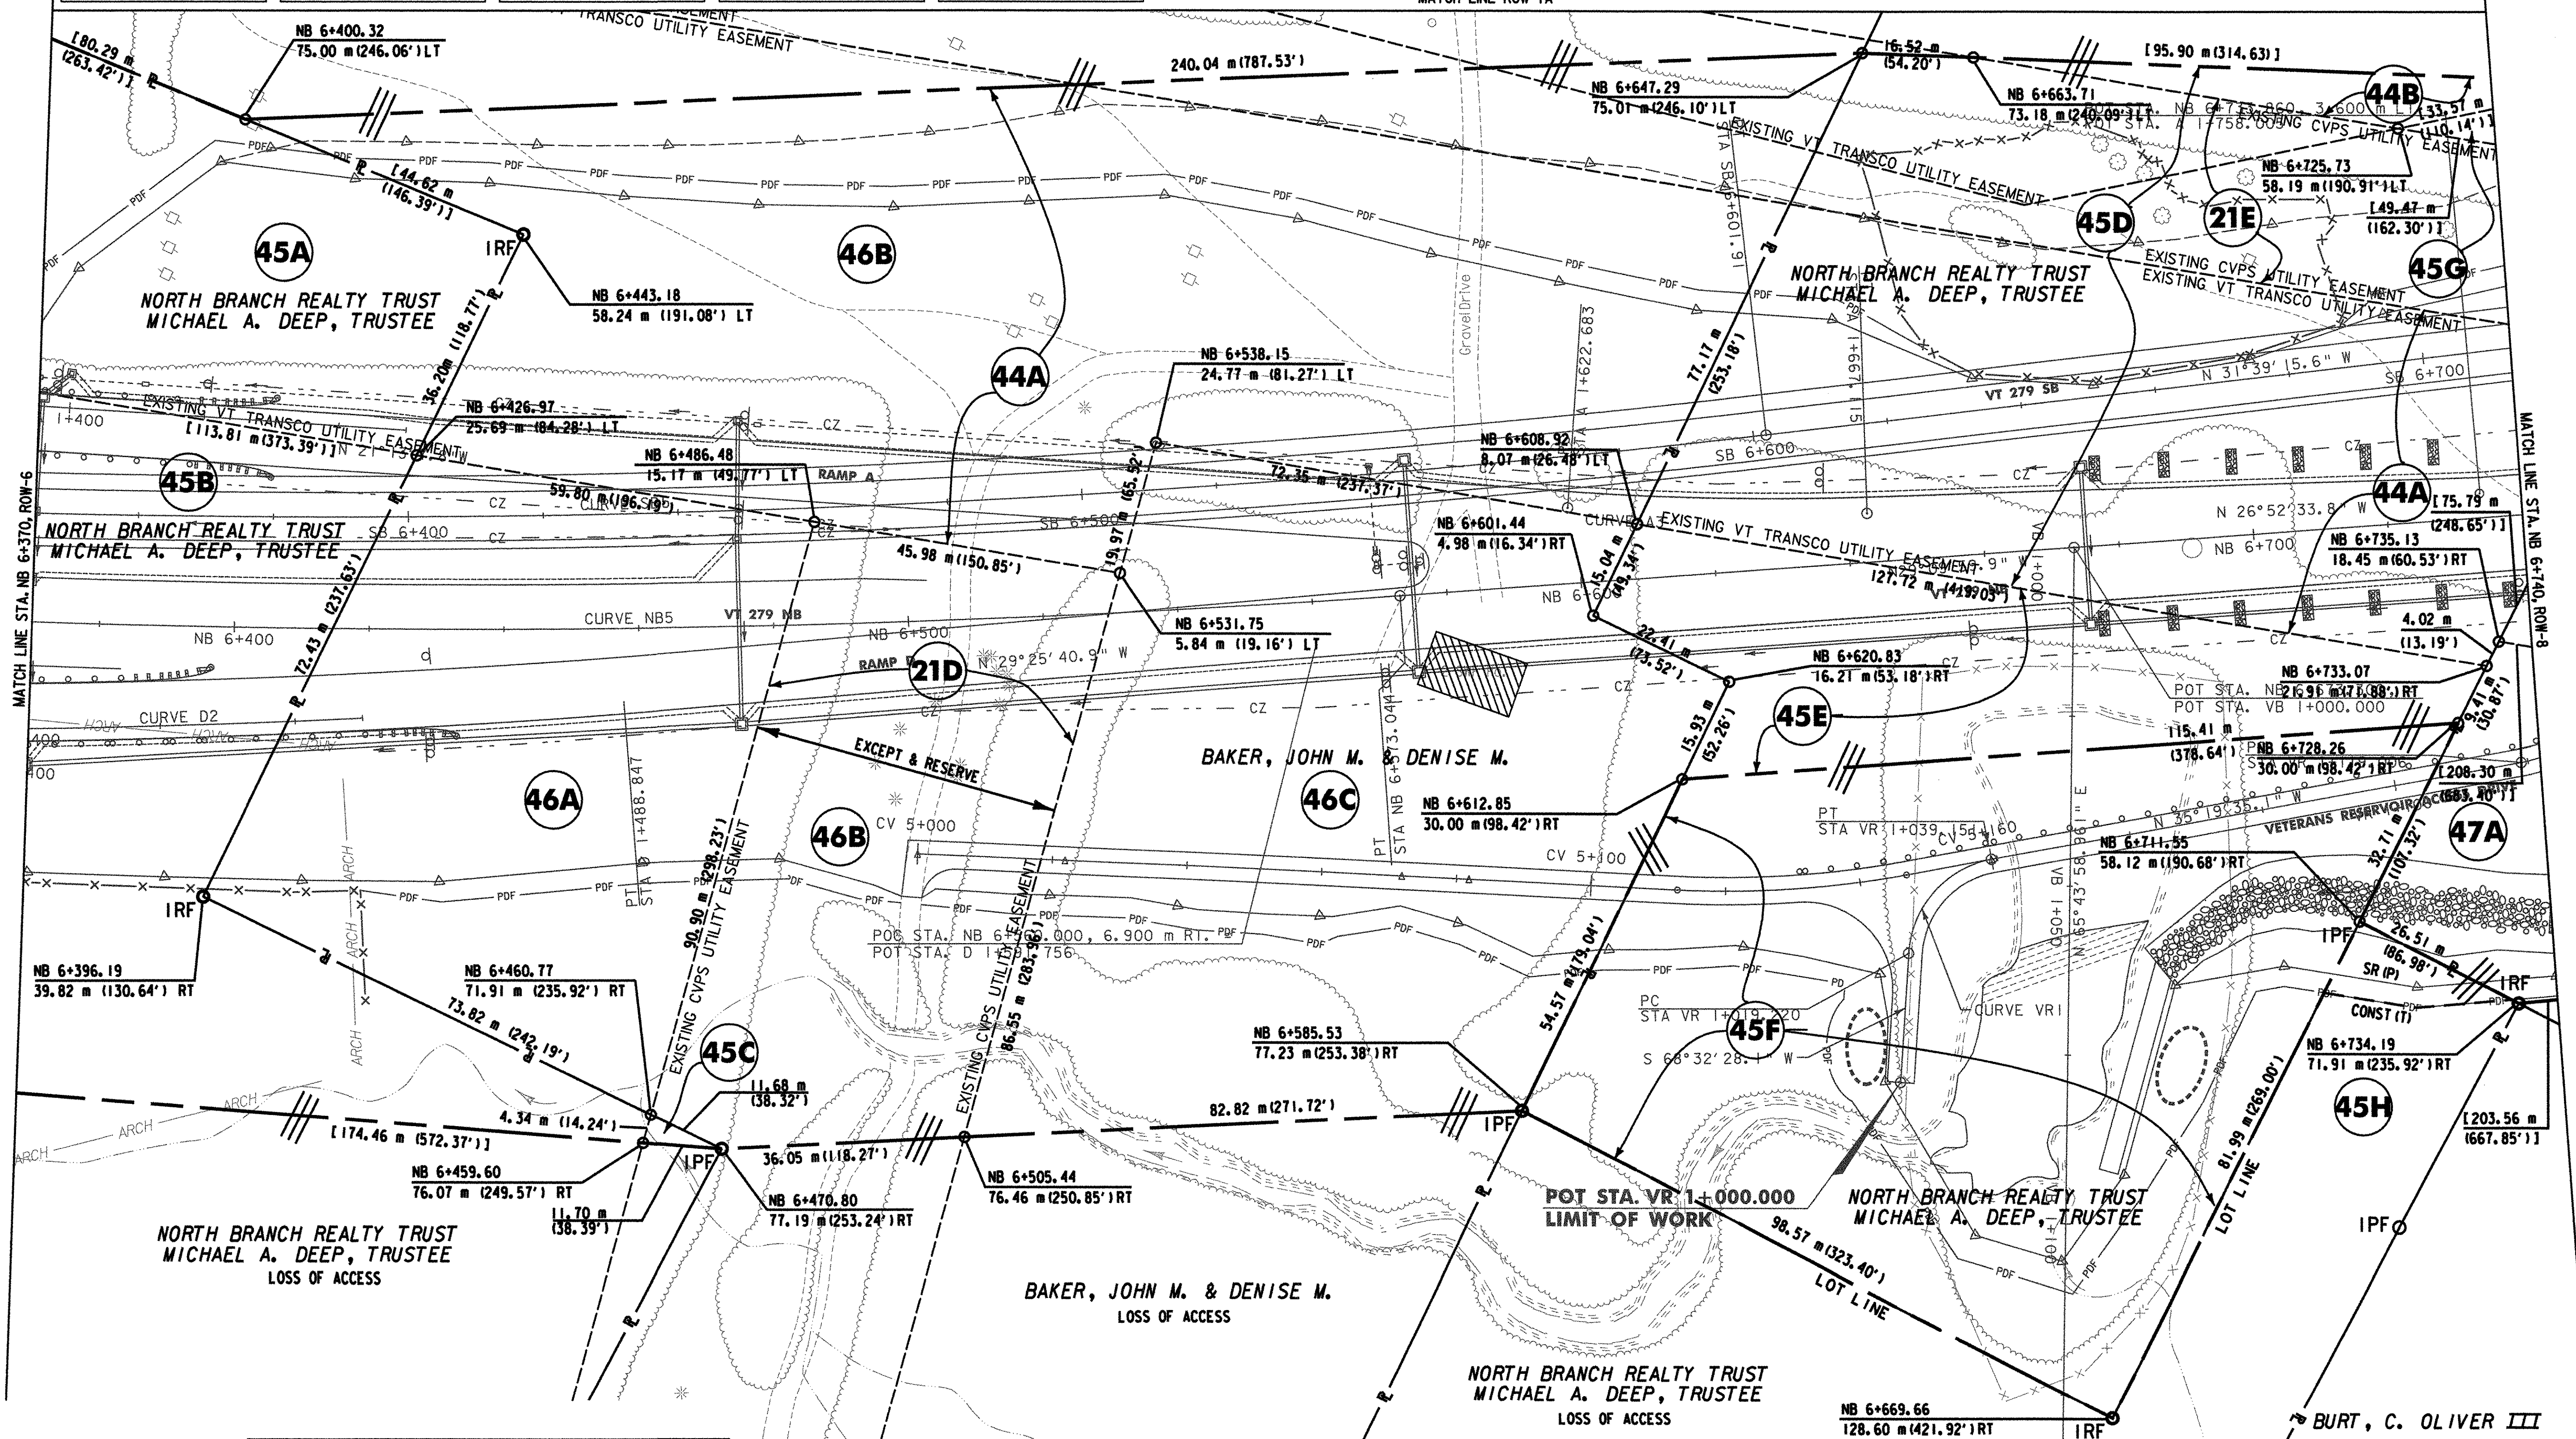

LINES SHOWN ON THIS PLAN AS EXISTING PROPERTY LINES P/L ARE BELIEVED TO BE ACCURATE BUT SHOULD NOT BE RELIED UPON FOR PURPOSES UNRELATED TO THE STATE OF VERMONT'S ACQUISITION OF LAND AND RIGHTS FOR THIS PROJECT.

THIS SHEET TO BE USED FOR RIGHT-OF-WAY INFORMATION ONLY

DATUM
VERTICAL NAVD 88
HORIZONTAL NAD 83 (1992)

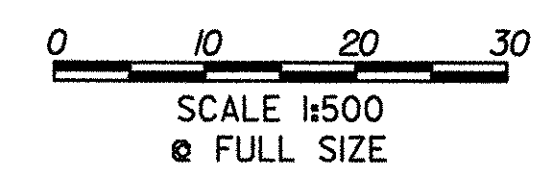

R.O.W. PLAN
ROW-7

PROJECT NAME: BENNINGTON BYPASS
DESIGN FILE NAME: c:\dh\bennington\row
PROJECT LEADER: JDP

PROJECT NUMBER: NH FO19-(K5)
PLOT DATE: 3-26-07
DRAWN BY: MBB
CHECKED BY: GAK