




97+50

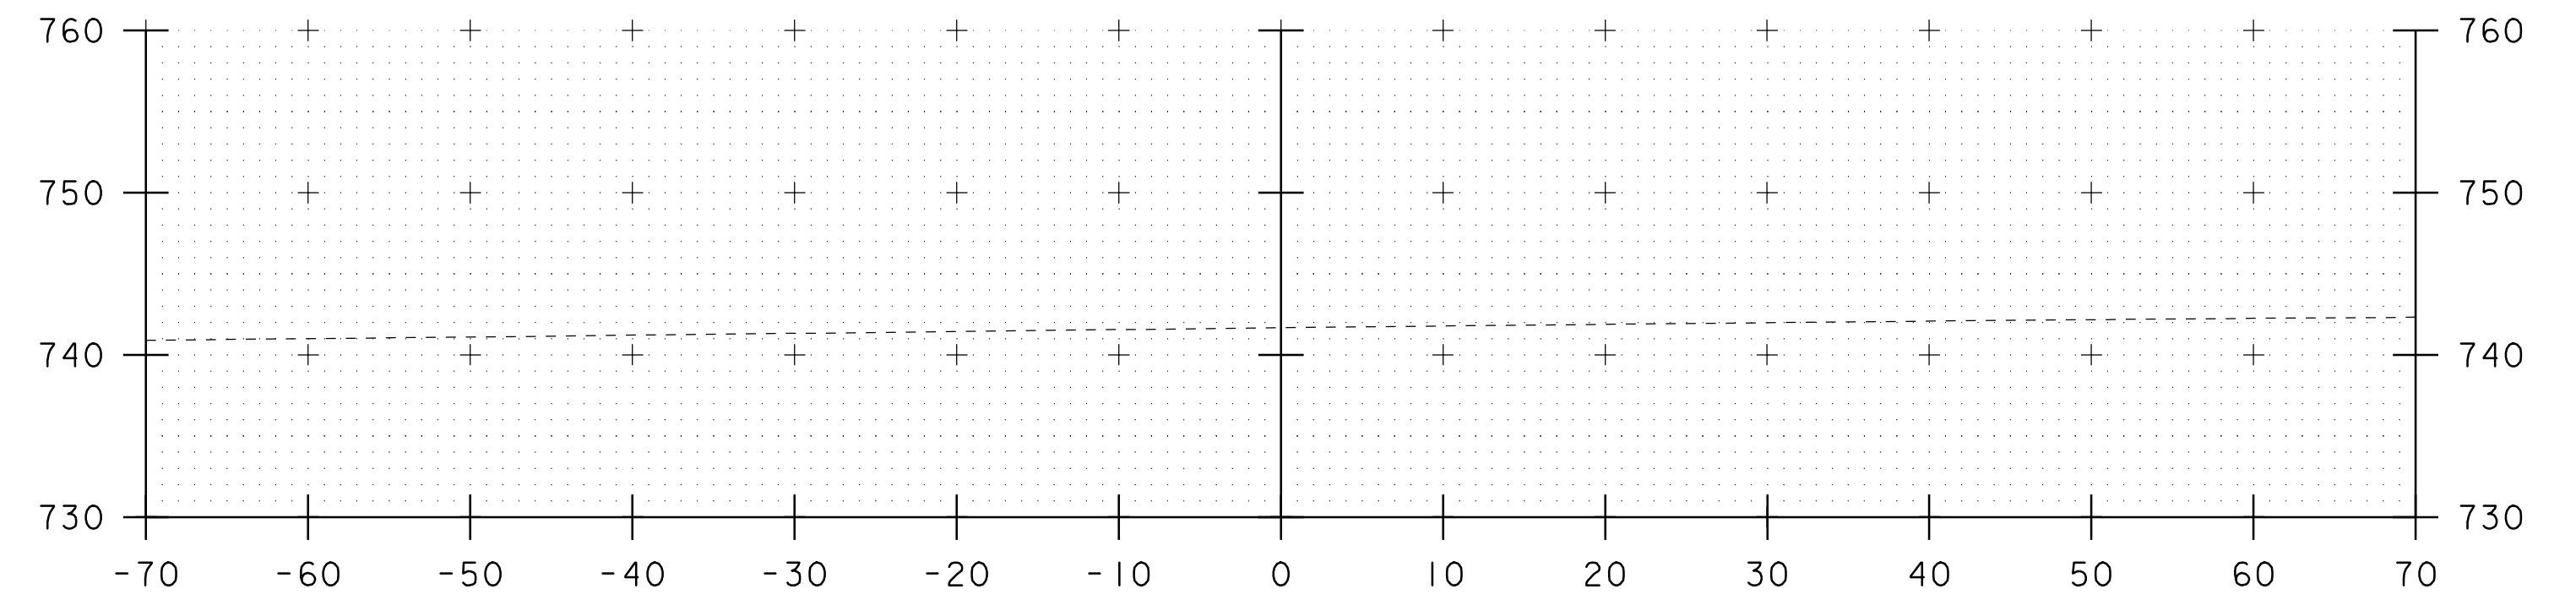


99+00

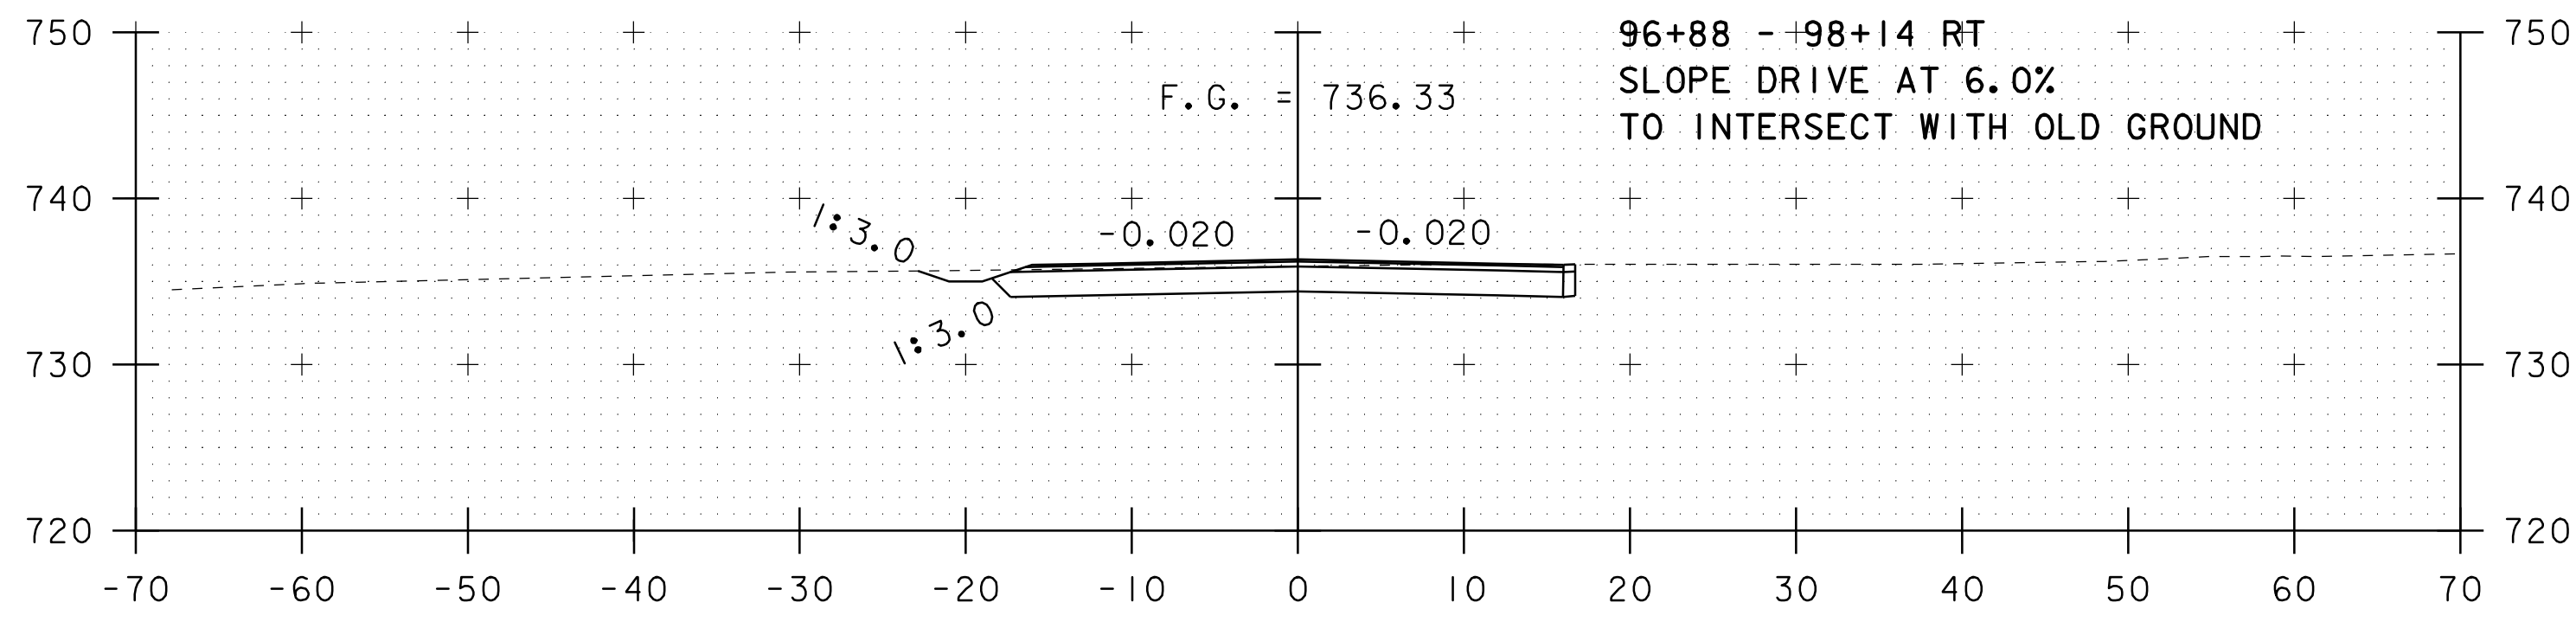


97+00

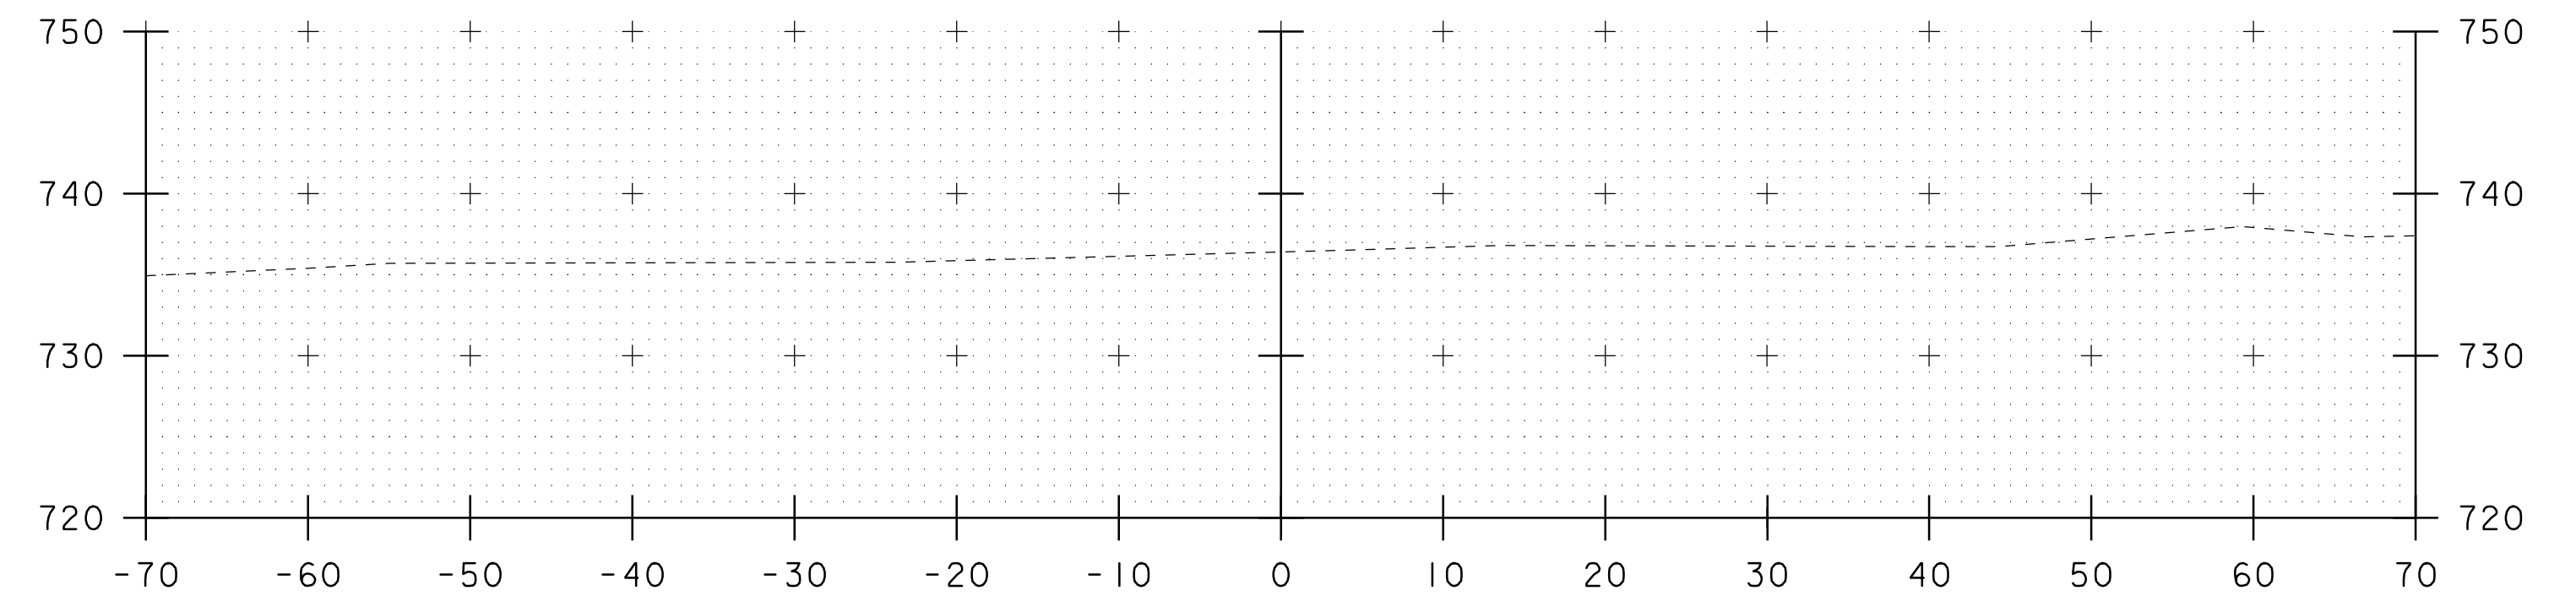

98+50

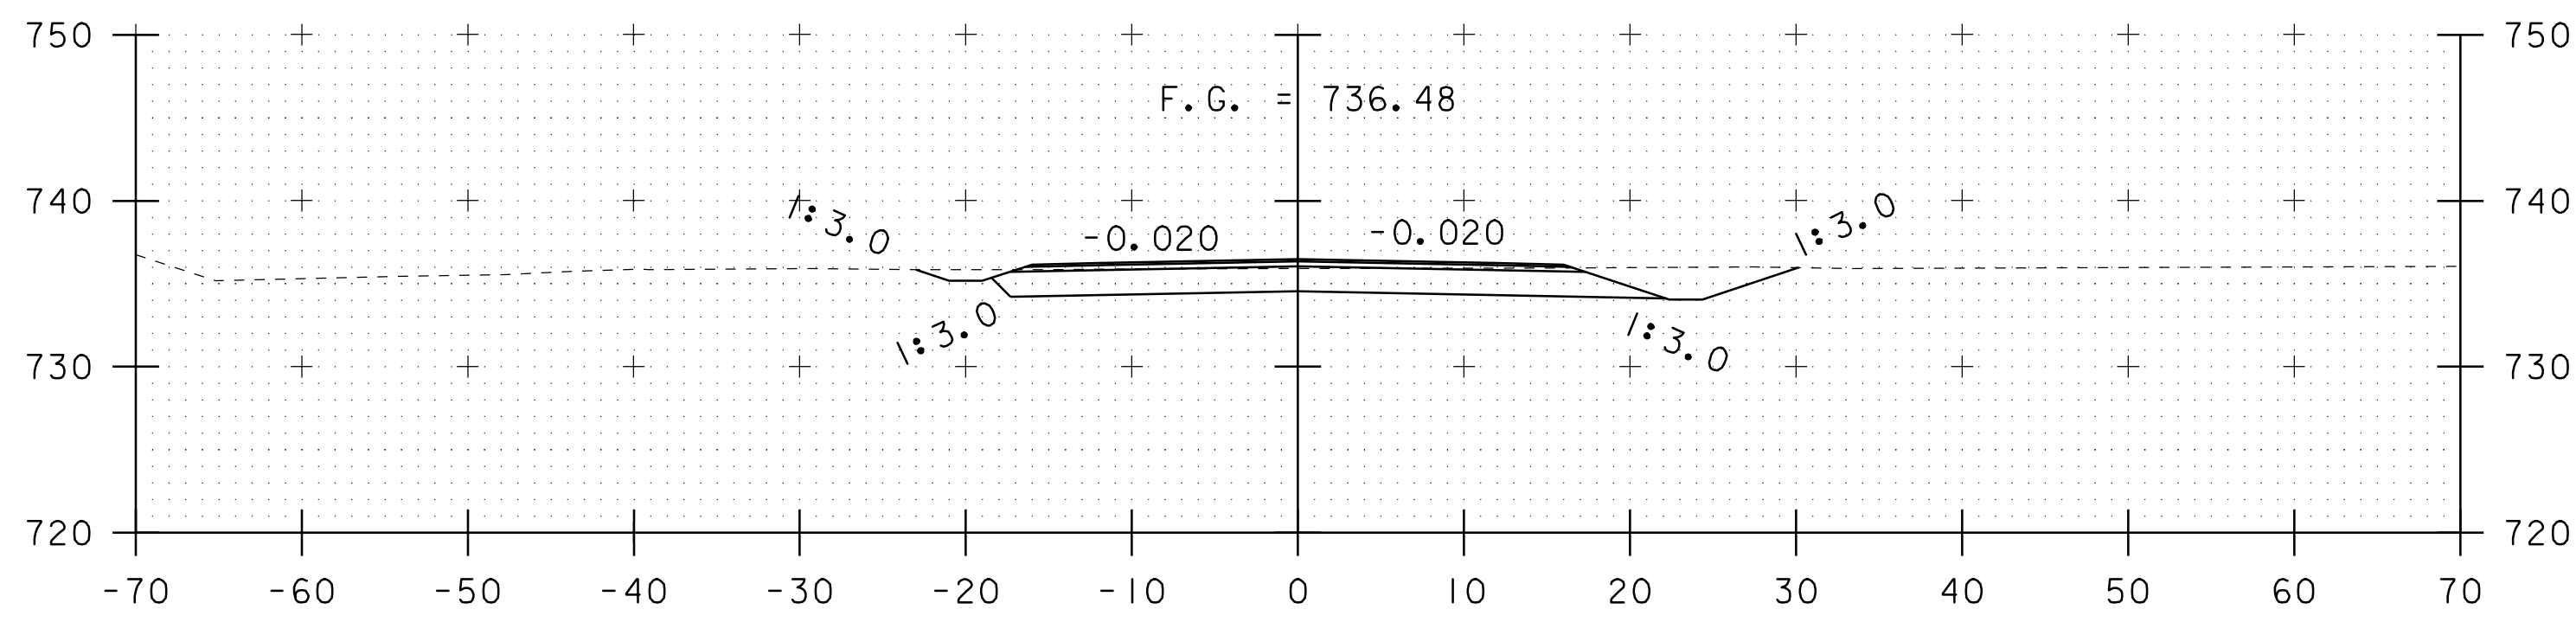

96+50

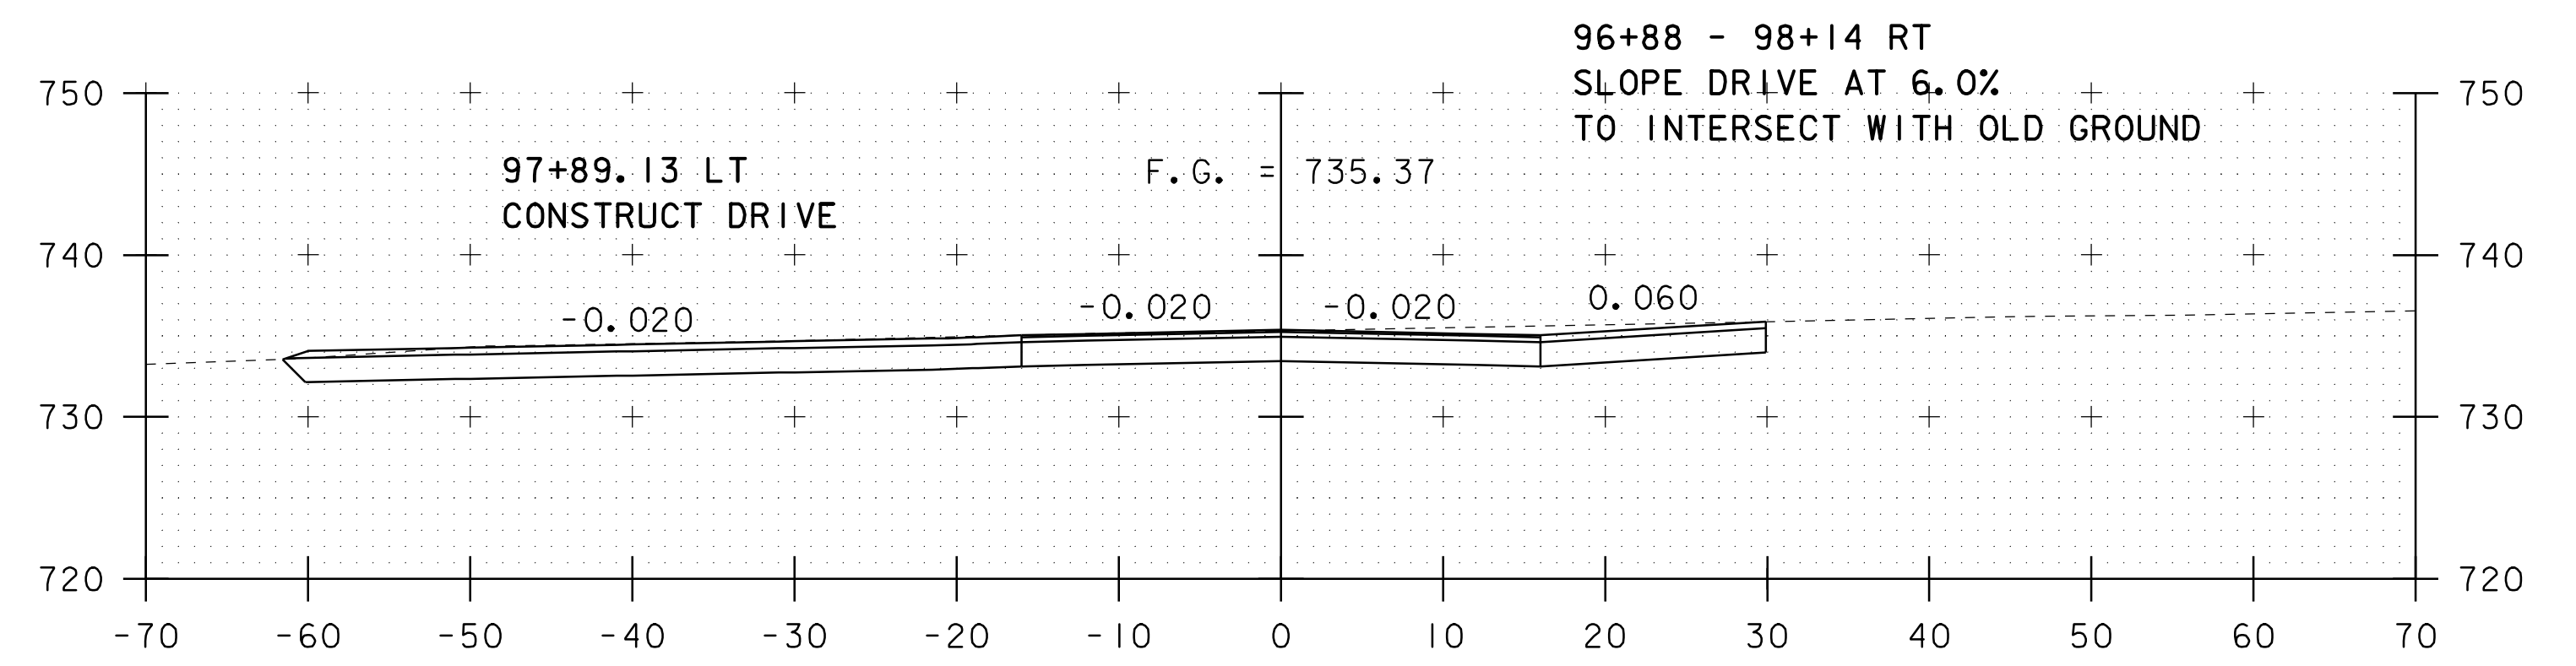

98+00

## FRONTAGE ROAD CROSS-SECTION SHEET #3

PROJECT NAME: BARRE TOWN  
PROJECT NUMBER: ST 0147(16)

FILE NAME: 05E290/Design/D05E290NUI  
PROJECT LEADER: R. THOMPSON  
DESIGNED BY: P. BEYOR  
D05E290XS3.I

PLOT DATE: 18-MAR-2008  
DRAWN BY: P. BEYOR  
CHECKED BY:  
SHEET 24 OF 26