



Drive - Ford
FR 92+40.00 LT

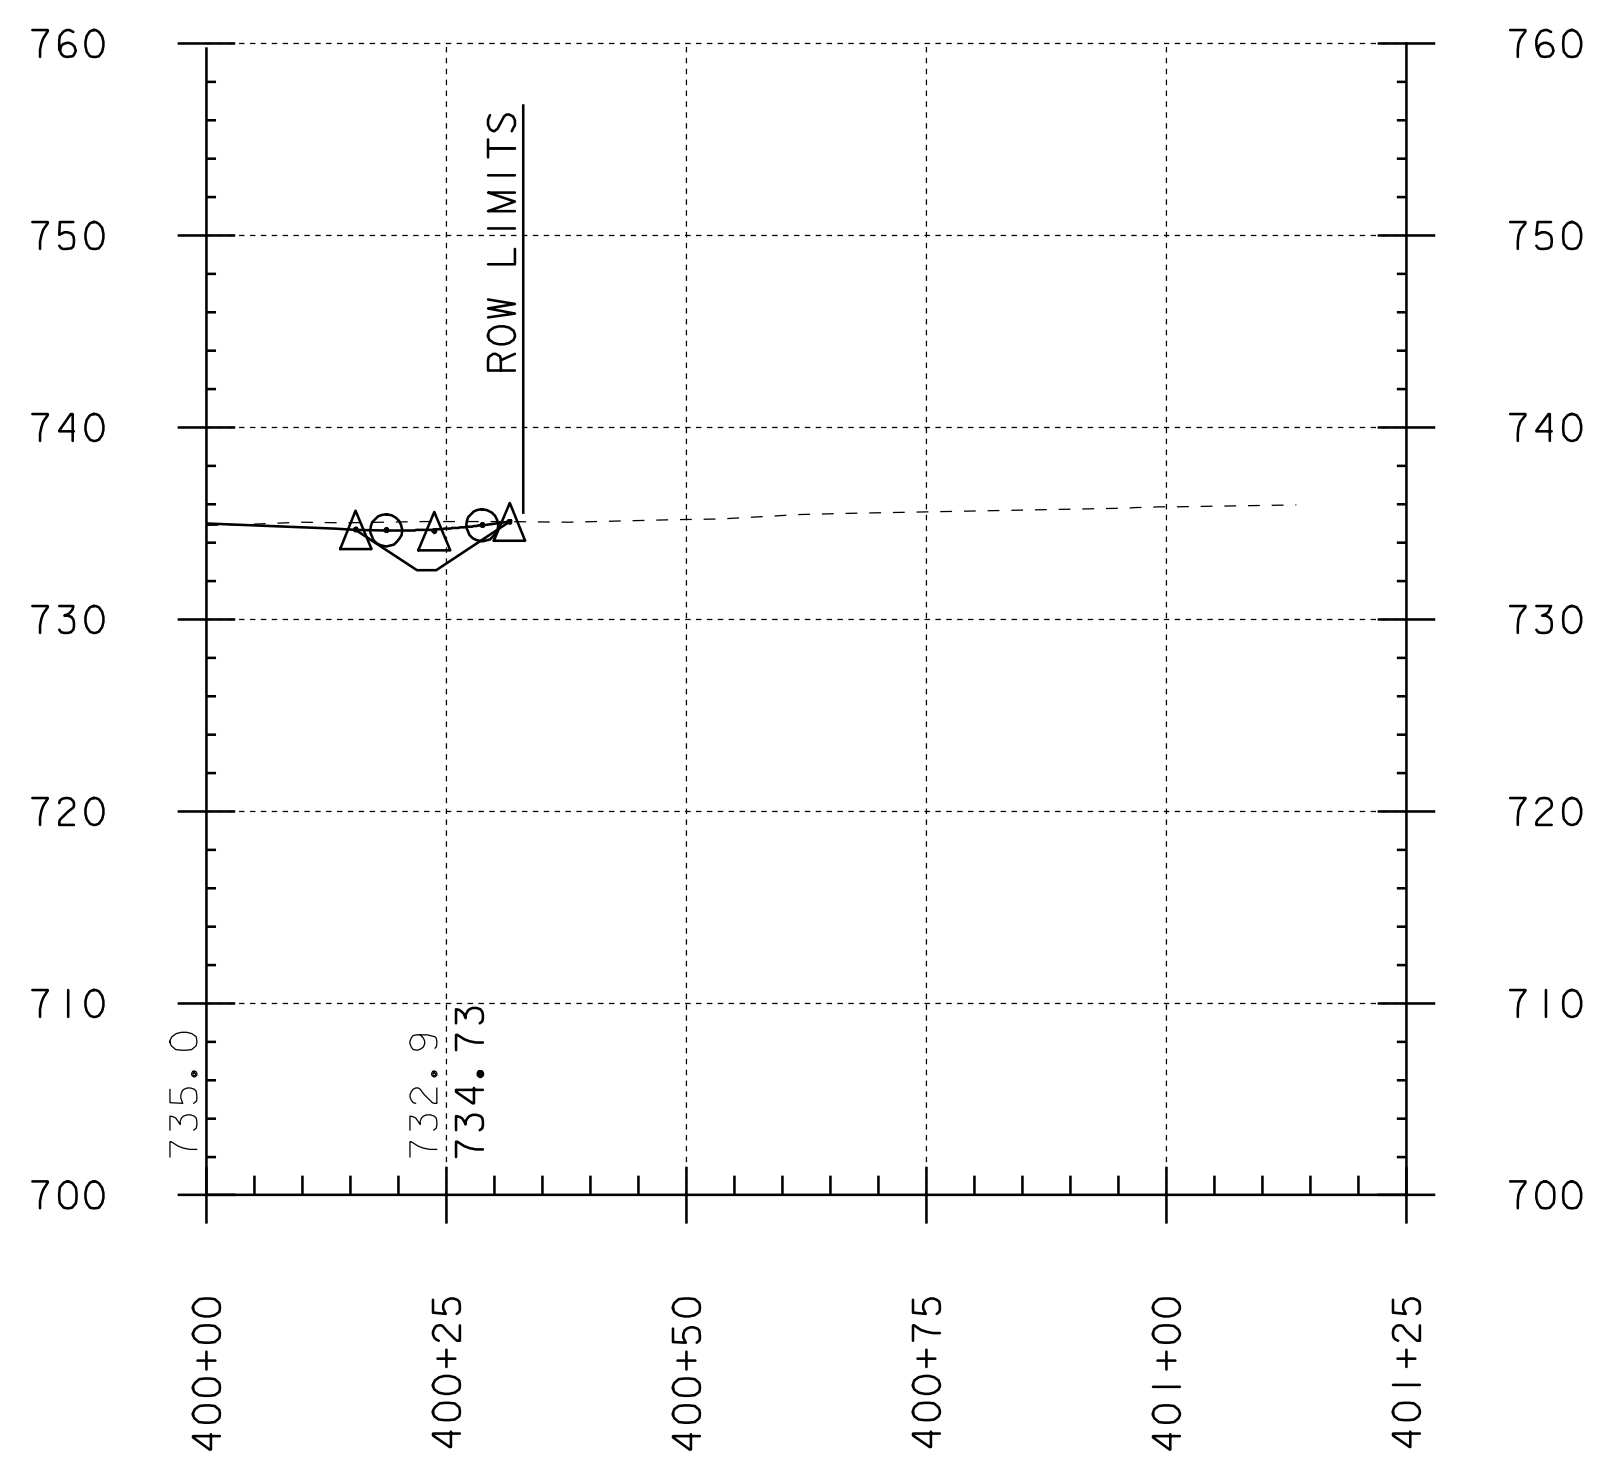

Drive - Bond
FR 94+39.32 RT

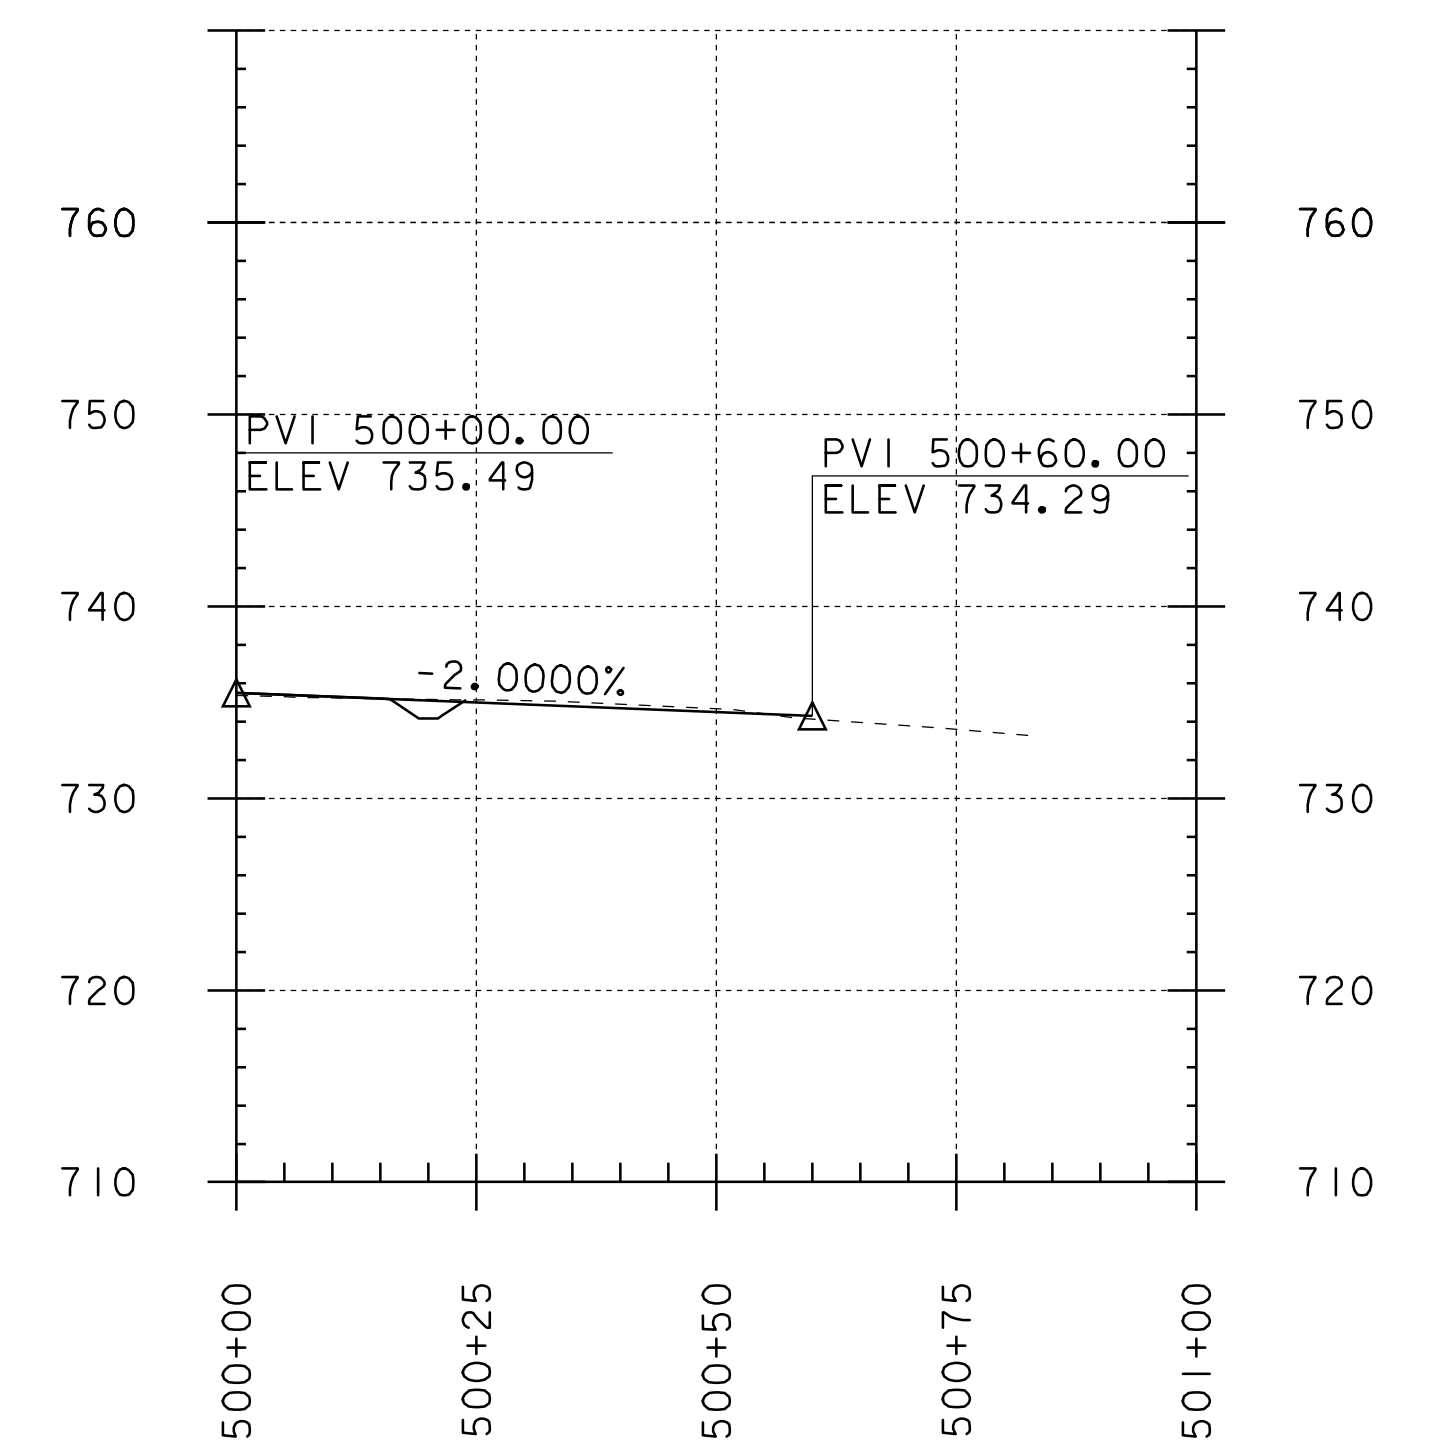

Drive - Turn
FR 97+89.13 LT

DRIVE CROSS-SECTION SHEET

PROJECT NAME:	BARRE TOWN	
PROJECT NUMBER:	ST 0147(16)	
FILE NAME:	D05E290/Design/D05E290NUI	PLOT DATE:
PROJECT LEADER:	R. THOMPSON	DRAWN BY:
DESIGNED BY:	P. BEYOR	CHECKED BY:
D05E290xs4.1		SHEET 25 OF 26