




93+78 RT - 93+78 LT
NEW 18" X 42' CPEP

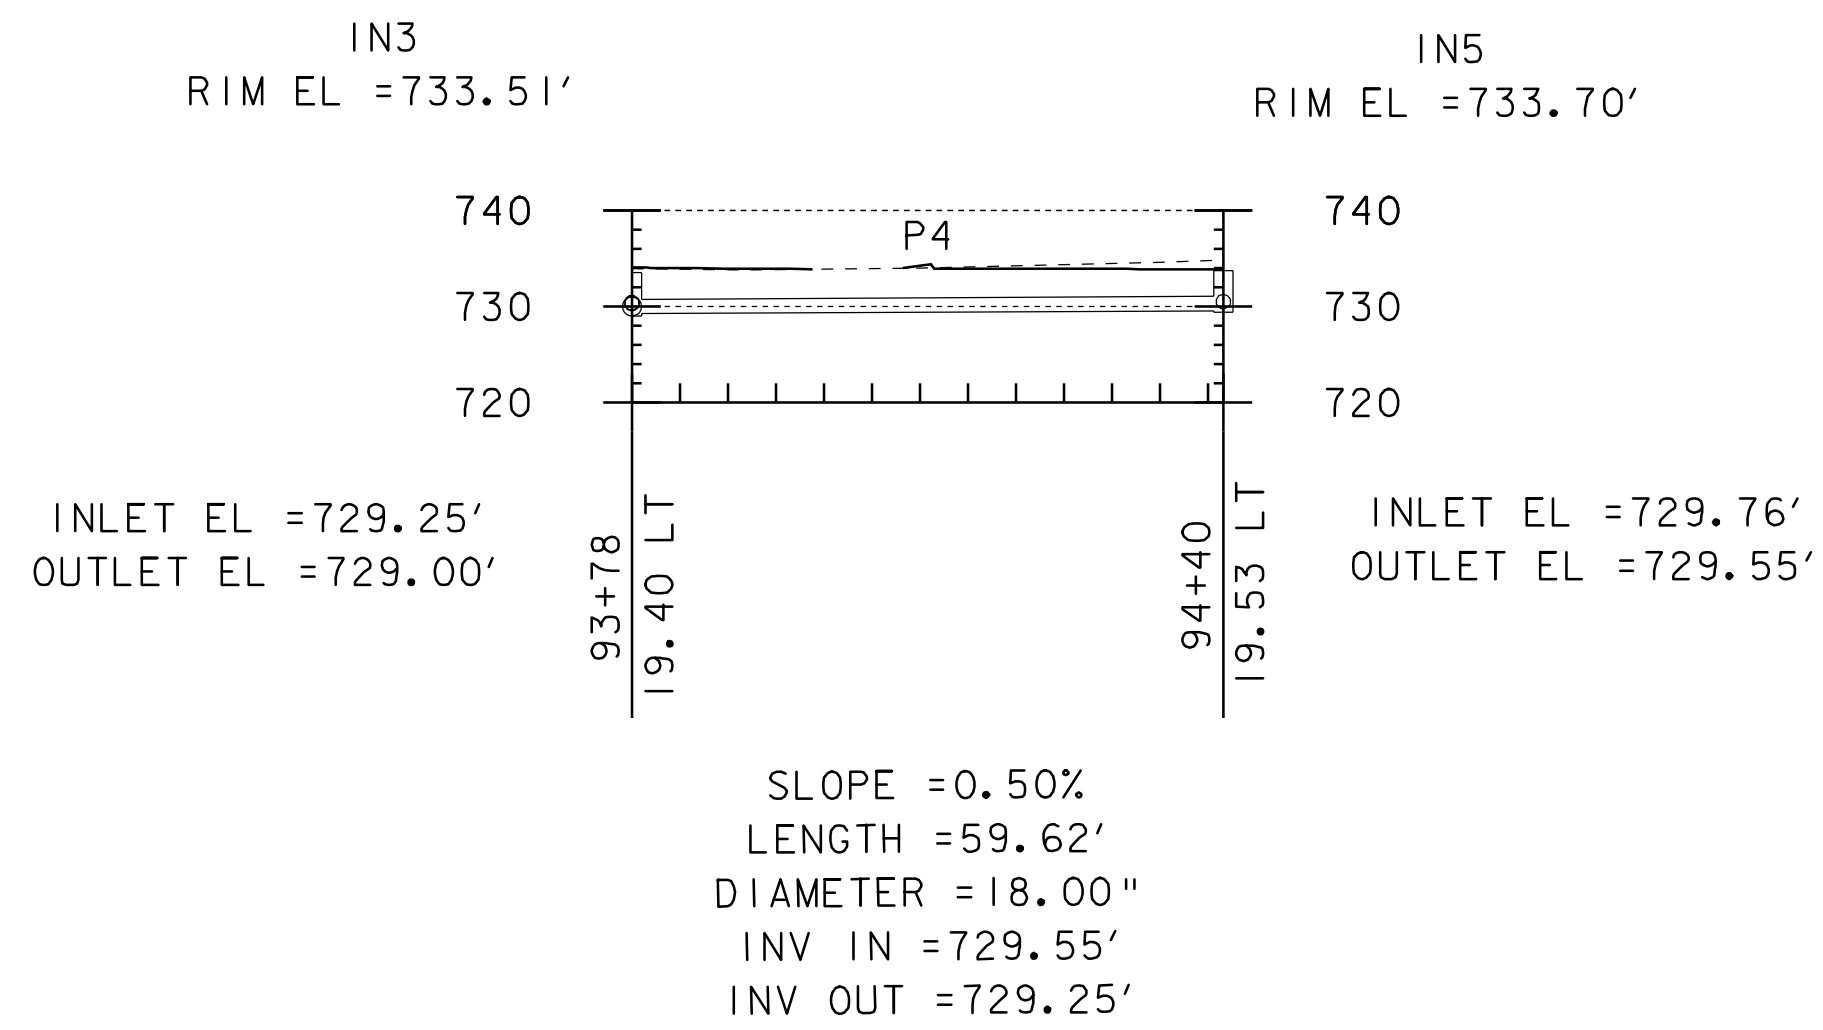


93+78 LT - 94+40 LT
NEW 18" X 60' CPEP

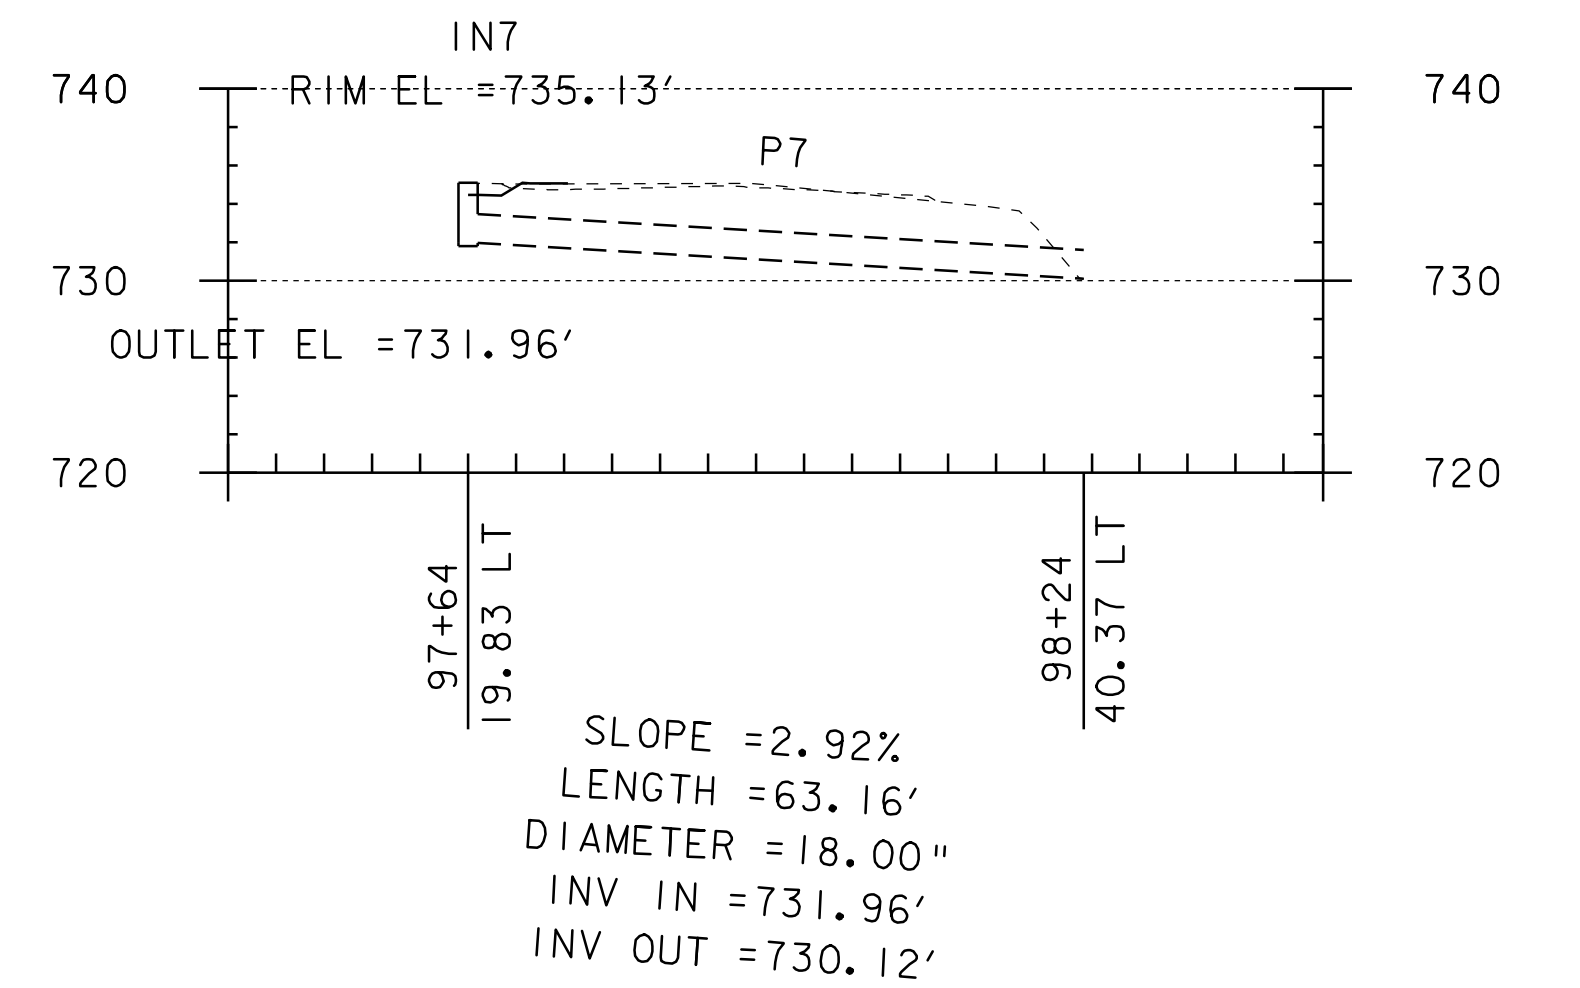


97+64 LT - 98+24 LT
NEW 18" X 64' CPEP

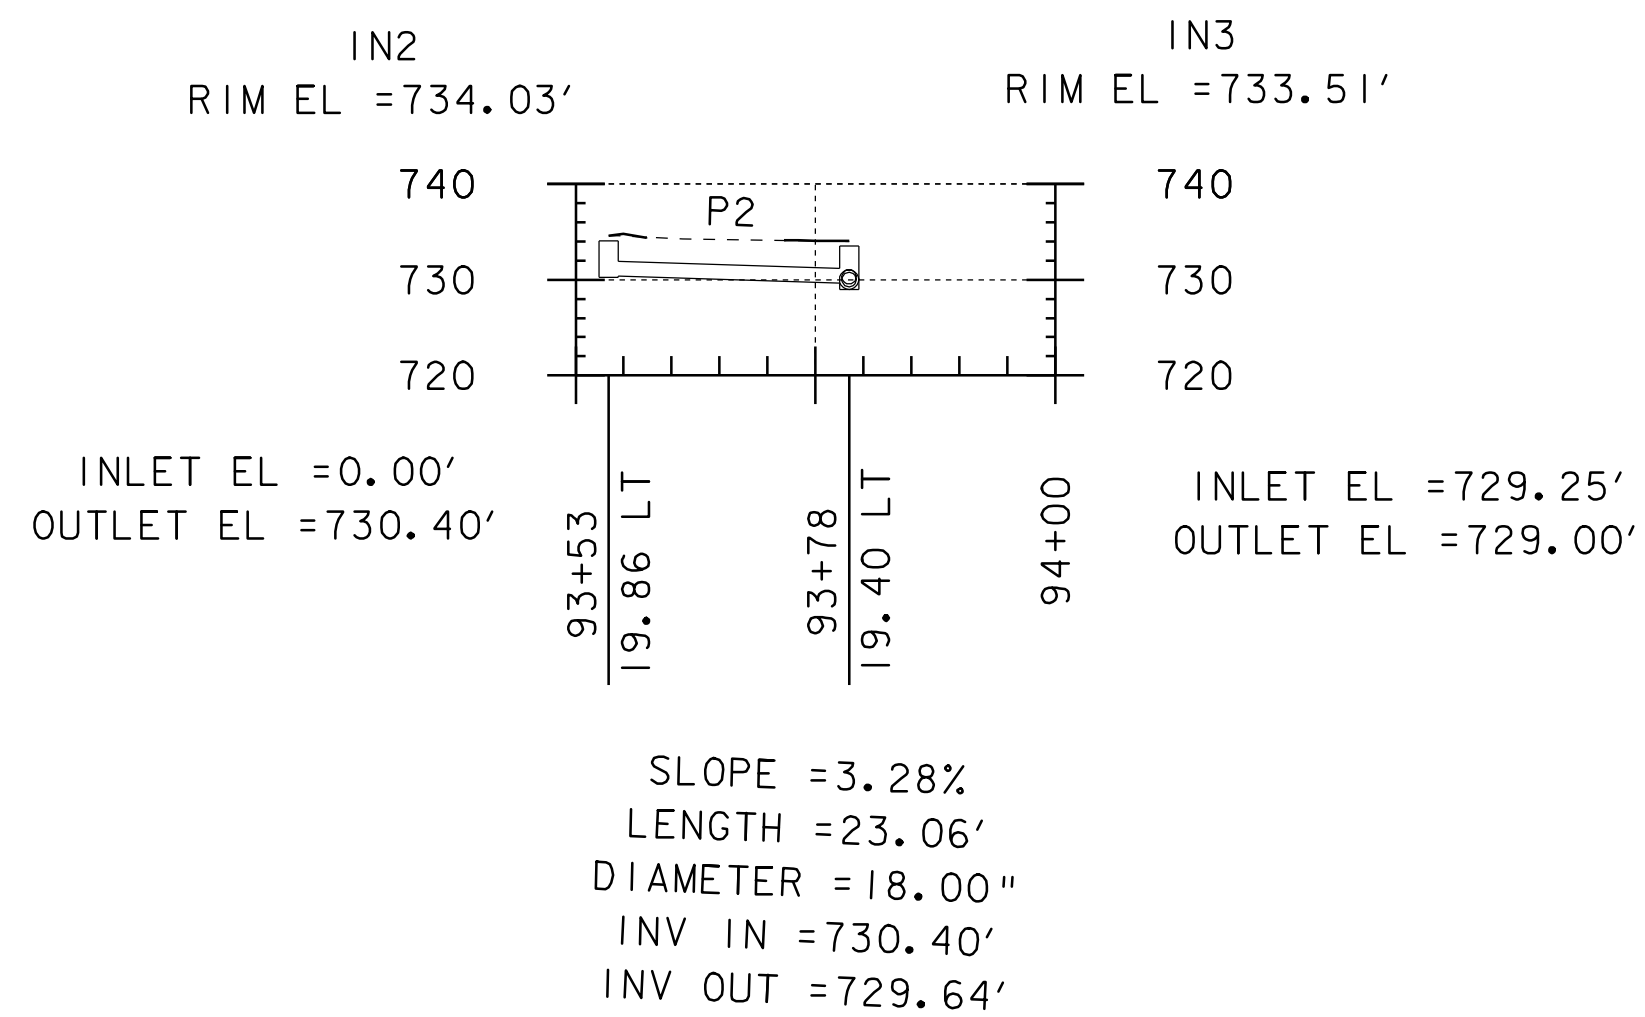

93+53 LT - 93+78 LT
NEW 18" X 24' CPEP

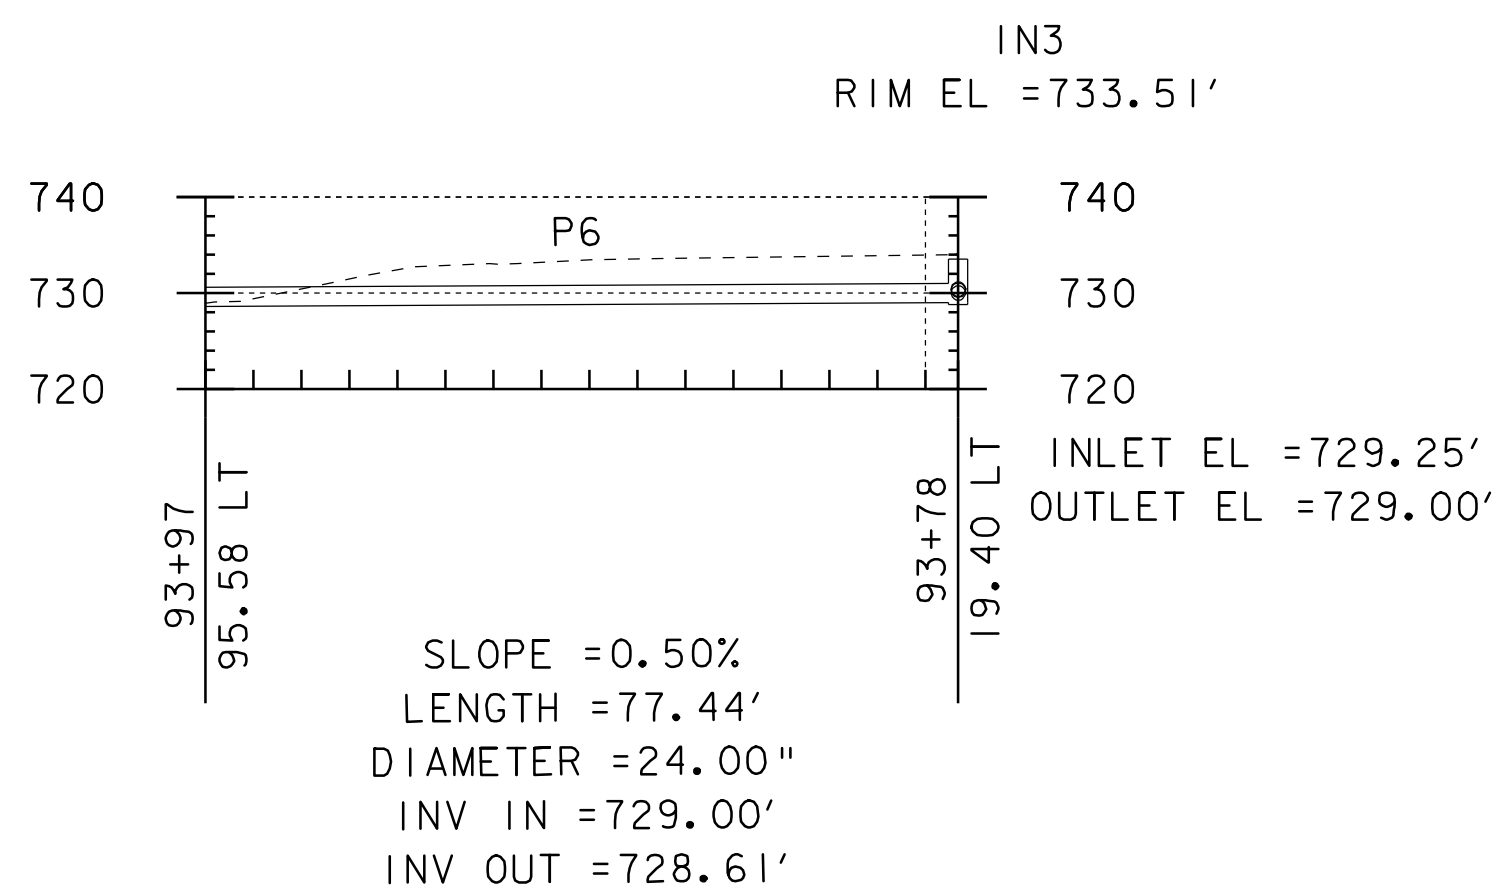

93+78 LT - 93+97 LT
NEW 24" X 78' CPEP

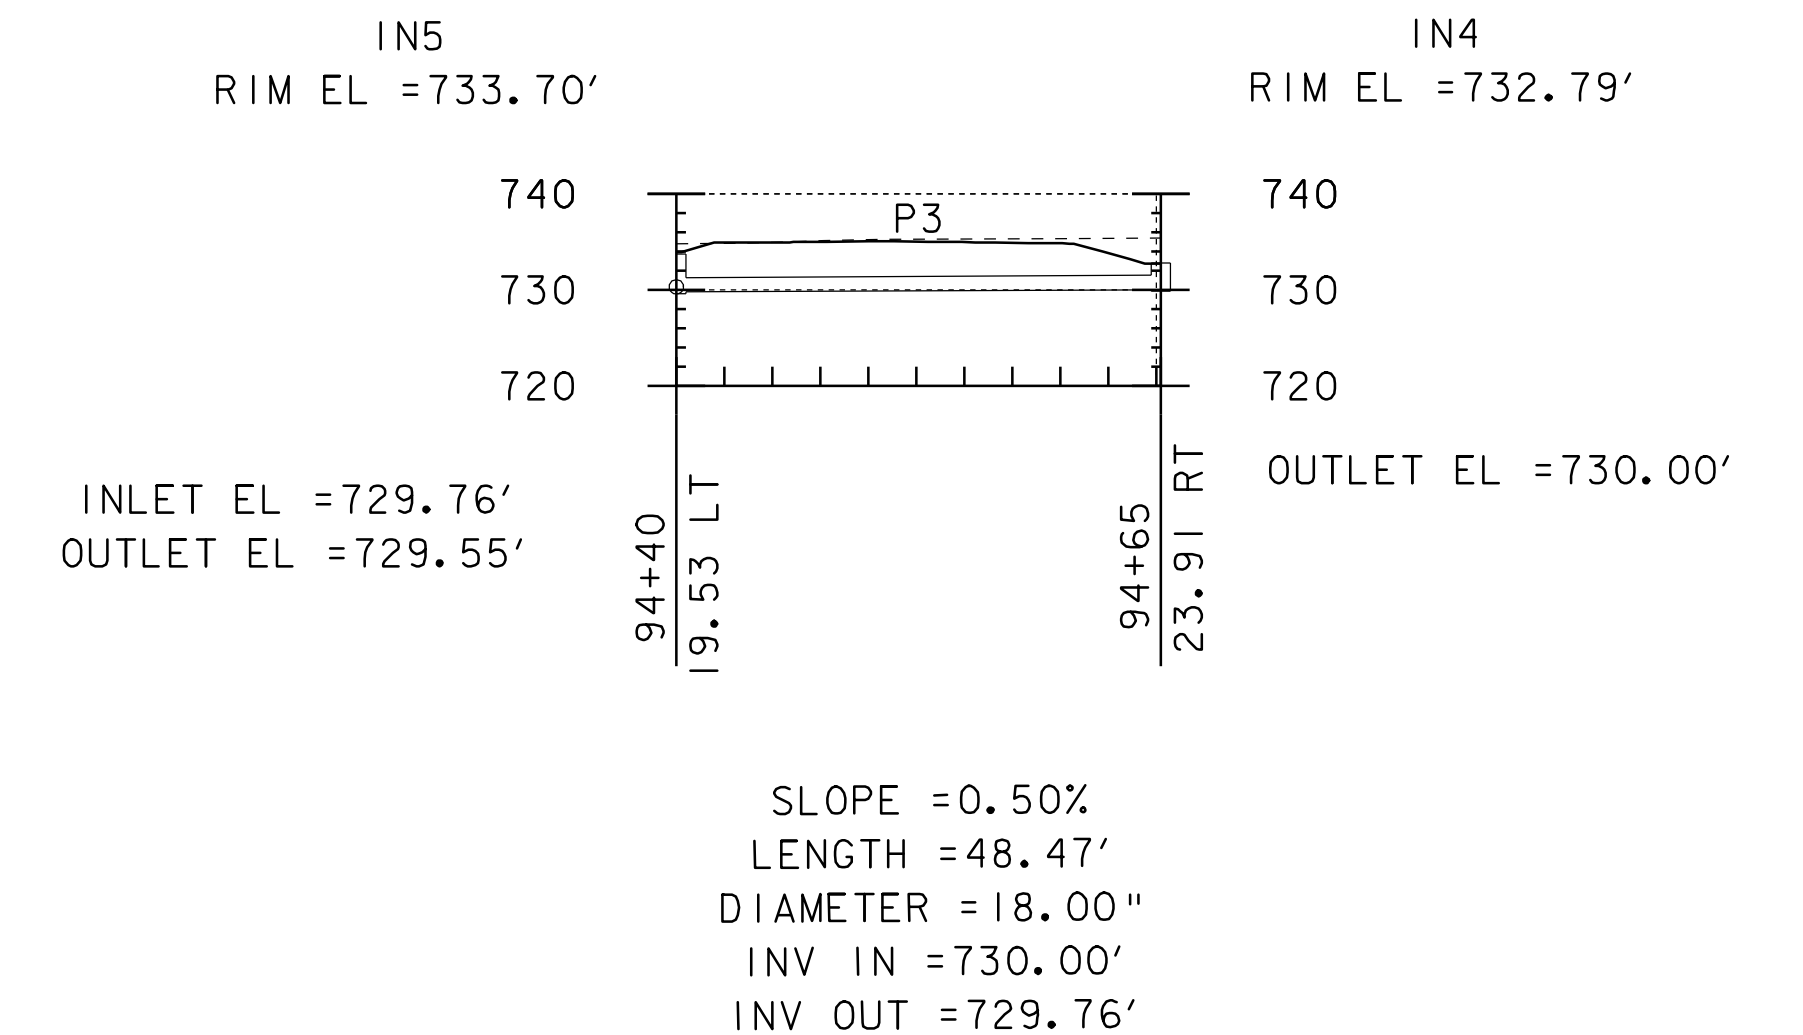

94+40 LT - 94+65 RT
NEW 18" X 48' CPEP

DRAINAGE PROFILE SHEET

PROJECT NAME: BARRE TOWN
PROJECT NUMBER: ST 0147(16)

FILE NAME: 05E290/Design/D05E290NUI
PROJECT LEADER: R. THOMPSON
DESIGNED BY: P. BEYOR
D05E290xs5.1

PLOT DATE: 18-MAR-2008
DRAWN BY: P. BEYOR
CHECKED BY:
SHEET 26 OF 26