
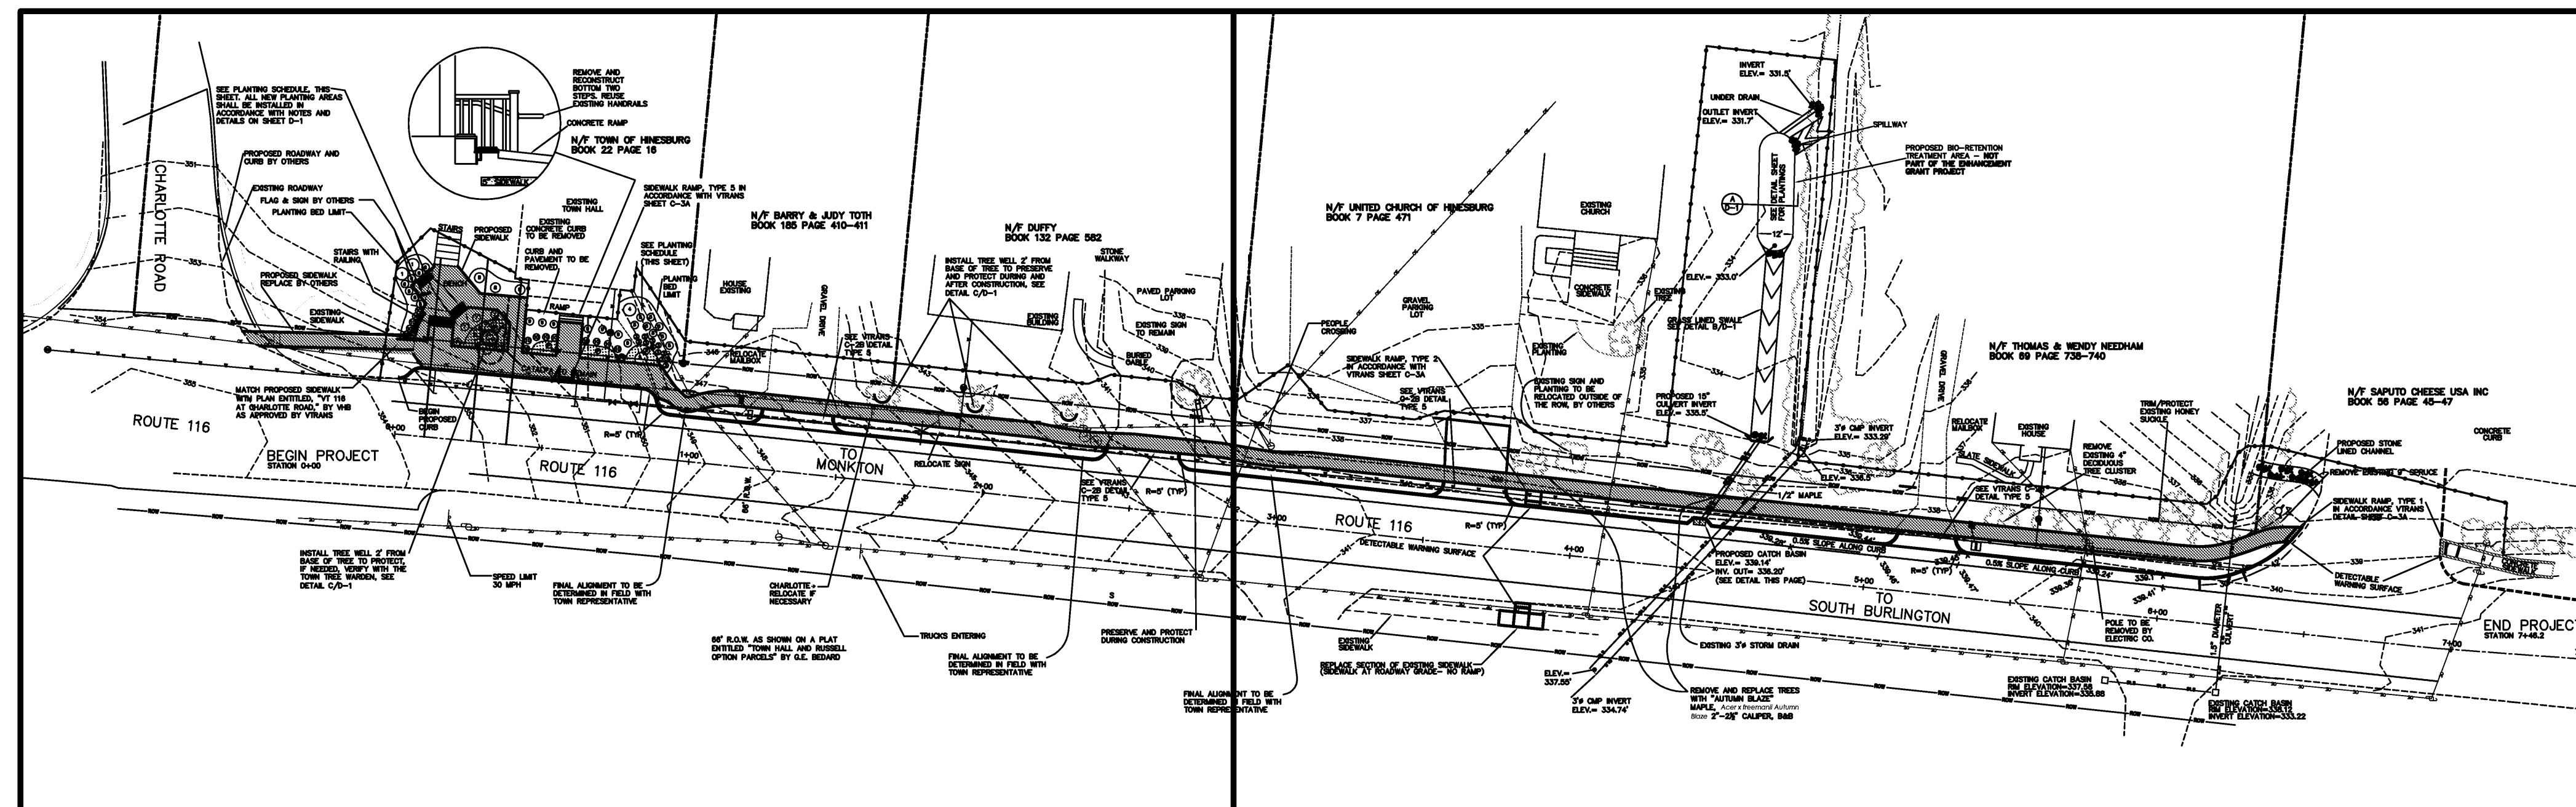


HINESBURG STP EH 05(22)

VILLAGE STREETScape IMPROVEMENTS ROUTE 116, HINESBURG, VERMONT DECEMBER, 2006

BEGINNING AT THE NORTH END OF THE INTERSECTION OF CHARLOTTE ROAD AND ROUTE 116 AND PROGRESSING 746 FEET NORTH ALONG ROUTE 116. WORK TO BE PERFORMED UNDER THIS CONTRACT INCLUDES GRANITE CURB, CONCRETE SIDEWALK, DRAINAGE, LANDSCAPING, A STORMWATER TREATMENT SYSTEM AND RELATED WORK.

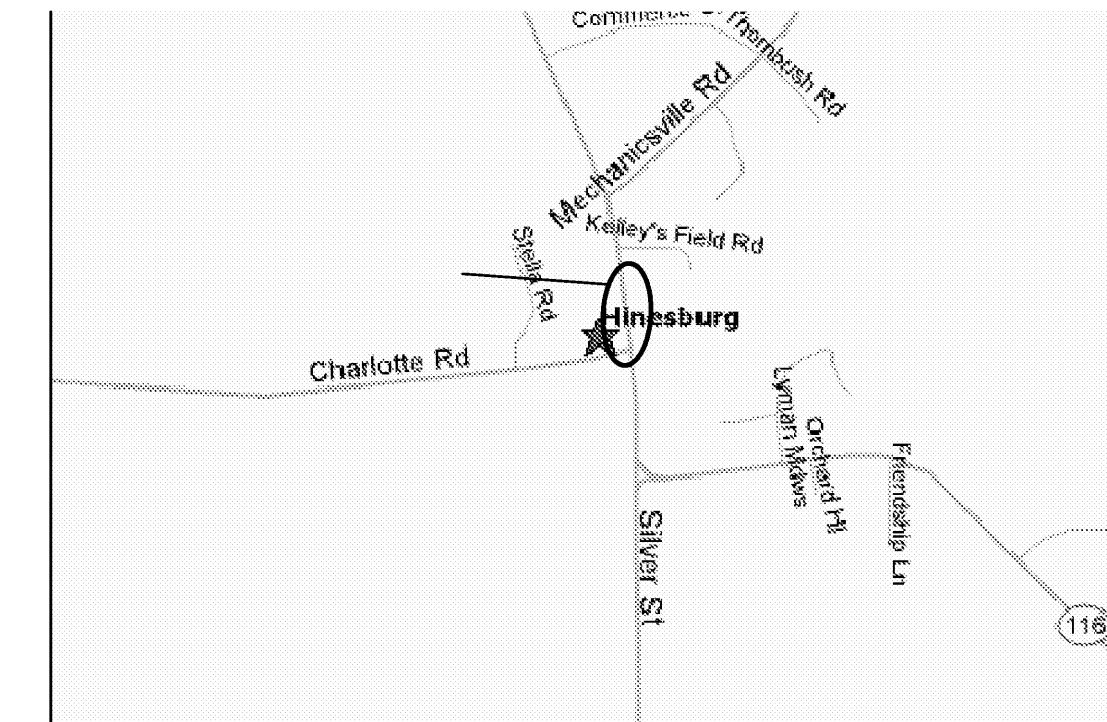

SHEET INDEX

- SHEET "P-1", SITE PLAN
- SHEET "P-2", SITE PLAN
- SHEET "D-1", DETAILS
- SHEET "C-1", CROSS SECTIONS
- SHEET "C-2", CROSS SECTIONS
- SHEET "C-3", CROSS SECTIONS
- SHEET "EP-1", EROSION AND SEDIMENT CONTROL
- SHEET "ROW-1", COVER
- SHEET "ROW-2", RIGHT-OF-WAY PLAN
- SHEET "ROW-3", RIGHT-OF-WAY PLAN
- SHEET "ROW-4", RIGHT-OF-WAY PLAN
- SHEET "TSL-1", TEMPORARY CONSTRUCTION SIGNAGE
- VTRANS STANDARD DETAIL "B-71", 7/8/05
RESIDENTIAL AND COMMERCIAL DRIVES
- VTRANS STANDARD DETAIL "C-1", 1/3/00
CURBS, BITUMINOUS CONCRETE SIDEWALKS,
GRANITE SLOPE EDGING, VERTICAL GRANITE CURB,
PRECAST REINFORCED CONCRETE CURB
CAST IN PLACE CONCRETE CURB
BITUMINOUS CONCRETE CURB, TREATED TIMBER CURB
- VTRANS STANDARD DETAIL "C-2A", 10/14/05
PORTLAND CEMENT CONCRETE SIDEWALK DRIVE,
ENTRANCES WITH SIDEWALK ADJACENT TO CURB
- VTRANS STANDARD DETAIL "C-2B", 10/14/05
PORTLAND CEMENT CONCRETE SIDEWALK DRIVE
ENTRANCES WITH SIDEWALK AND GREEN STRIP
- VTRANS STANDARD DETAIL "C-3A", 9/1/04
SIDEWALK RAMPS
- VTRANS STANDARD DETAIL "C-3B", 9/1/04
SIDEWALK RAMPS AND MEDIAN ISLANDS
- VTRANS STANDARD DETAIL "D-6", 6/1/1994
REINFORCED CONCRETE DROP INLET WITH GRATE
- VTRANS STANDARD DETAIL "D-8", 1/3/2000
REINFORCED CONCRETE DROP INLET WITH PRECAST
COVER AND BOTTOM GRATE SECTION
- VTRANS STANDARD DETAIL "D-9", 6/1/94
REINFORCED CONCRETE DROP INLET TOPS
VERTICAL CURB AND THROAT ADAPTER
- VTRANS STANDARD DETAIL "D-15", 6/1/94
PRECAST REINFORCED CONC. MH-GRATES (BICYCLE SAFE)
- VTRANS STANDARD DETAIL "E-100", 1/2/04
CONSTRUCTION APPROACH SIGNS
- VTRANS STANDARD DETAIL "E-101", 5/30/03
CONSTRUCTION SIGN DETAIL
- VTRANS STANDARD DETAIL "E-102", 6/30/03
CONSTRUCTION SIGN DETAIL
- VTRANS STANDARD DETAIL "E-160", 5/20/99
FLANGED CHANNEL STEEL SIGN POST
- VTRANS STANDARD DETAIL "E-162", 5/20/99
TUBULAR ALUMINUM SIGN POST
- VTRANS STANDARD DETAIL "E-170", 11/4/99
TRAFFIC CONTROL SIGNALS PEDESTAL POST MOUNTED



ENGINEERING AND ENVIRONMENTAL SERVICES
P.O. BOX 212, WILLISTON, VT, 05495
WWW.ESPC-CONSULTING.COM

RECORD DRAWINGS

DISCLAIMER: THESE RECORD DRAWINGS WERE PREPARED FROM DATA PROVIDED BY THE CONTRACTOR AND/OR OWNERS REPRESENTATIVE AND FROM SITE INSPECTIONS CONDUCTED BY ESPC FOLLOWING CONSTRUCTION. THE ENGINEER ASSUMES NO RESPONSIBILITY REGARDING THE ACCURACY OF THE INFORMATION PROVIDED ON THE PLANS OR THE LOCATIONS OF NEW CONSTRUCTION FEATURES DEPICTED ON THE PLANS.

FUNDING ASSISTANCE FOR THIS PROJECT IS BEING FURNISHED BY VTRANS

TOWN OF HINESBURG	VERTICAL DATUM
APPROVED: _____ DATE _____	NAVD 1988
	HORIZONTAL NAD 1983