
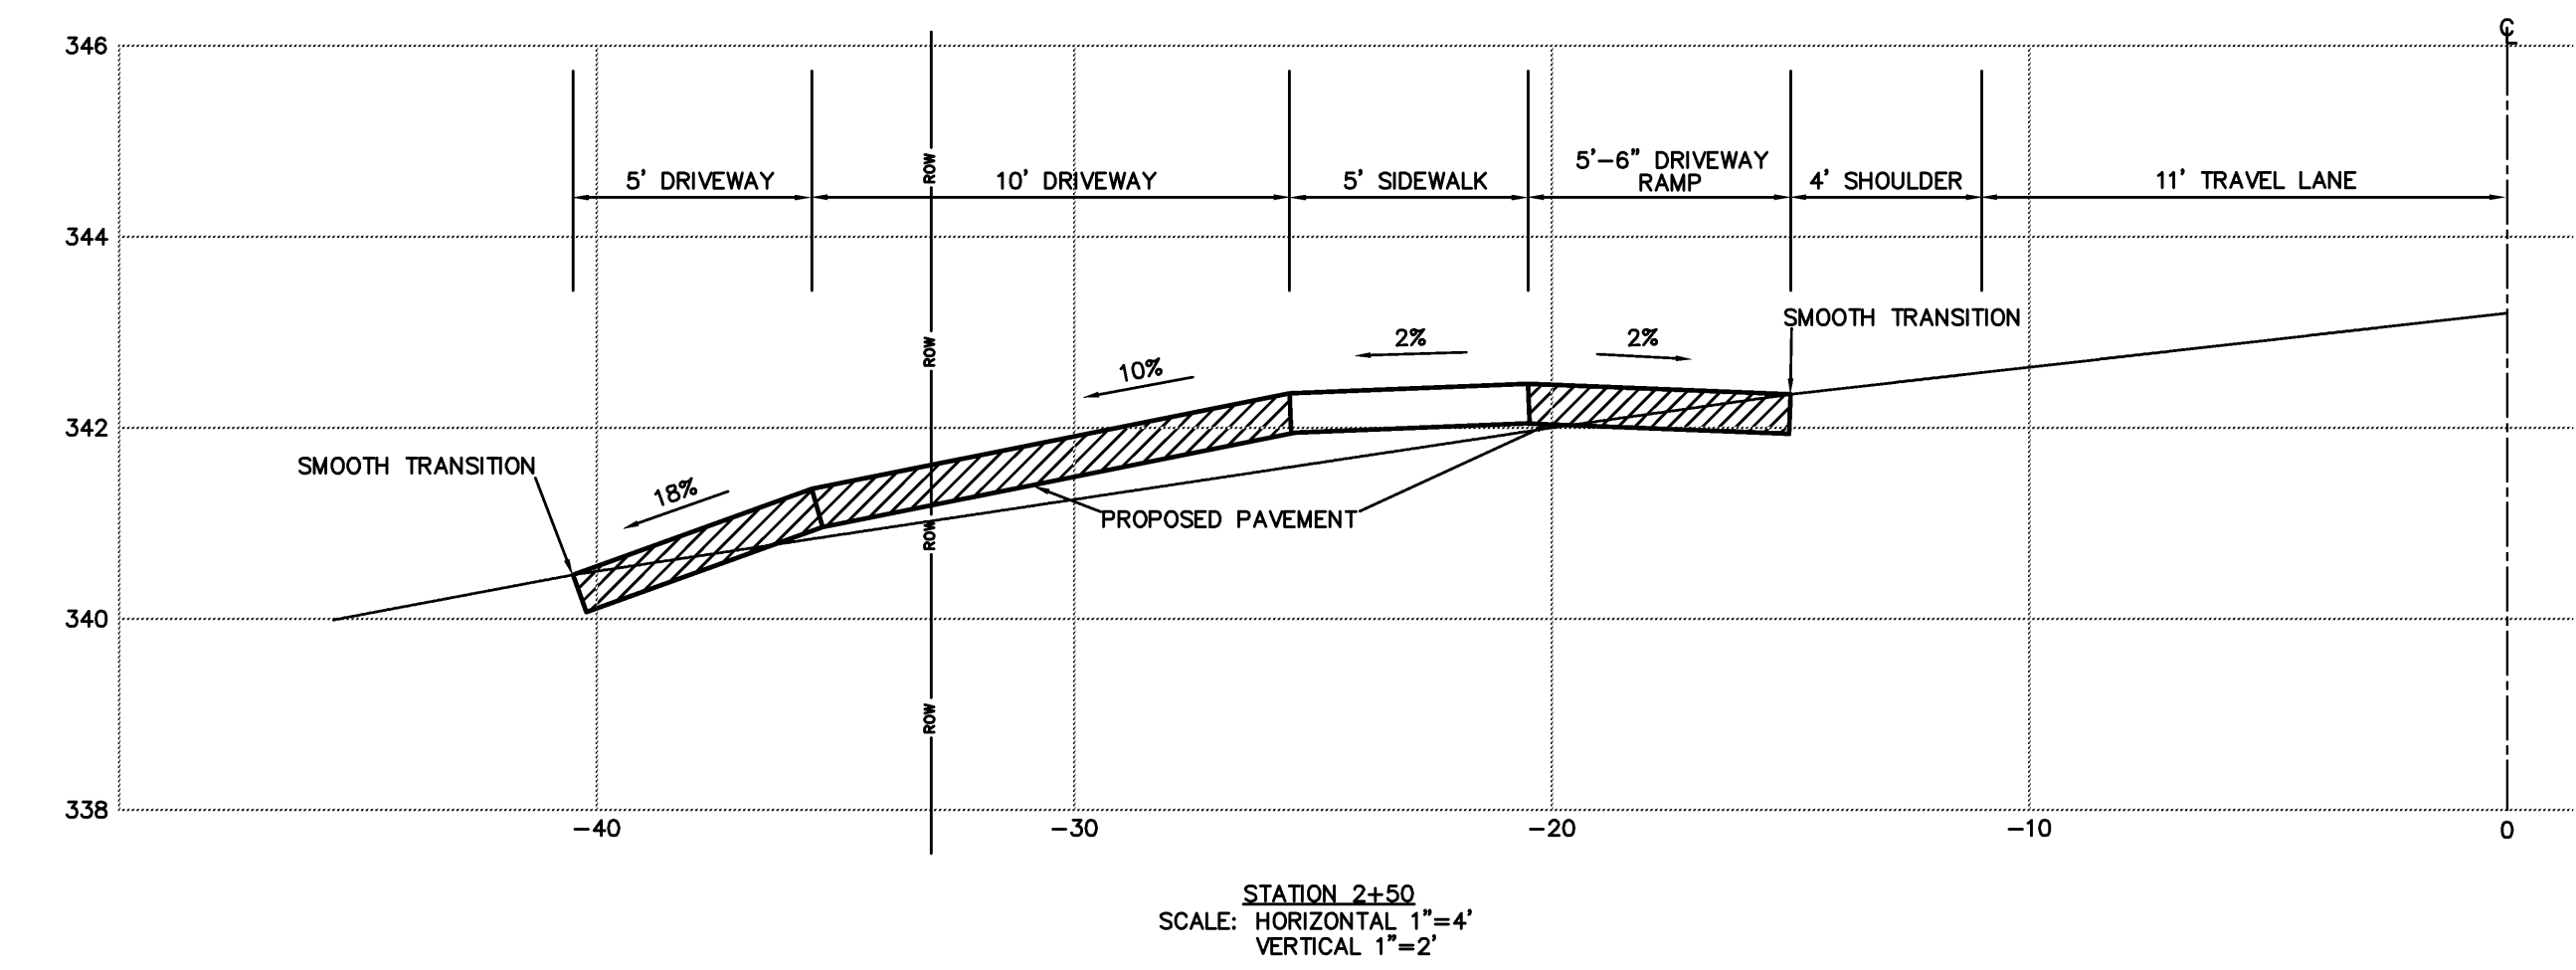
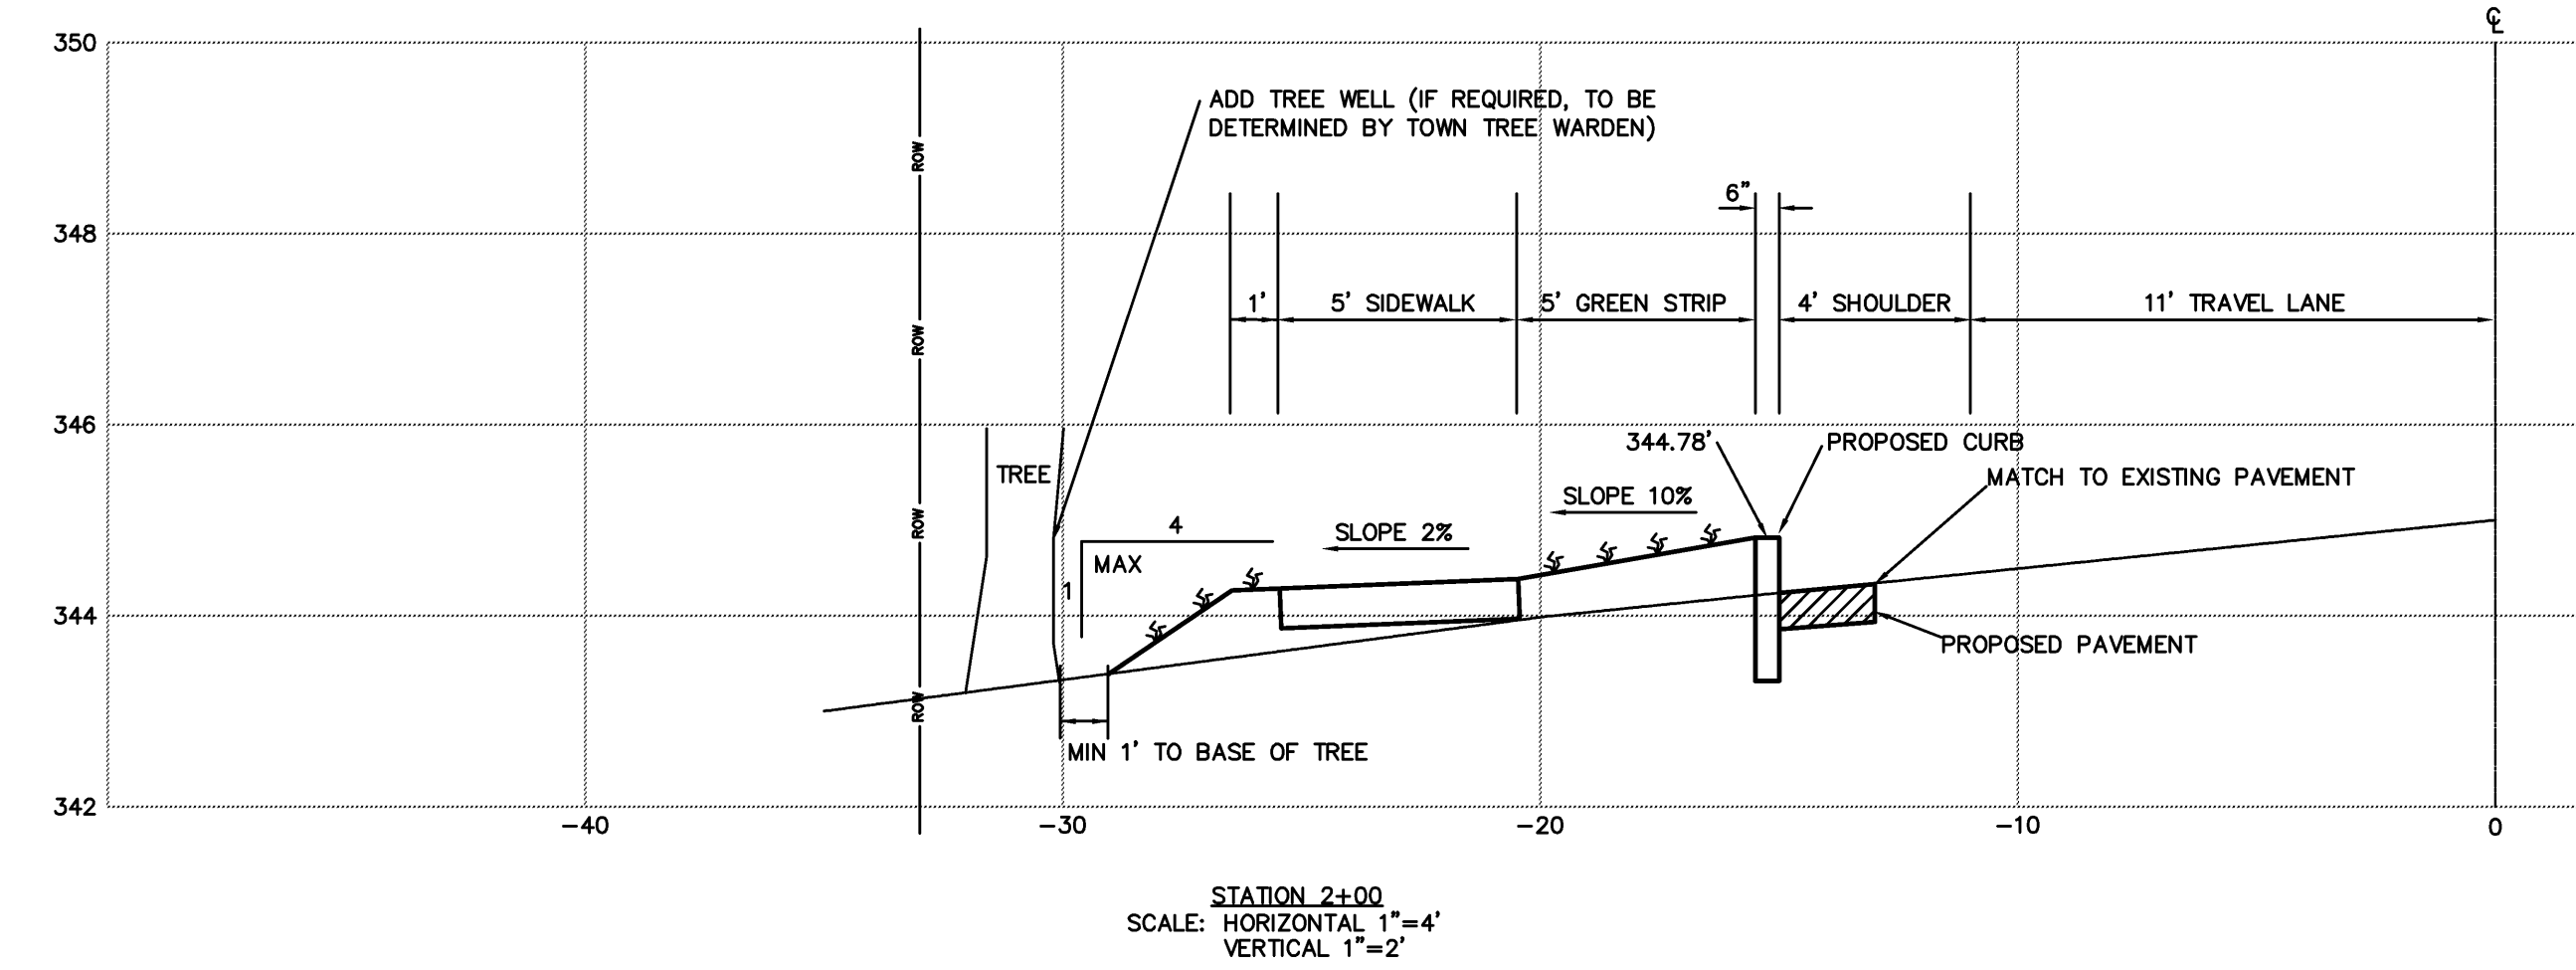
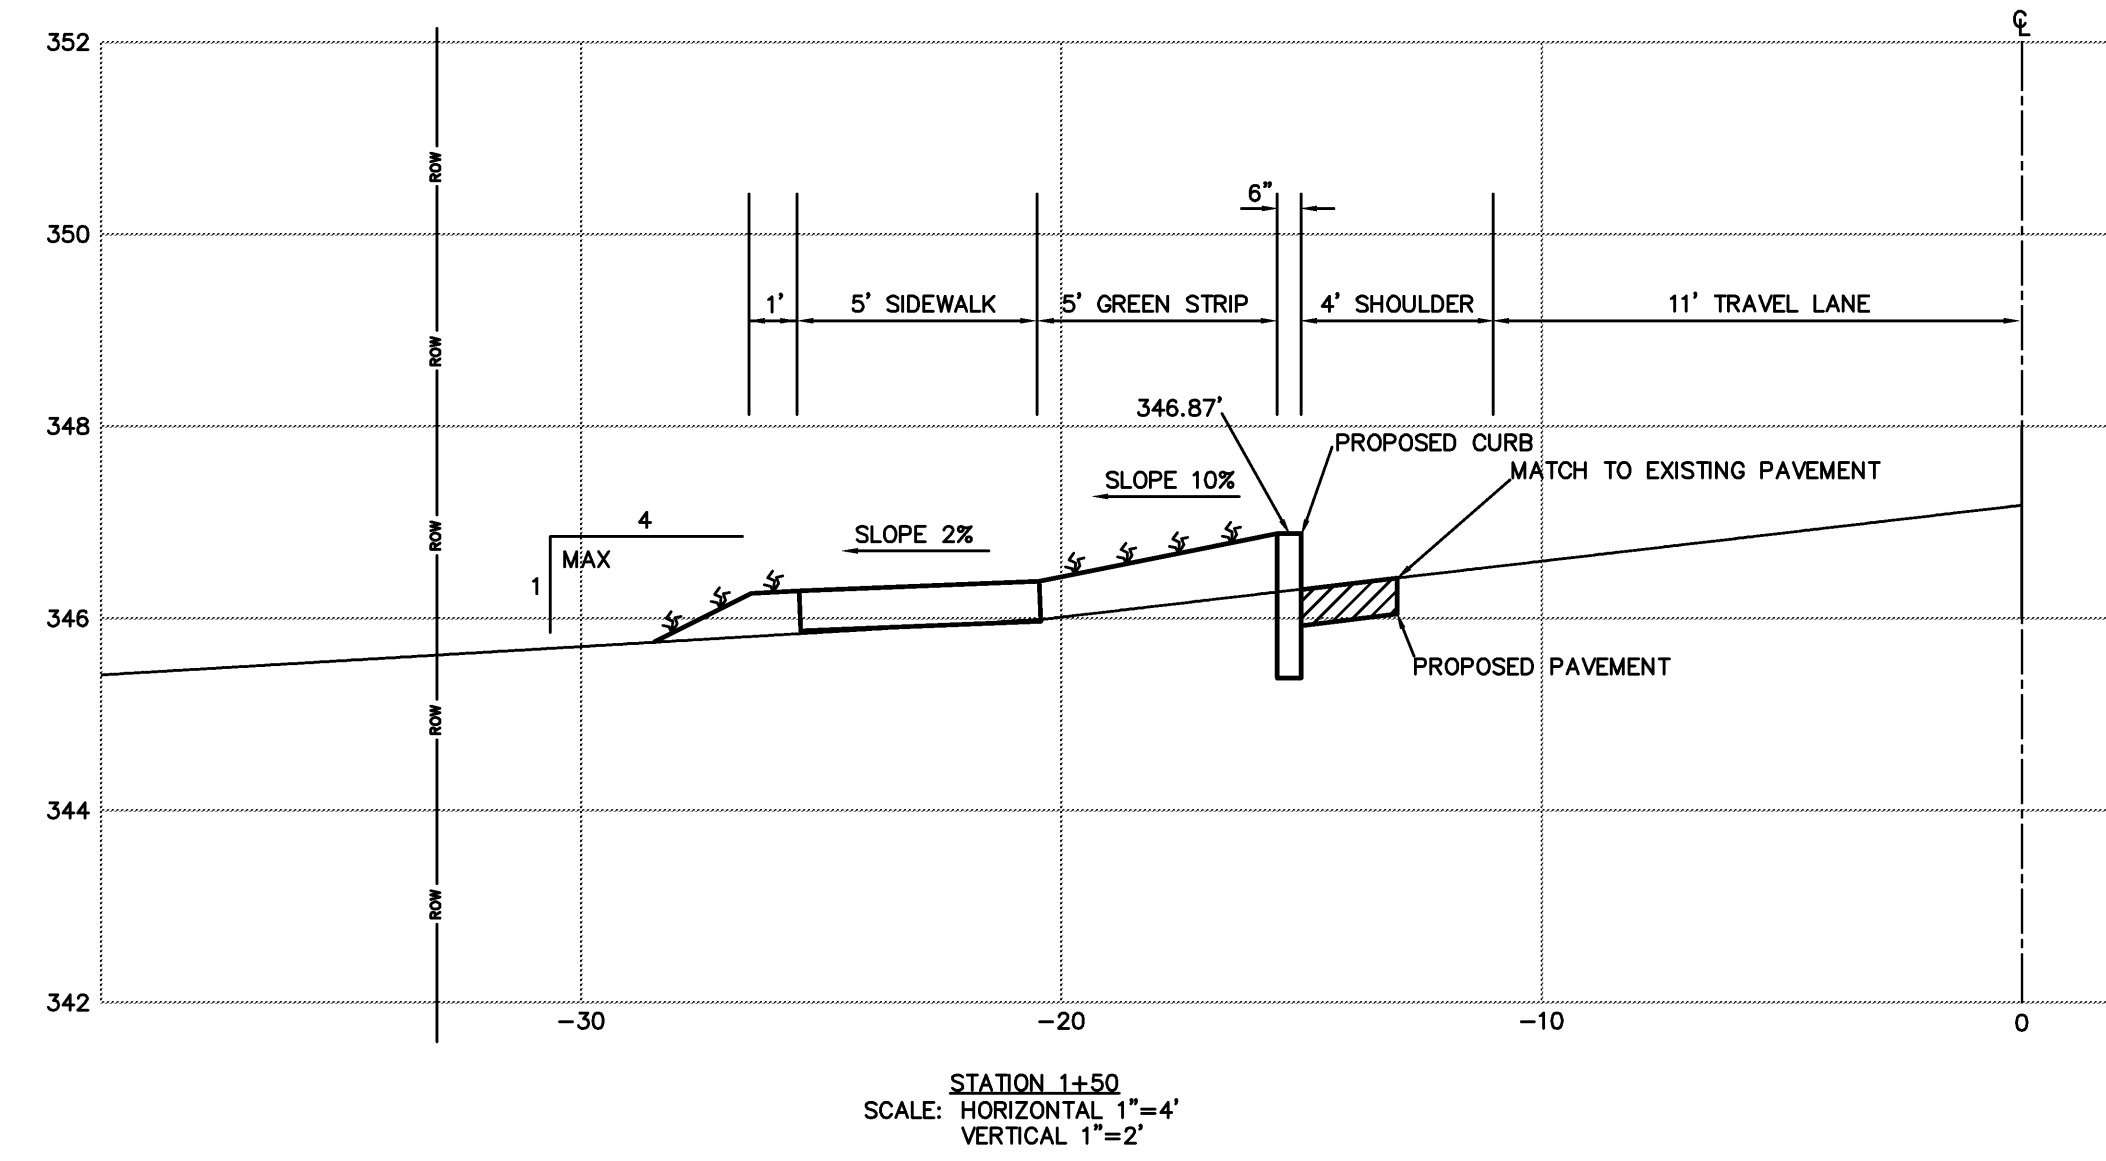
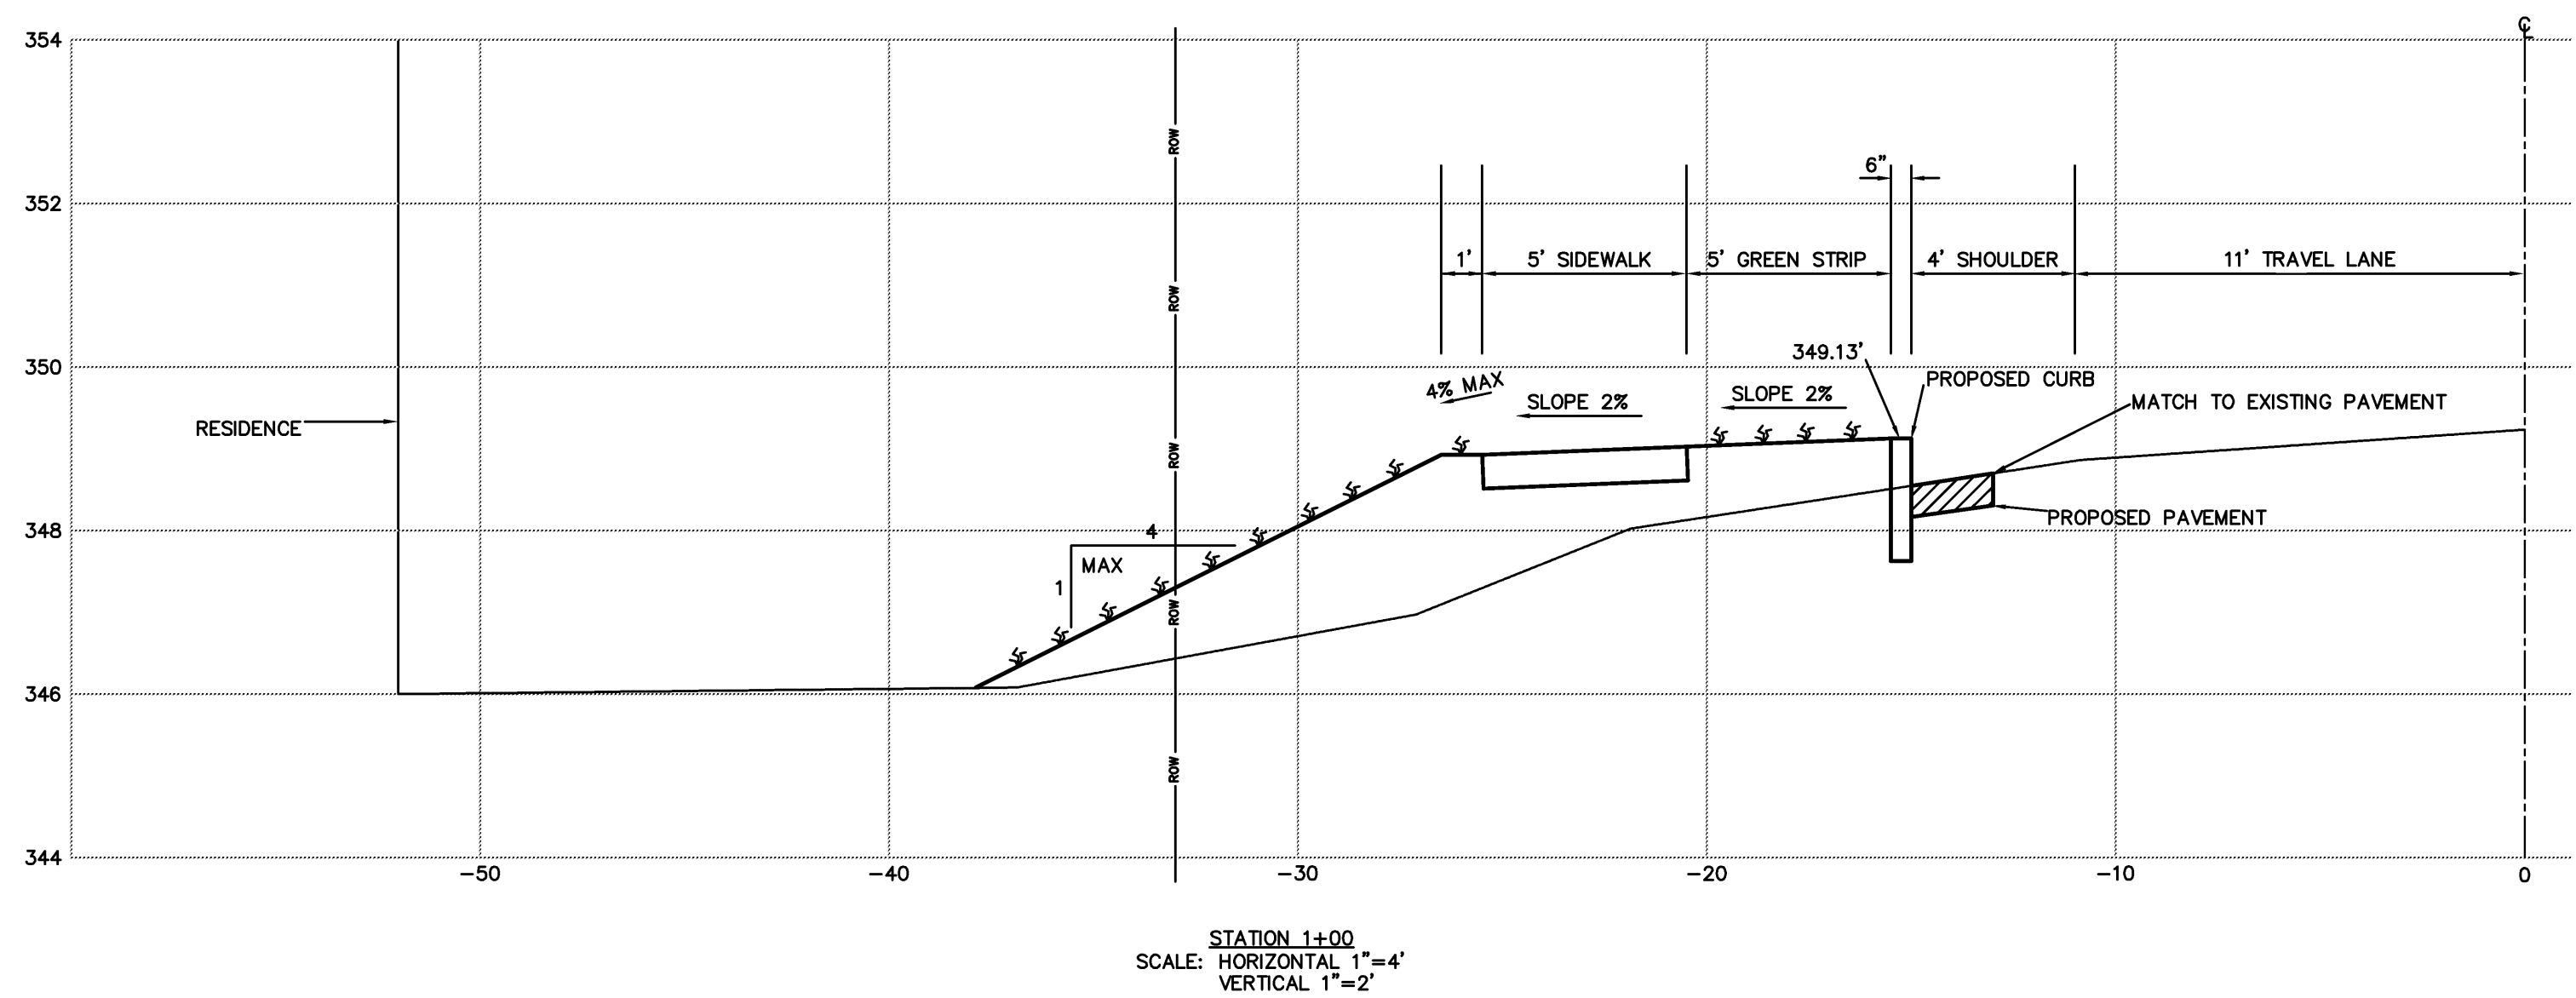
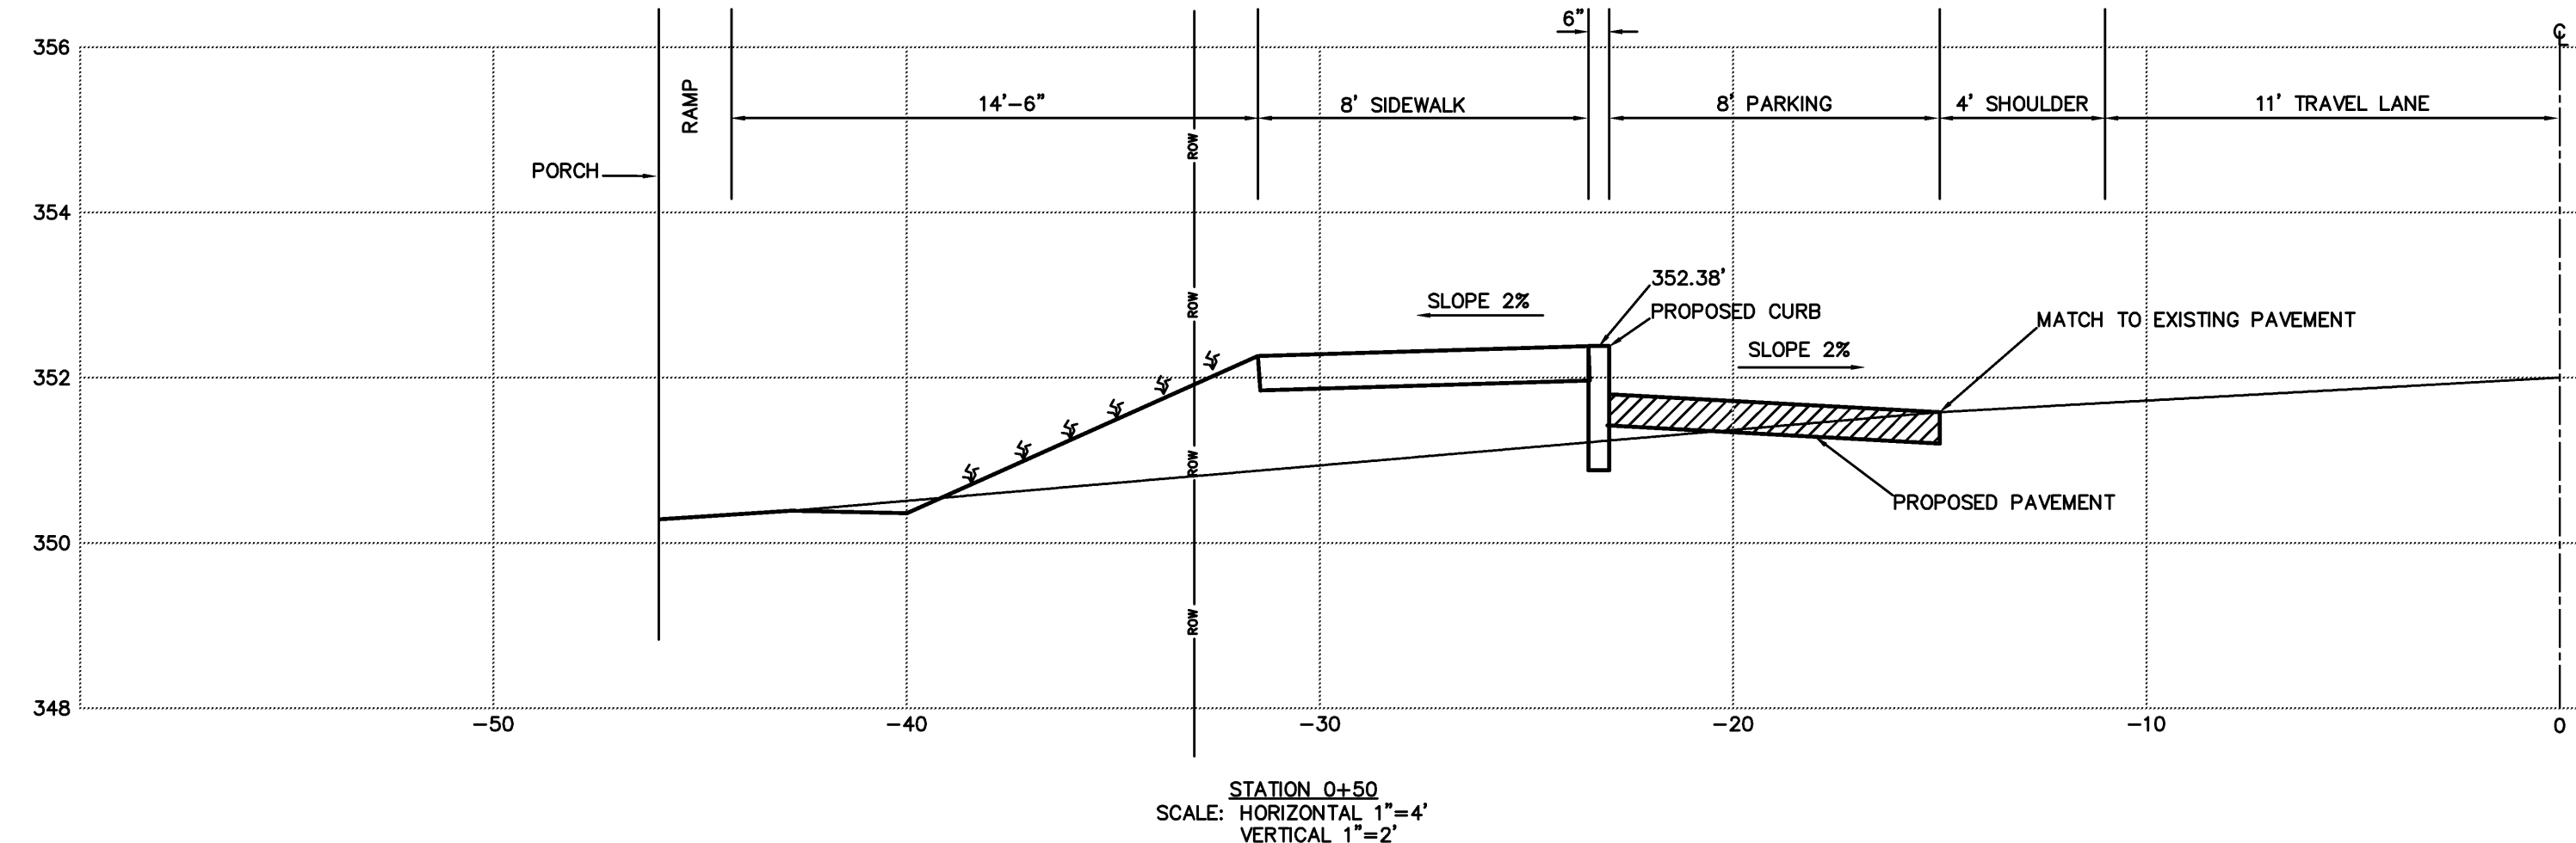


C:\Users\j\ESP\DRAWING\ENGINEERING\200\_1100\20051114\HINESBURG\_SPA.dwg 20051114.dwg Rev.dwg 1/26/2008 12:03:48 PM EST

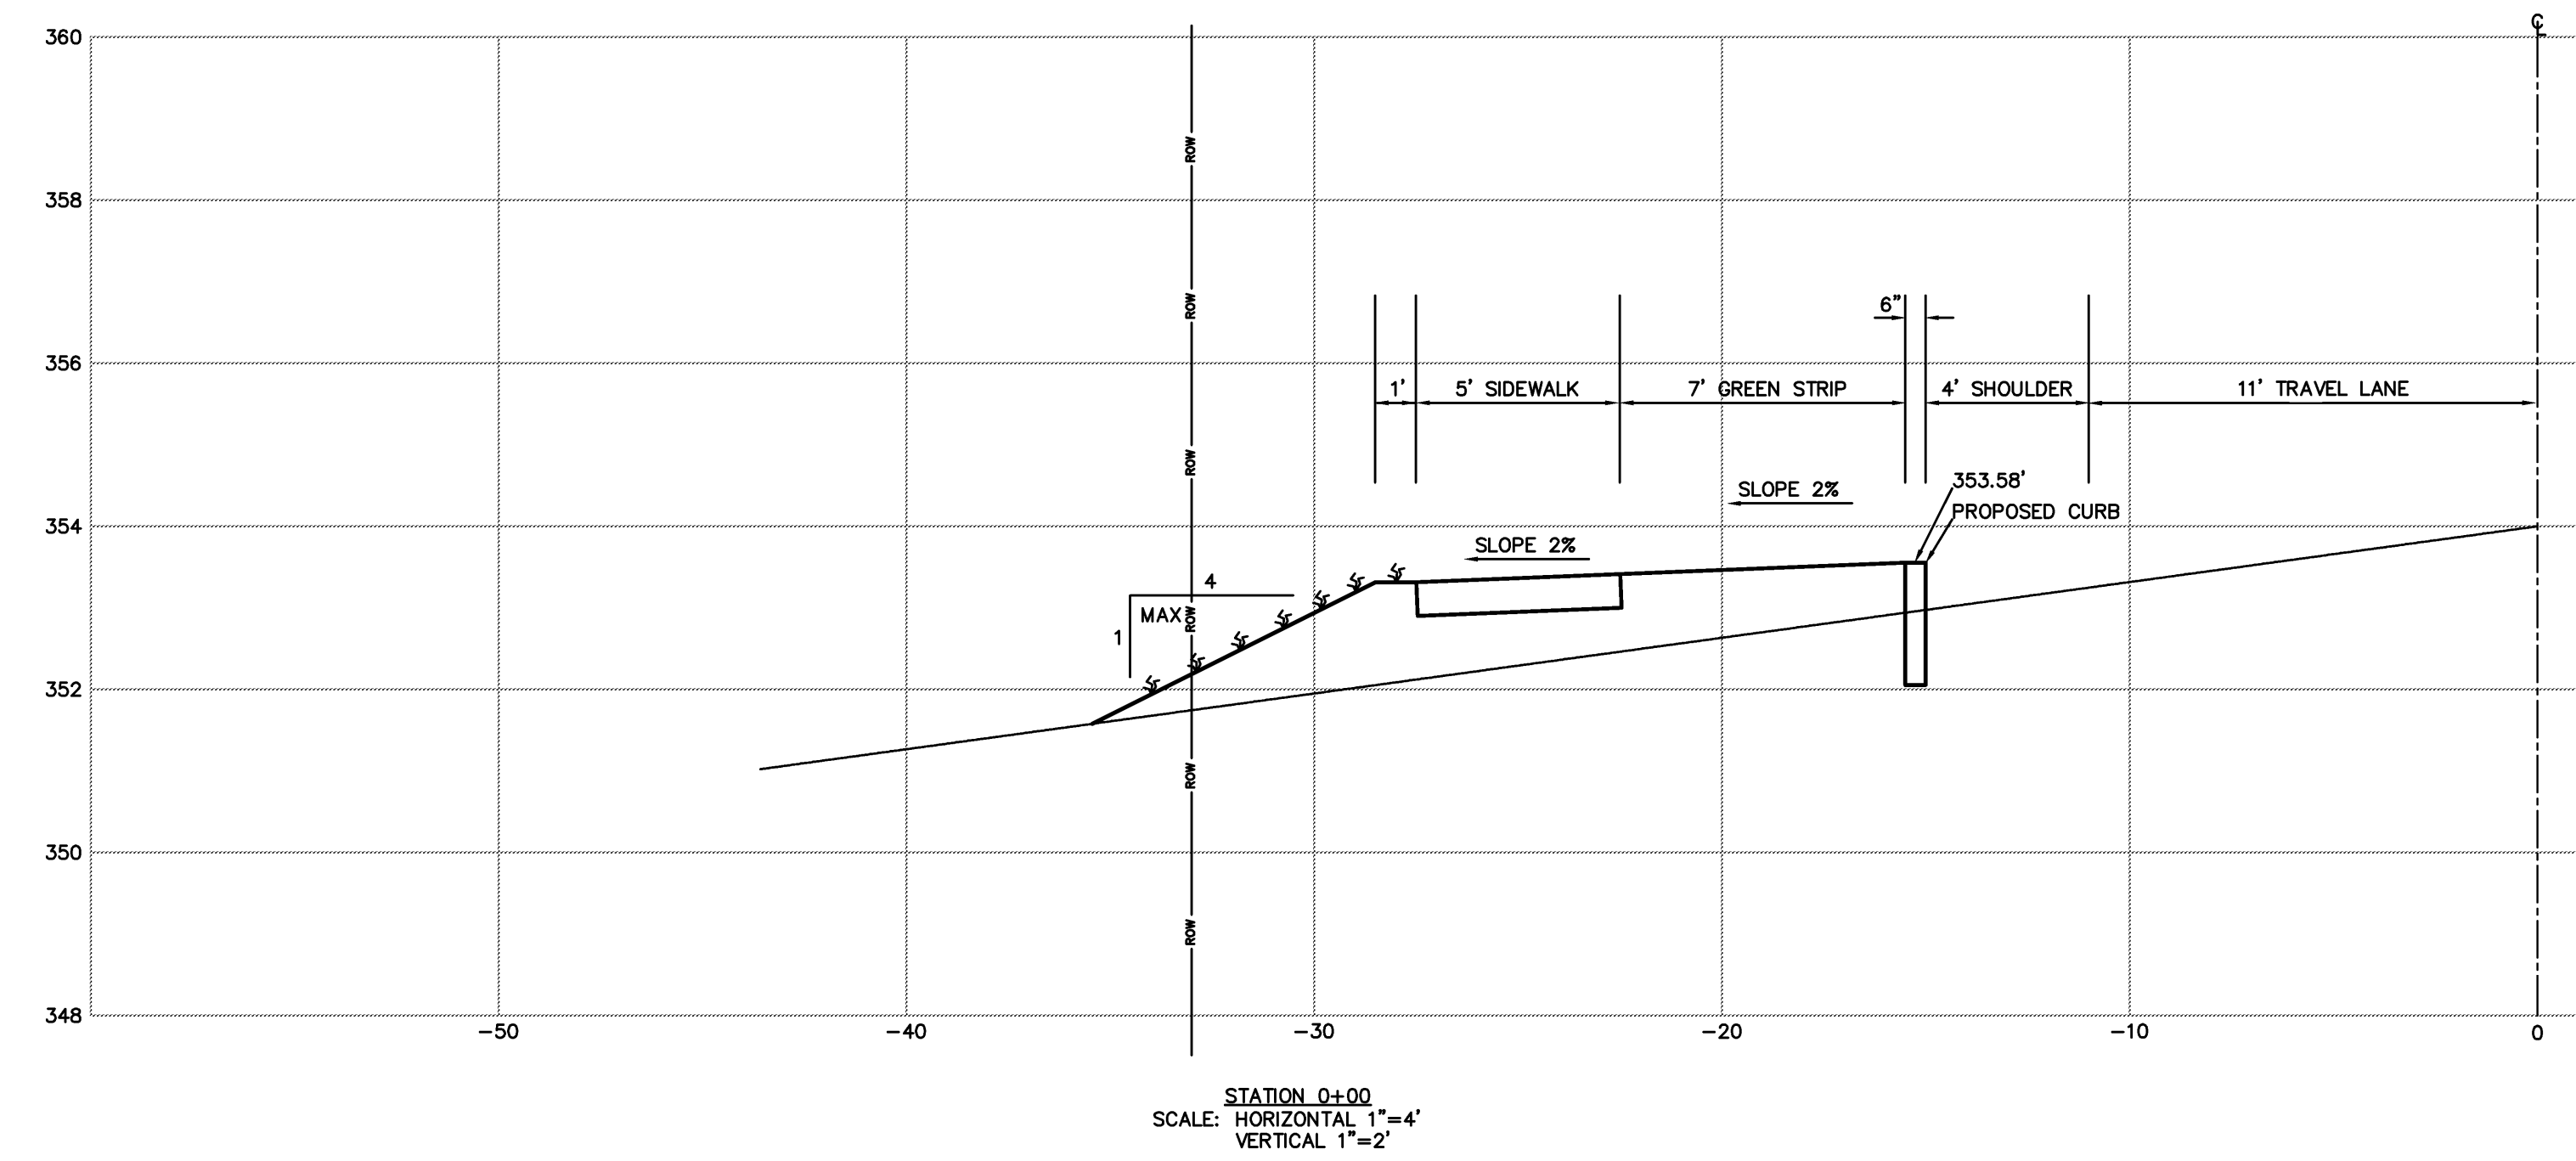

**RECORD DRAWINGS**  
DISCLAIMER: THESE RECORD DRAWINGS WERE PREPARED FROM DATA PROVIDED BY THE CONTRACTOR AND/OR OWNERS REPRESENTATIVE AND FROM SITE INSPECTIONS CONDUCTED BY ESPC FOLLOWING CONSTRUCTION. THE ENGINEER ASSUMES NO RESPONSIBILITY REGARDING THE ACCURACY OF THE INFORMATION PROVIDED ON THE PLANS OR THE LOCATIONS OF NEW CONSTRUCTION FEATURES DEPICTED ON THE PLANS.

**FINAL PLANS FOR CONSTRUCTION**

REVISIONS	BY
1-include comments from Amy Biss	02-23-07 LMM
2-REMOVE THE PEDESTRIAN BENCH	09-07-07 LMM
3-DEDICATED SIDEWALK AROUND UTILITY POLES	07-18-07 LMM

**ESPC**  
CIVIL AND ENVIRONMENTAL ENGINEERING  
P.O. BOX 212, WILLISTON, VT, 05495  
WWW.ESPC-CONSULTING.COM  
TEL: 802-382-0486

HINESBURG STP EH05(22)  
VILLAGE STREETScape IMPROVEMENTS  
ROUTE 116  
HINESBURG, VERMONT

DRAWN DM
CHECKED ES
DATE 01/15/07
SCALE AS NOTED
JOB NO. 20051114
SHEET

**CS-1**