




MAINLINE TIE DATA

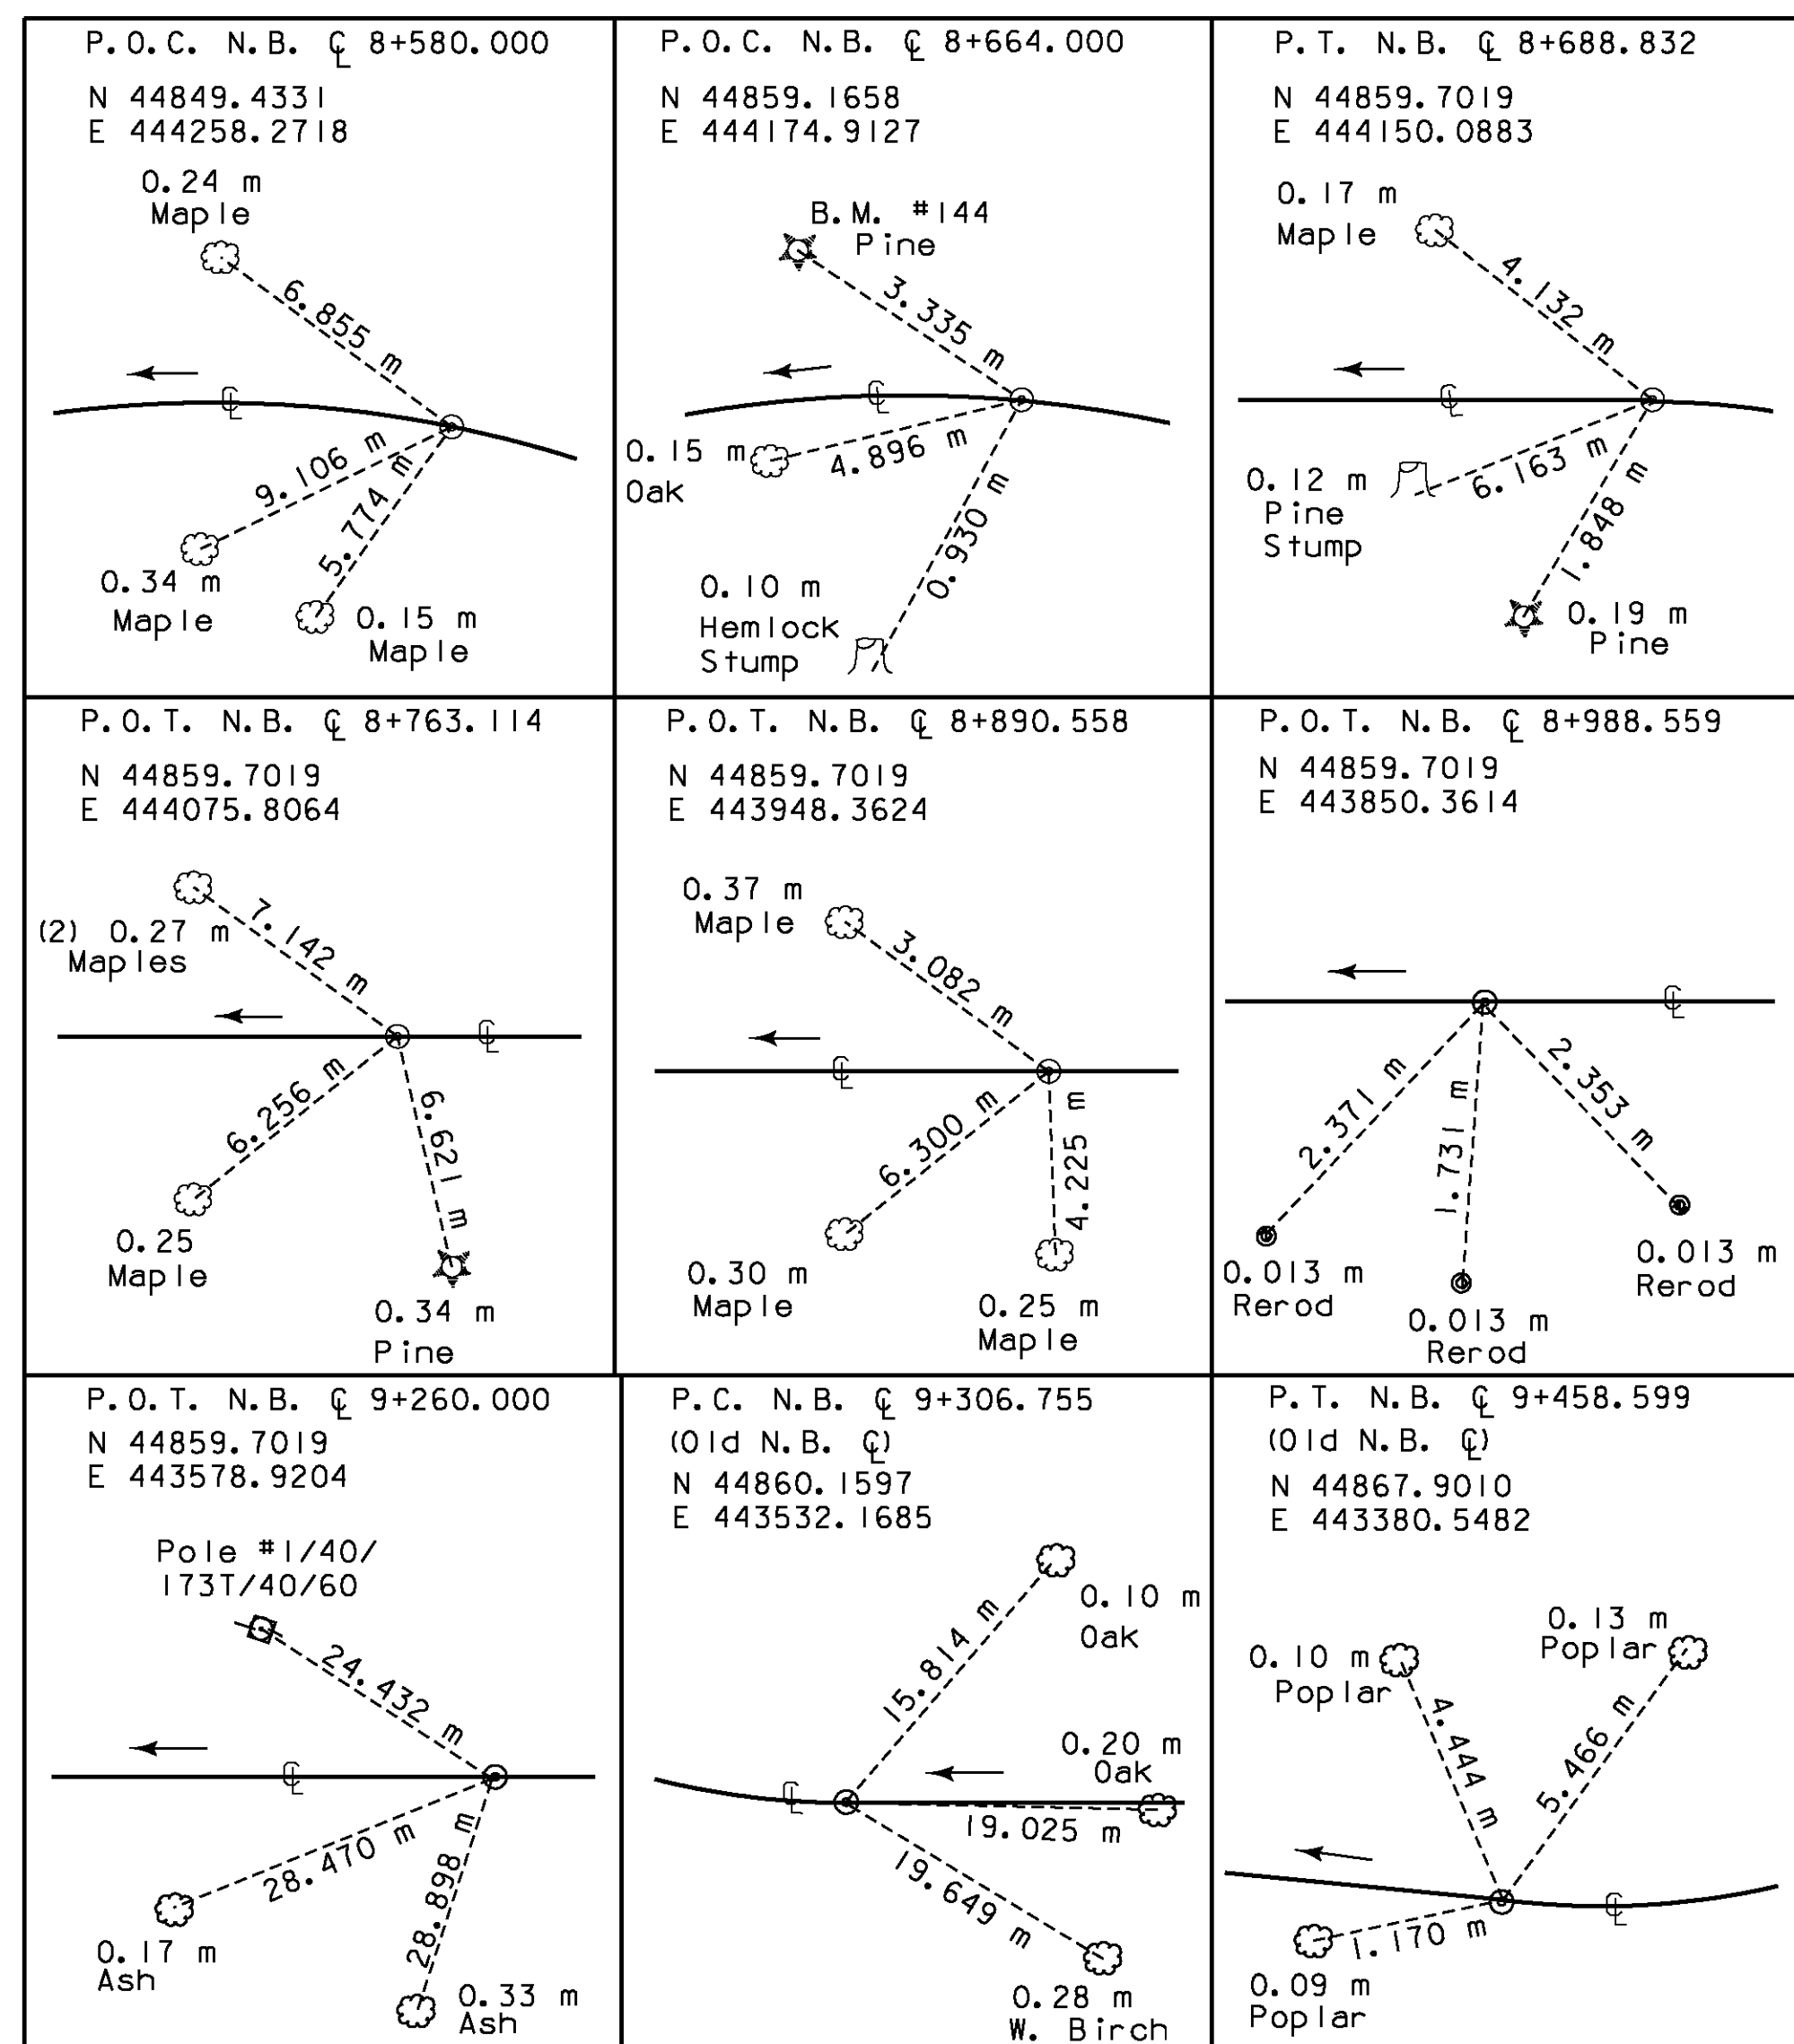


G.P.S. TIE DATA

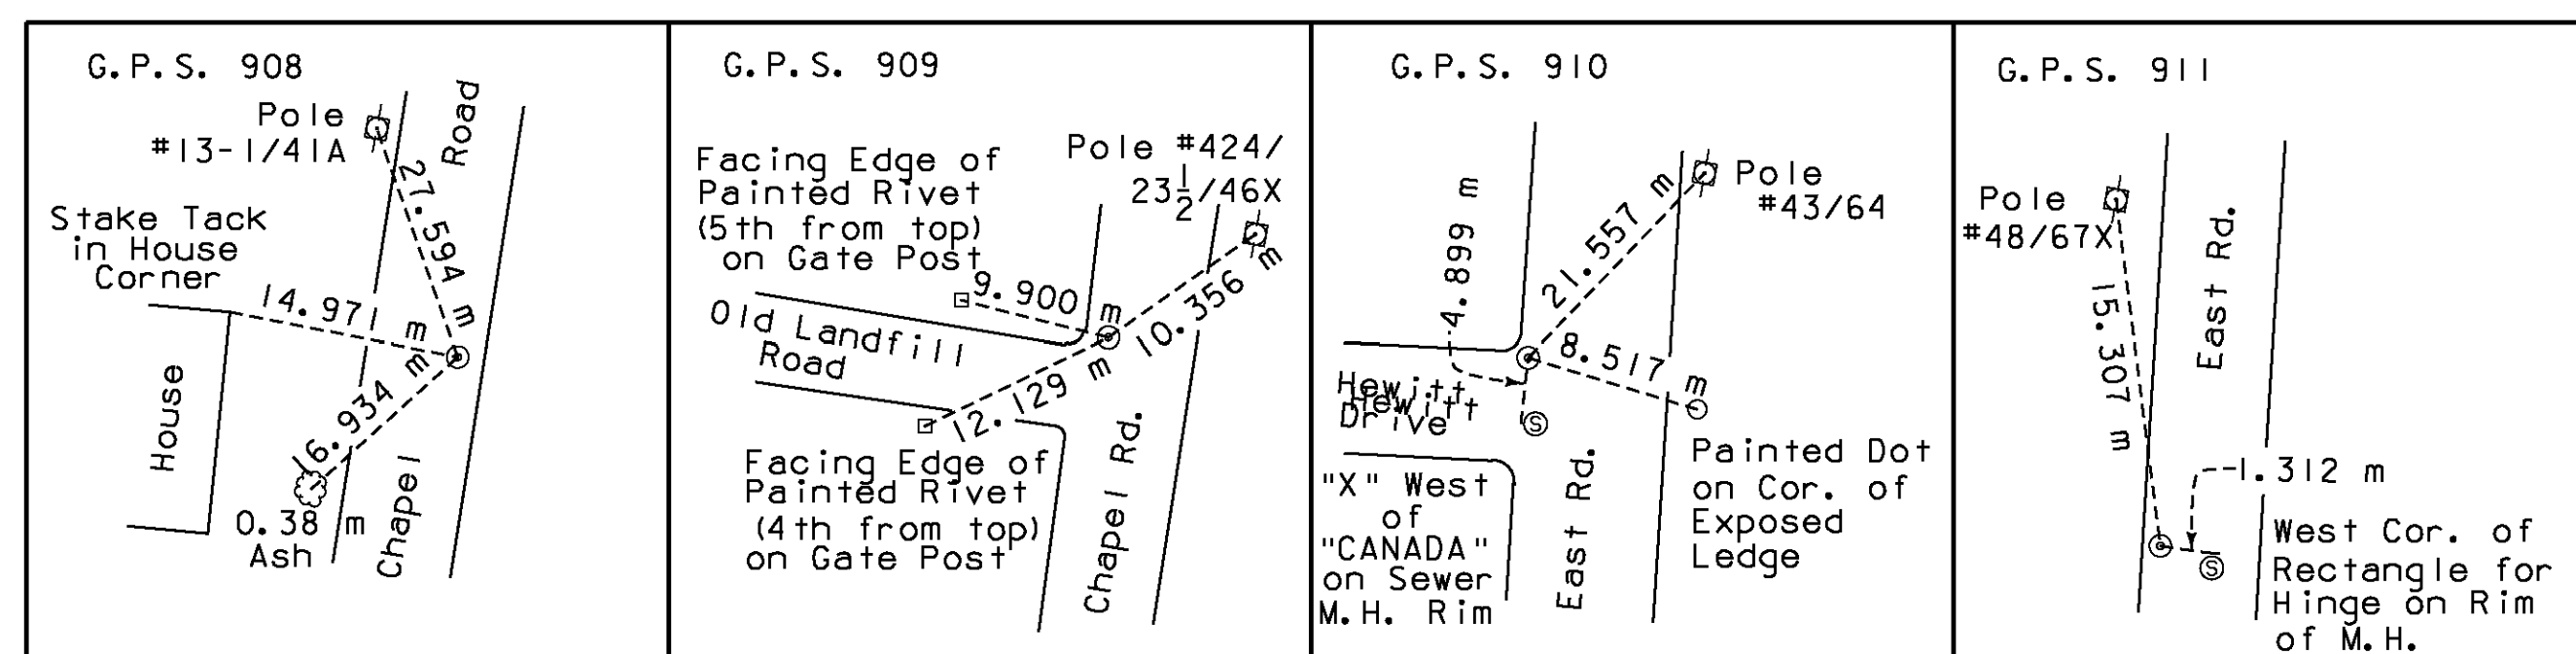

EAST ROAD TIE DATA

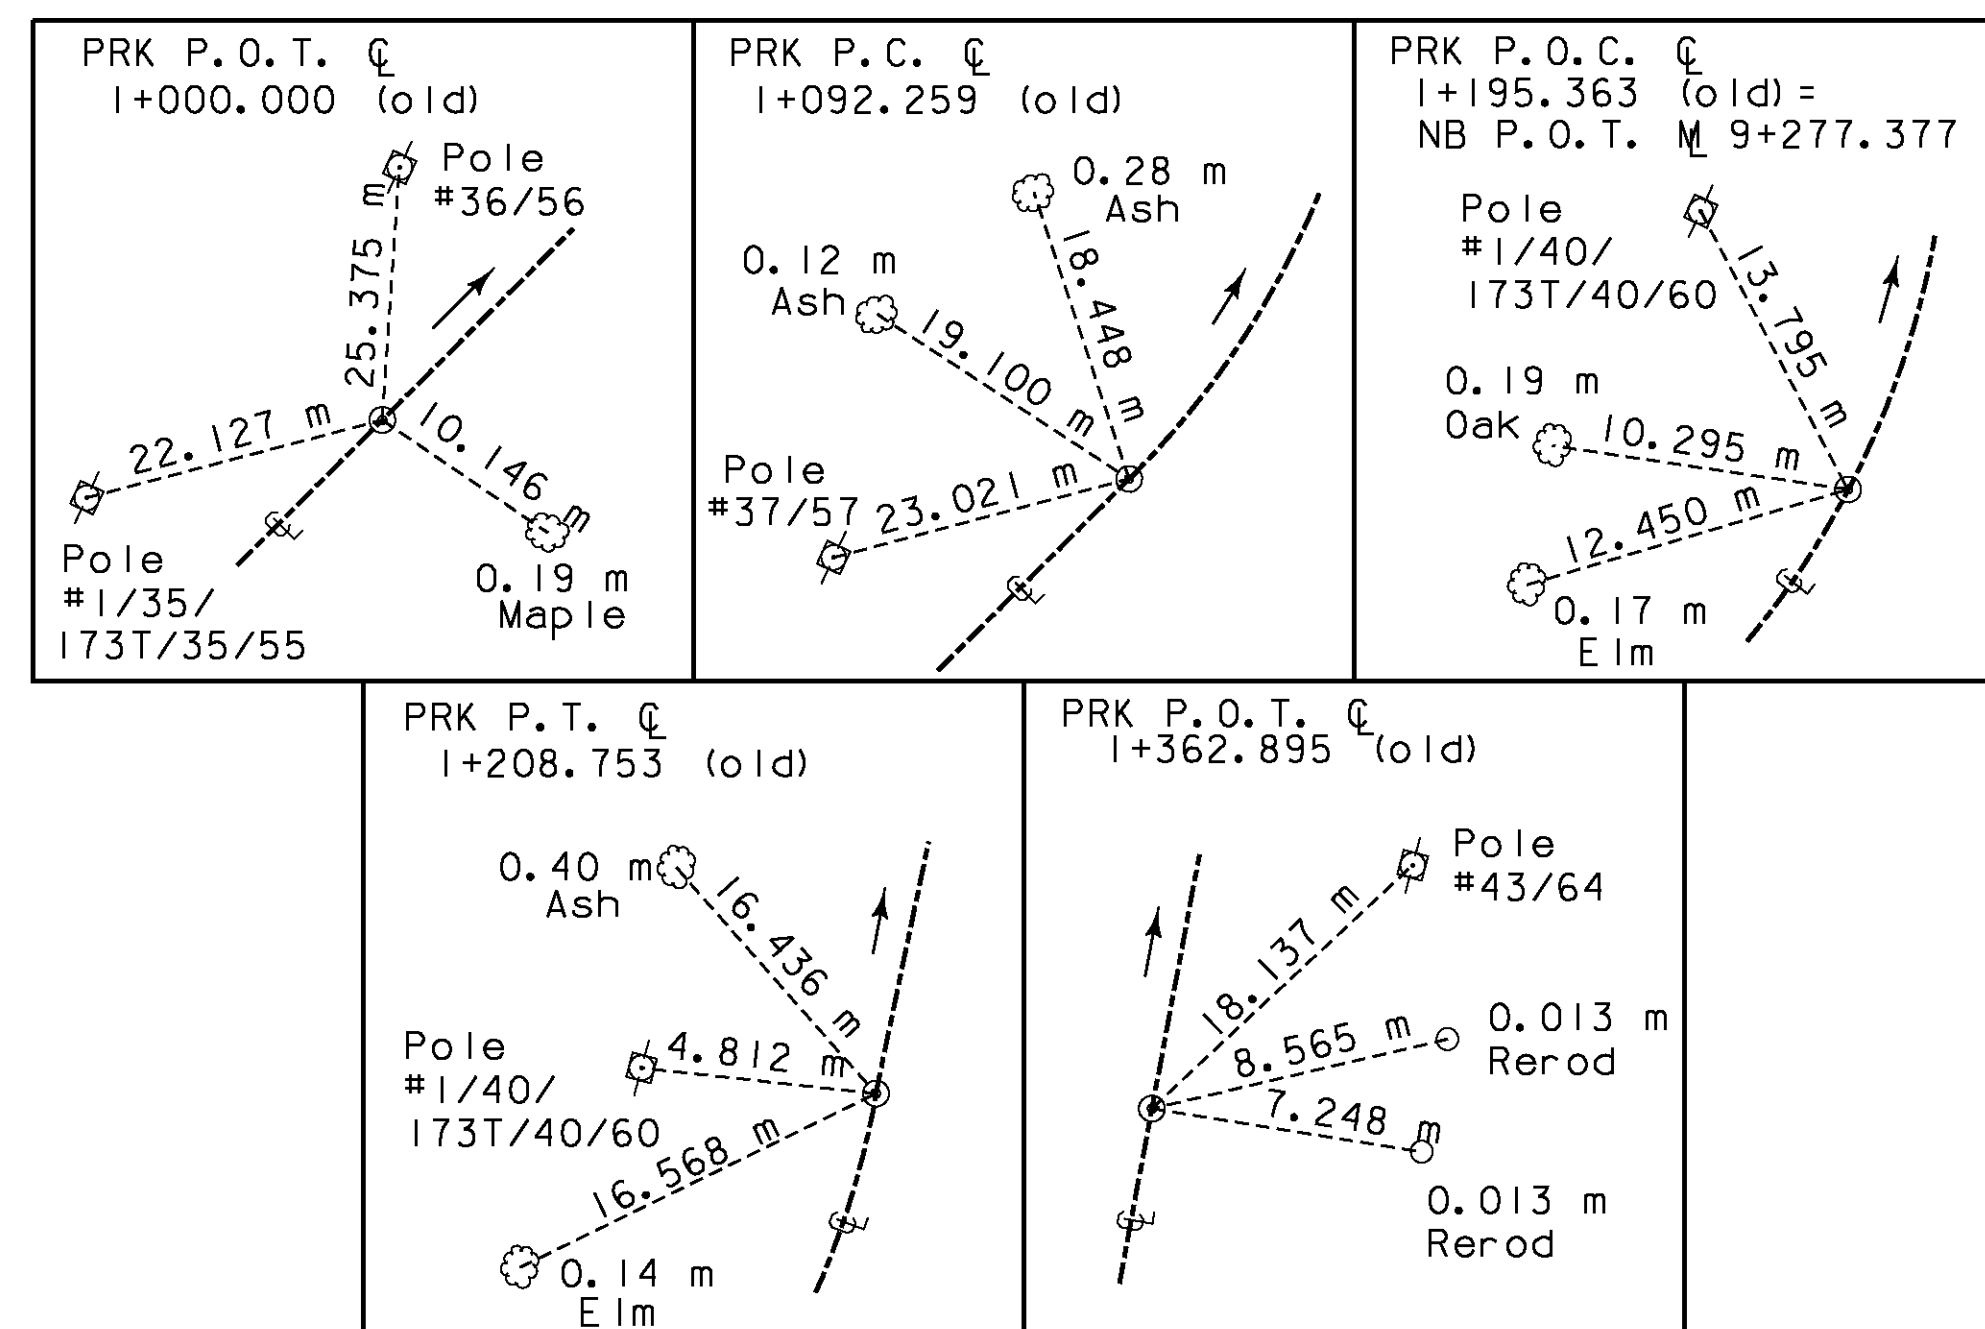


NORTH IS COMMON TO ALL INSERTS

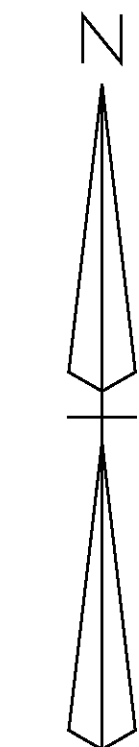

VT. STATE PLANE GRID

CHAPEL ROAD TIE DATA

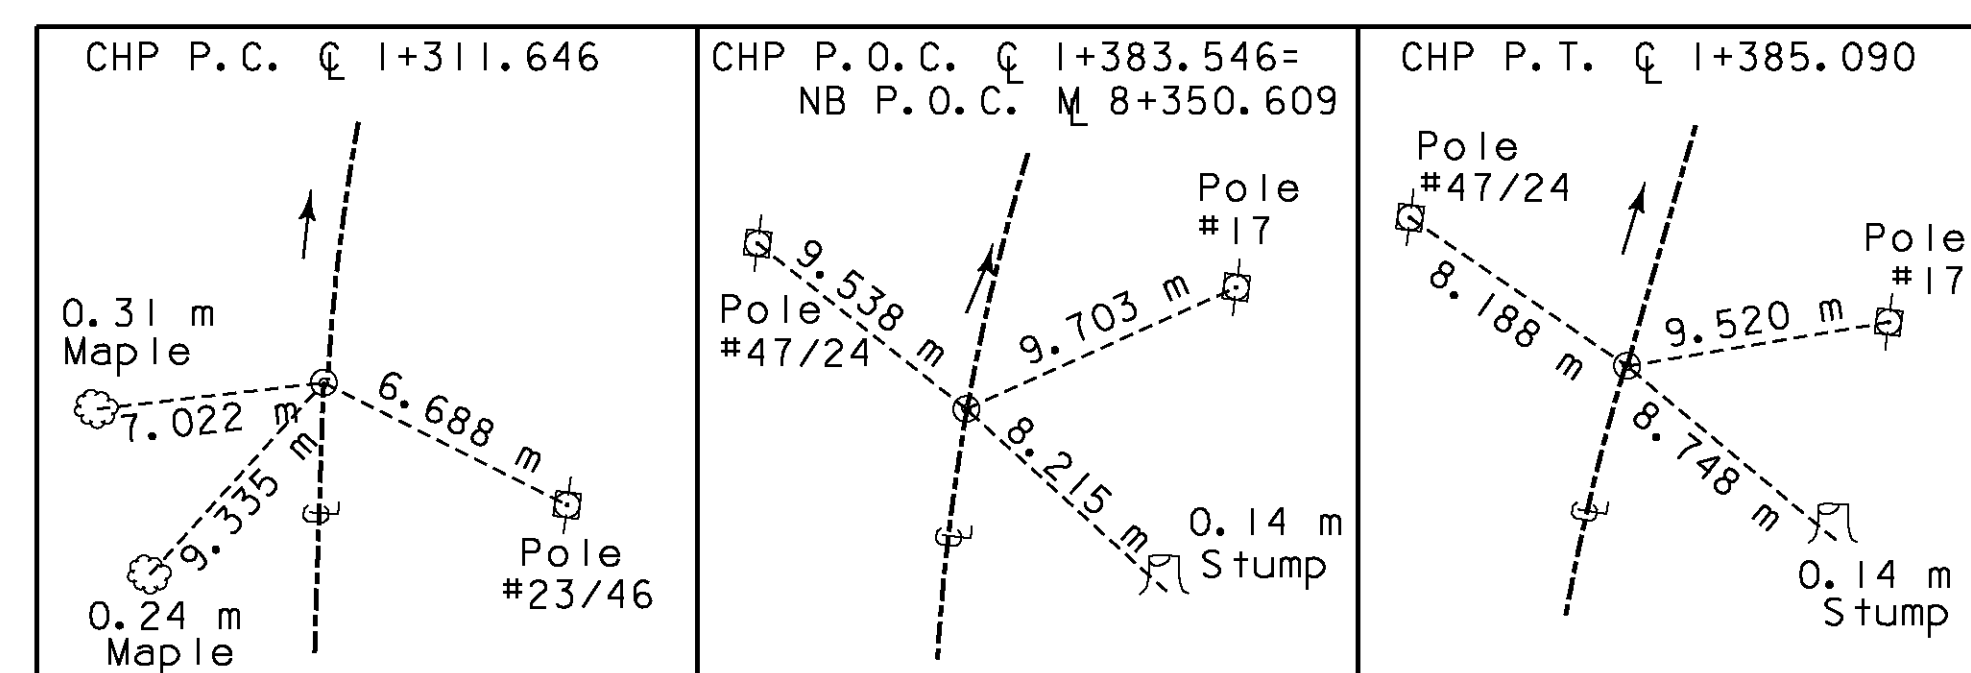

VERMONT AGENCY OF TRANSPORTATION



Stantec

PROJECT NAME: BENNINGTON
PROJECT NUMBER: AC NH 019-(153)

FILE NAME: ...\\plot_files\zd307c3tie.ptf PLOT DATE: 5/16/2011
DESIGN SUPERVISOR: GREG EDWARDS DRAWN BY: STANTEC
DESIGNED BY: MARC FOISY CHECKED BY: GARY SANTY
CONTROL TIE SHEET CT-1 SHEET II OF 577