


| CURVE CHI | CURVE NB7 |
|--------------------------------|--------------------------------|
| $\Delta = 13^\circ 20' 29.3''$ | $\Delta = 90^\circ 45' 02.2''$ |
| $R = 315.411m$ | $R = 575.000m$ |
| $T = 36.889m$ | $T = 582.583m$ |
| $L = 73.444m$ | $L = 910.741m$ |
| $E = 2.150m$ | $E = 243.552m$ |
| $BANK = 0.044$ | $BANK = 0.078$ |
| PI STA. CH 1+348.535 | PI STA. NB8+360.674 |
| N = 44729.2251 | N = 44859.7020 |
| E = 44458.9346 | E = 444732.6710 |
| PC N = 44692.4025 | PC N = 44277.1693 |
| E = 44456.7224 | E = 444725.0391 |
| PT N = 44764.5435 | PT N = 44859.7019 |
| E = 44469.5841 | E = 444150.0883 |

| CURVE SB7 | CURVE QRI |
|-------------------------------|--------------------------------|
| $\Delta = 90^\circ 45' 0.1''$ | $\Delta = 57^\circ 51' 50.8''$ |
| $R = 547.500m$ | $R = 603.300m$ |
| $T = 554.714m$ | $T = 333.480m$ |
| $L = 867.178m$ | $L = 609.284m$ |
| $E = 231.900m$ | $E = 86.033m$ |
| $BANK = N/A$ | $BANK = N/A$ |
| PI STA. SB8+320.410 | PI STA. QRI+520.333 |
| N = 44832.2019 | N = 44610.2574 |
| E = 444704.8017 | E = 444757.7022 |
| PC N = 44277.5357 | PC N = 44276.8060 |
| E = 444697.5410 | E = 444753.3381 |
| PT N = 44832.2019 | PT N = 44791.3254 |
| E = 444150.0879 | E = 444477.6607 |

DRIVE GATE FOR CHAIN LINK FENCE (TYPE L1)
 STA. CH 1+412.3, RT. (QUARRY ACCESS ROAD)
 STA. CH 1+320.4, LT.


CONSTRUCT DRIVE
 STA. CH 1+261.6, LT. (7.2 m GRAVEL)
 STA. CH 1+320.4, LT. (3.6 m GRAVEL)
 STA. CH 1+430.6, RT. (4.5 m GRAVEL)

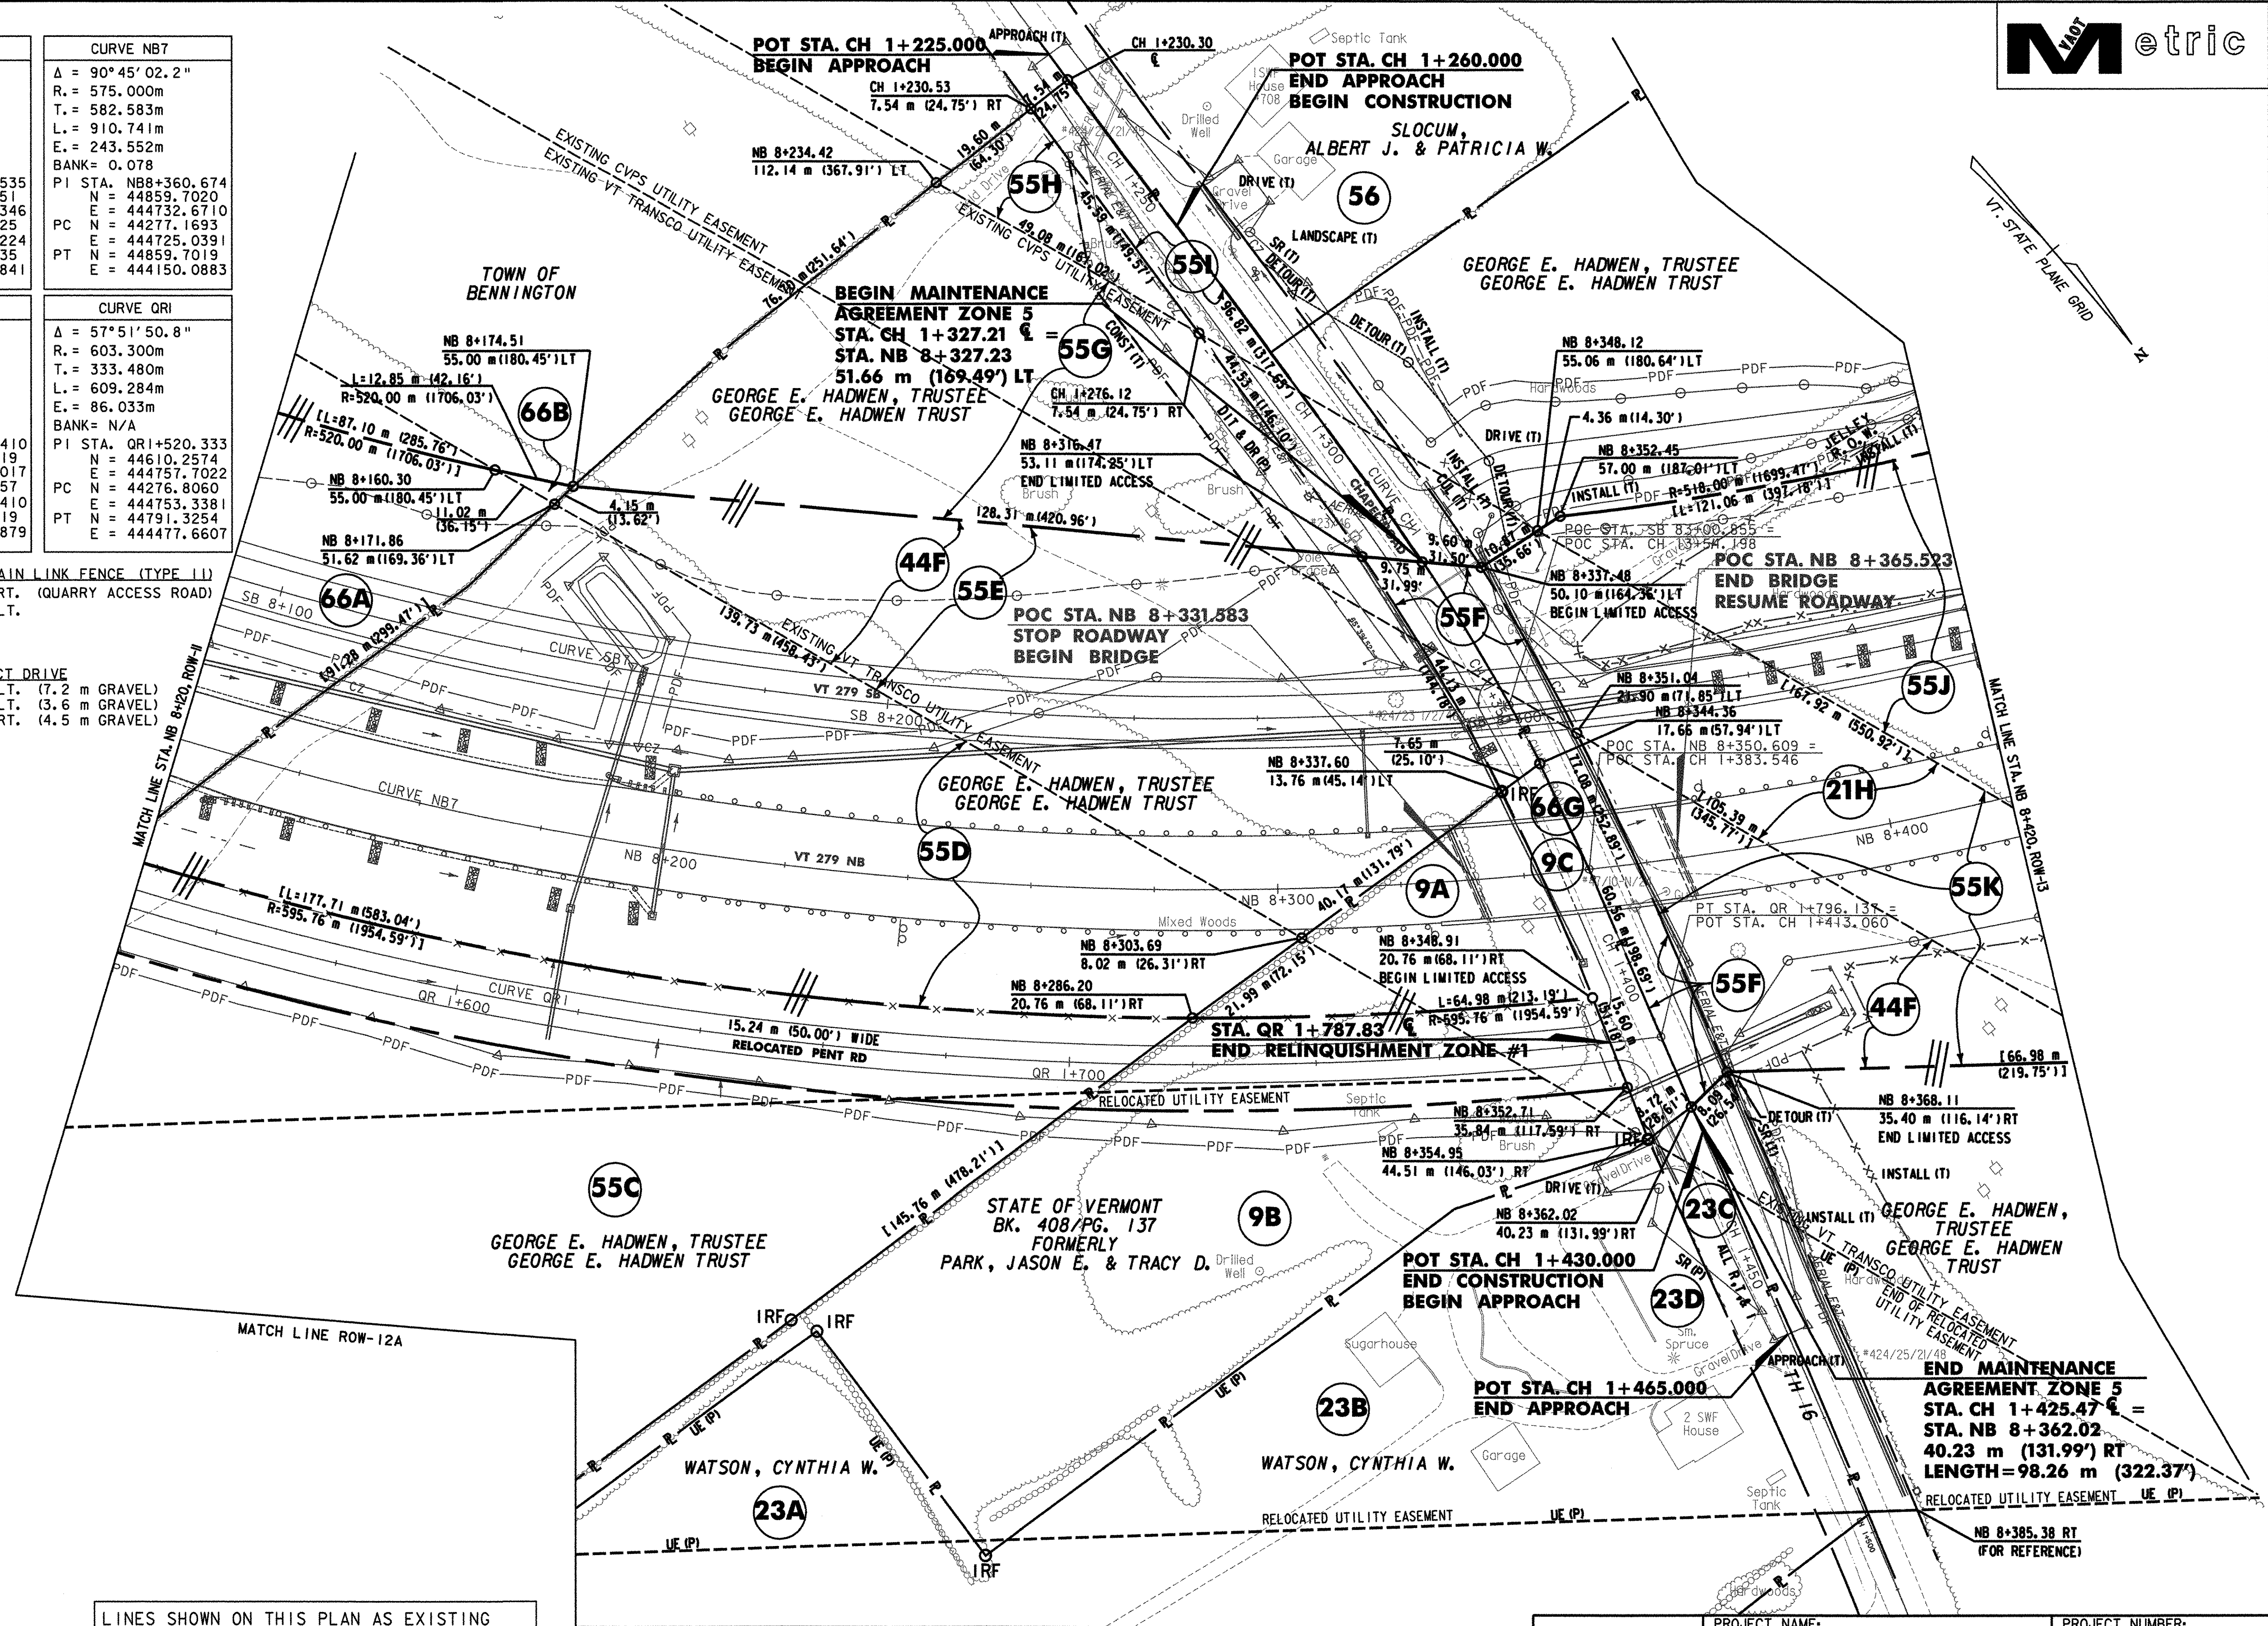

LINES SHOWN ON THIS PLAN AS EXISTING PROPERTY LINES P/L ARE BELIEVED TO BE ACCURATE BUT SHOULD NOT BE RELIED UPON FOR PURPOSES UNRELATED TO THE STATE OF VERMONT'S ACQUISITION OF LAND AND RIGHTS FOR THIS PROJECT.

THIS SHEET TO BE USED FOR RIGHT-OF-WAY INFORMATION ONLY

DATUM
 VERTICAL NAVD 88
 HORIZONTAL NAD 83 (1992)

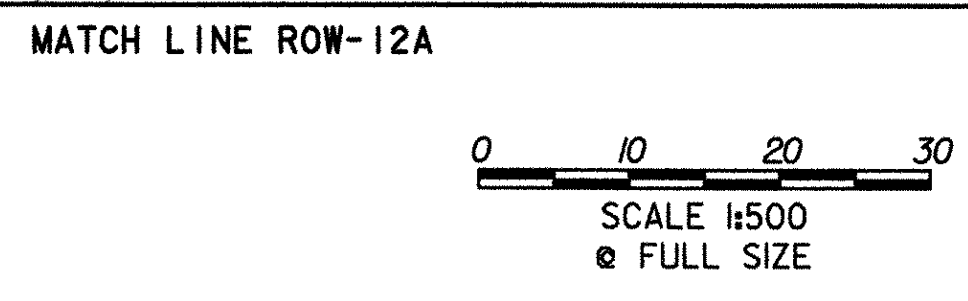

R.O.W. PLAN
ROW-12

| | |
|--|------------------------------------|
| PROJECT NAME: BENNINGTON | PROJECT NUMBER: AC NH 019-(K53) |
| DESIGN FILE NAME: c:\dh\bennington\row | PLOT DATE: 05-21-07 |
| PROJECT LEADER: JDP | DRAWN BY: MBB |
| | CHECKED BY: GAK |
| | SHEET: 32 OF 577 |